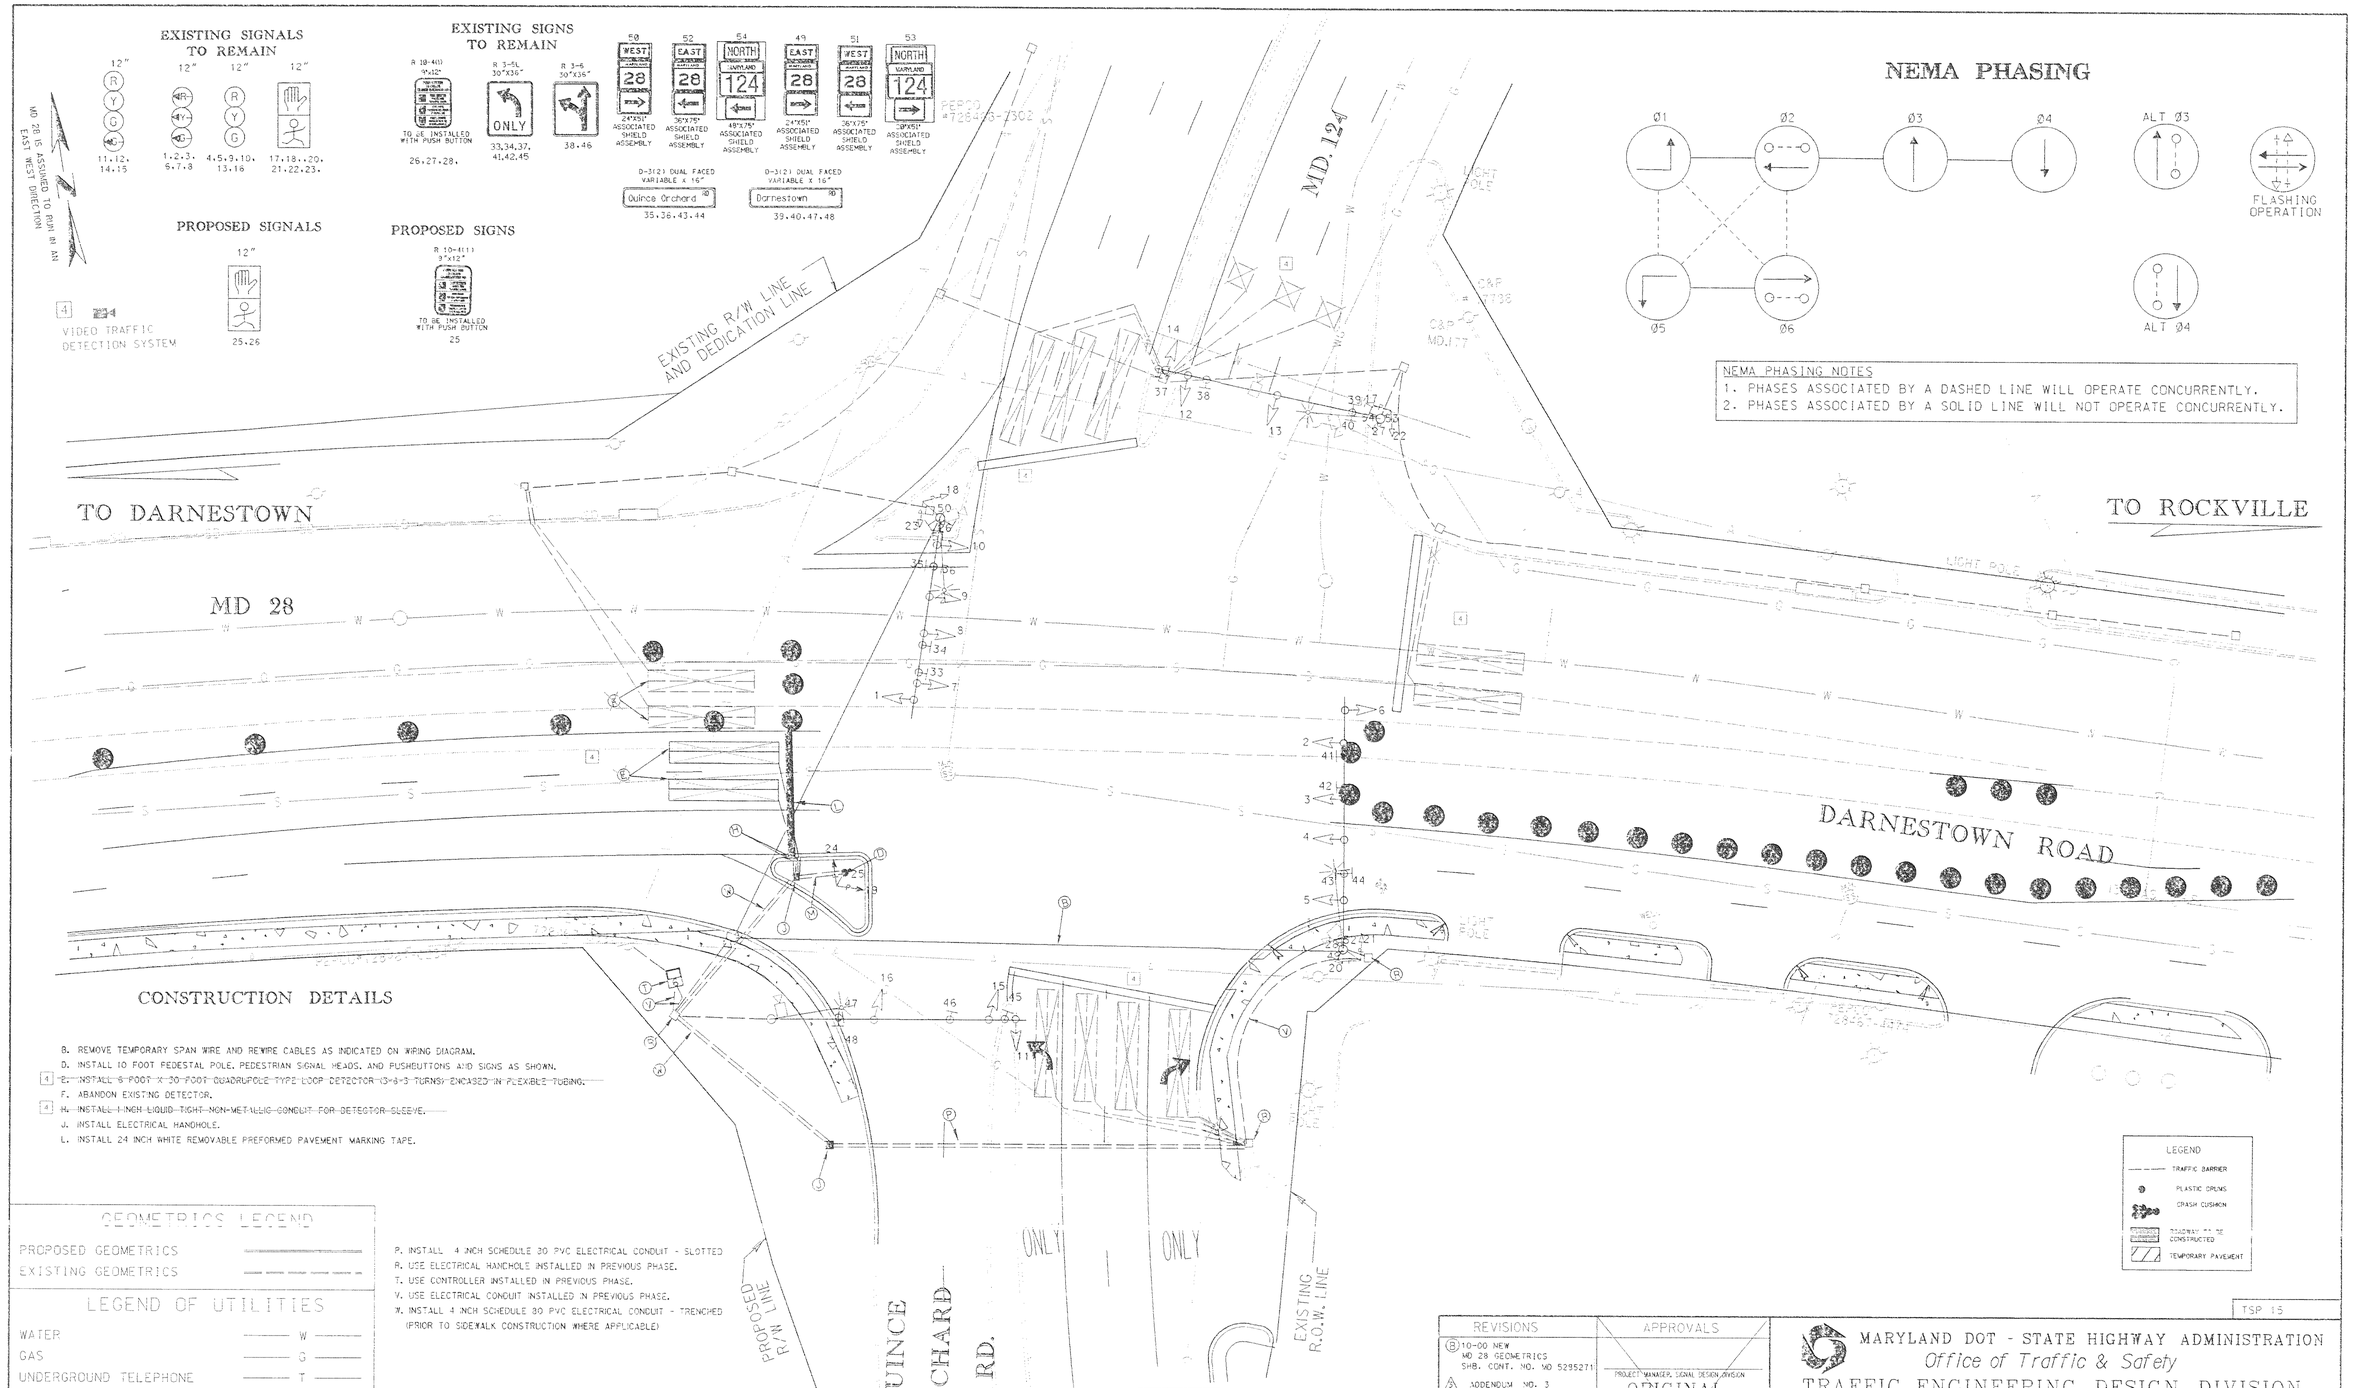

8/22/01 5:18:22 PM G:\PLOTTING\PS7\OCF\MYLAR_HP.get McGendy Pierre Division: Transportation m:\1997\0197029 md28\QUINCE\SP01-20R.PRF