2/4/02 10:32:07 AM G:\PLOTTING\PS7\OCP\MYLAR_HP\pet Mosendy Pierre Division:Transportation m:\1997\0197029\MD28\MUDDYBR\spo1_1.prt

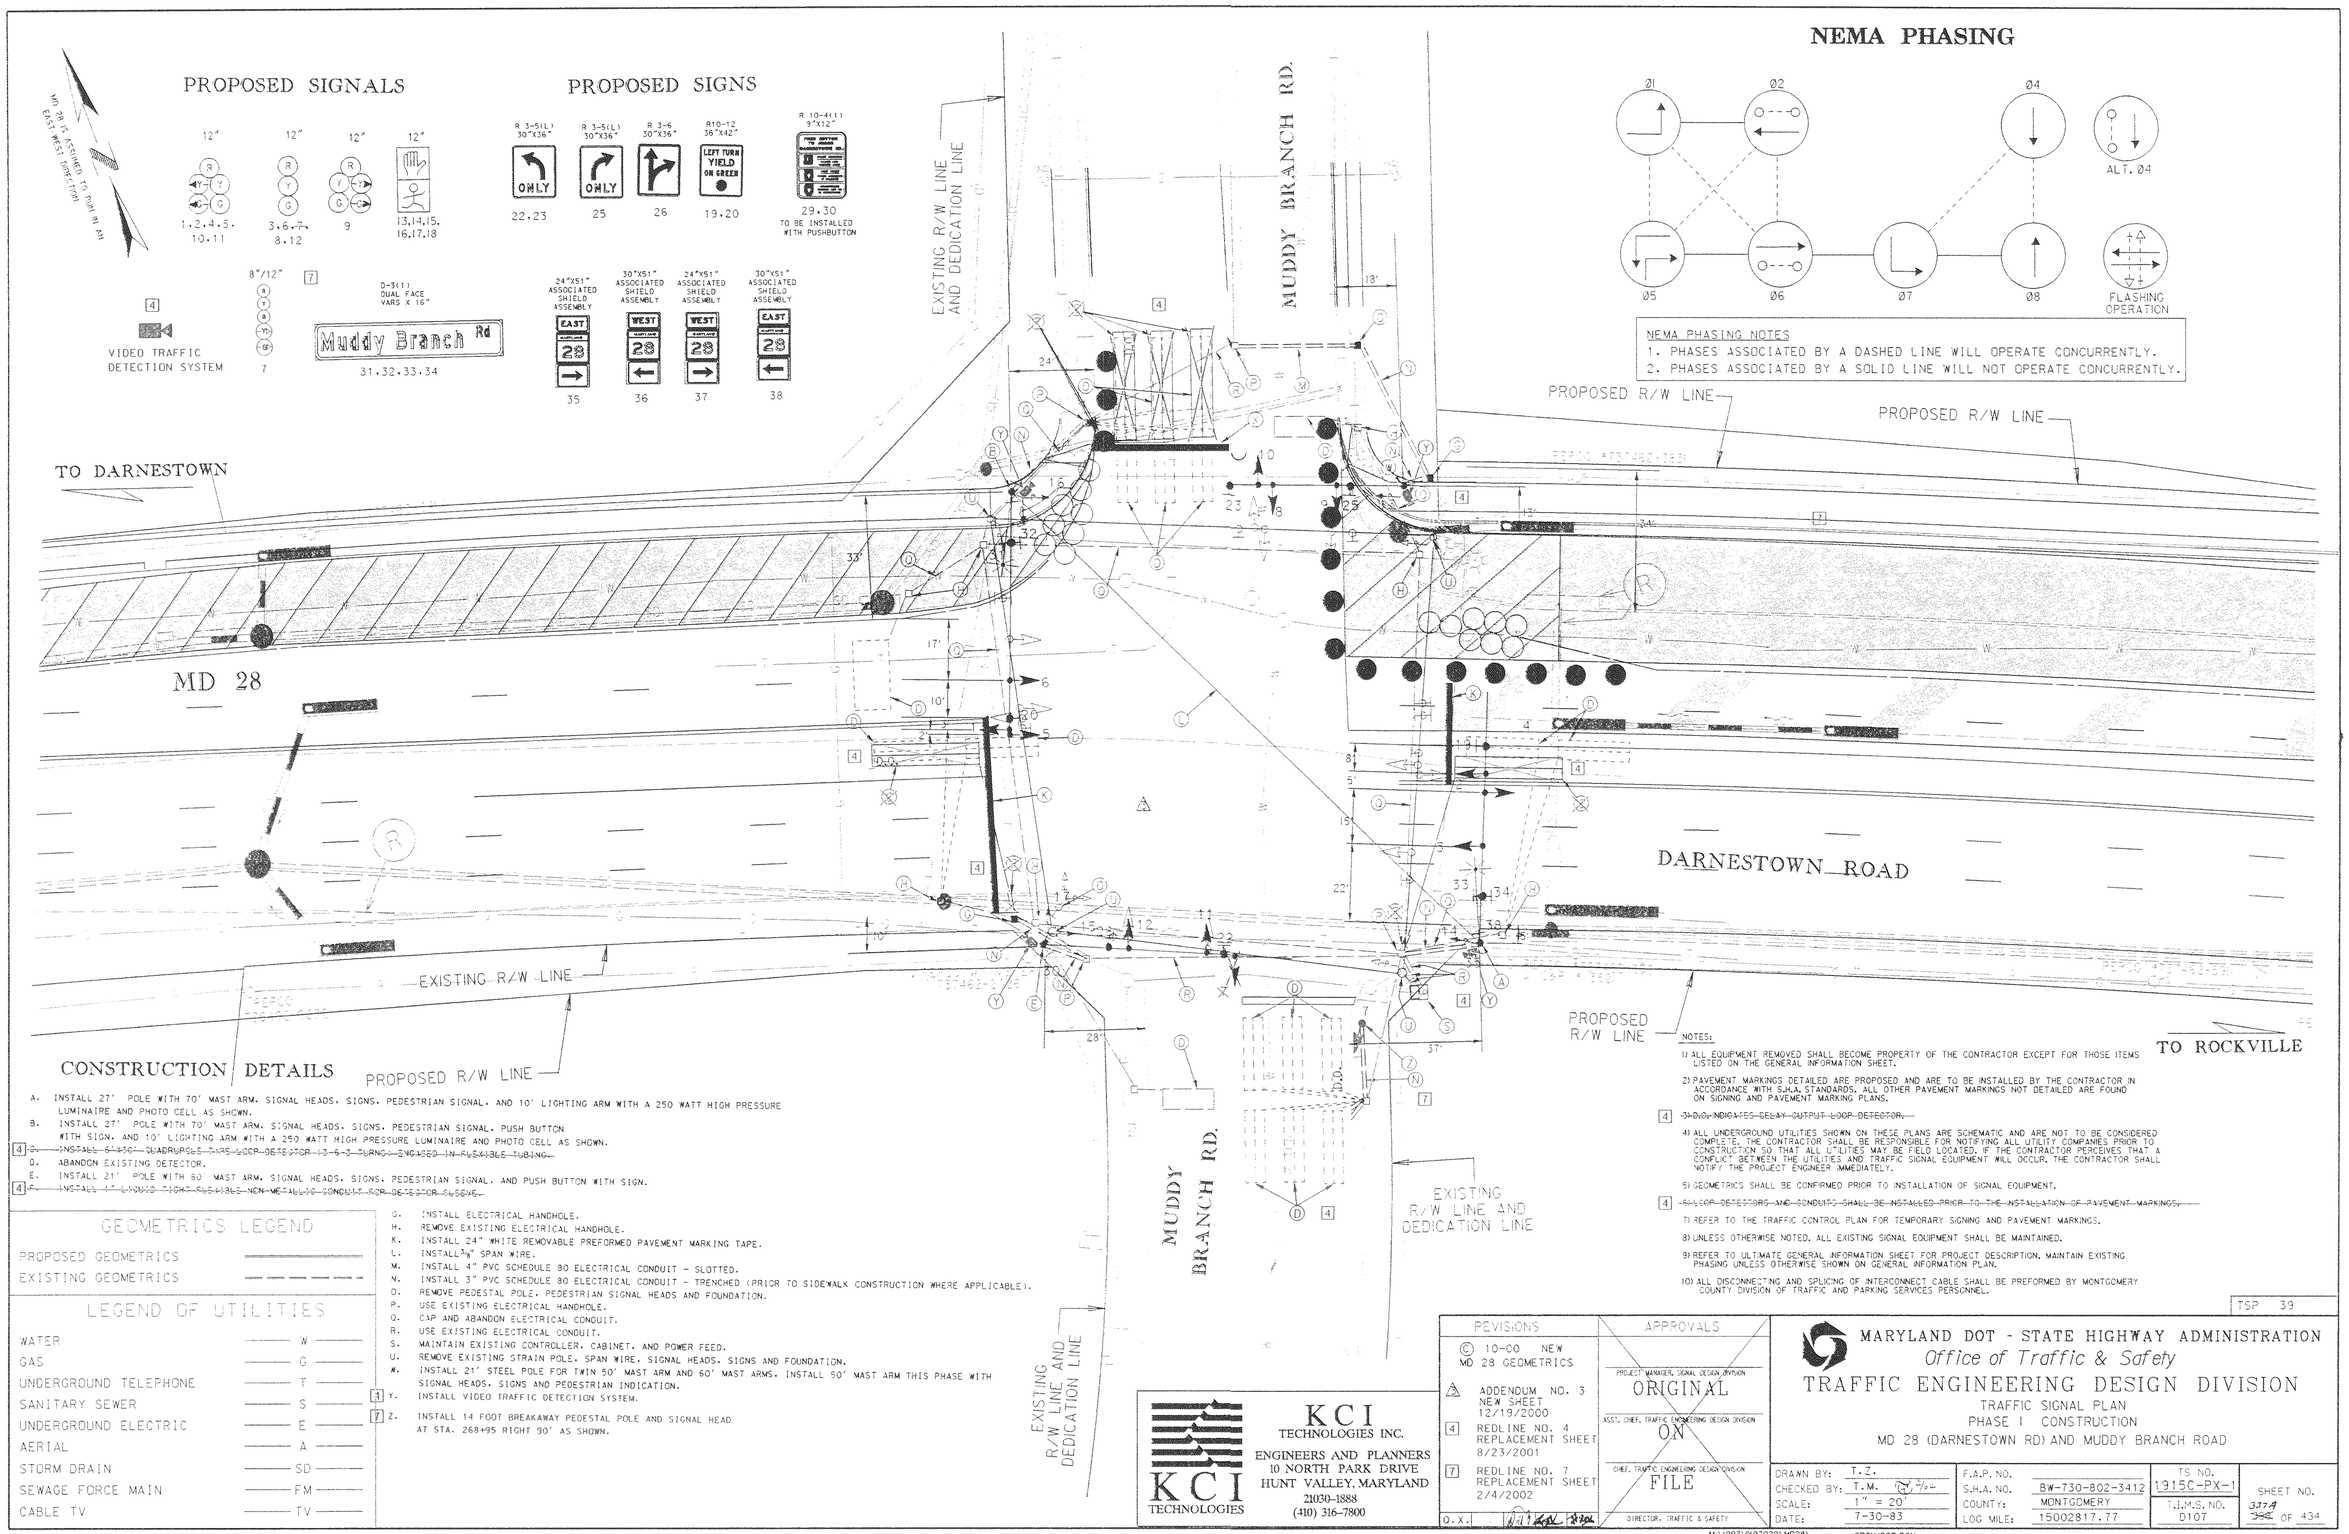

2/4/02 10:32:07 AM G:\PLOTTING\PS7\OCP\MYLAR_HP\pet Mosendy Pierre Division:Transportation m:\1997\0197029\MD28\MUDDYBR\spo1_1.prt