EQUIPMENT LIST 'B'

EQUIPMENT TO BE FURNISHED AND/OR INSTALLED BY THE CONTRACTOR.

QUANTITY	UNIT	SPECIFICATION SECTION	DESCRIPTION
~~[2] 30~~	~~LF~~	~~805~~	~~FURNISH AND INSTALL 1" LIQUID TIGHT FLEXIBLE NON-METALLIC CONDUIT FOR DETECTOR SLEEVE~~
40	LF	805	FURNISH AND INSTALL 1" ELECTRICAL CONDUIT - GALVANIZED SLEEVE
~~[4] 900~~	~~LF~~	~~819~~	~~FURNISH AND INSTALL ELECTRICAL CABLE 2-CONDUCTOR (ALUMINUM SHIELDED)~~
100	LF	556	FURNISH AND INSTALL 24 INCH WHITE REMOVABLE PREFORMED PAVEMENT MARKING TAPE.
6	EA	814	RELOCATE EXISTING TRAFFIC SIGNAL HEAD
~~[2] 2600~~	~~LF~~	~~810~~	~~FURNISH AND INSTALL LOOP WIRE ENCASED IN FLEXIBLE TUBING (NO 14 AWG)~~
~~[3] 655~~	~~LF~~	~~815~~	~~FURNISH AND INSTALL SAWCUT FOR SIGNAL (LOOP DETECTOR)~~
1	LS	SP	DELIVERY OF SALVAGED EQUIPMENT
1	LS	SP	REMOVE AND DISPOSE OF EXISTING EQUIPMENT
1	LS	SP	REMOVAL OF EXISTING SIGNAL EQUIPMENT TO BE SALVAGED
20	LF	805	FURNISH AND INSTALL 3 INCH SCHEDULE 80 RIGID PVC CONDUIT - TRENCHED
2	EA	SP	RELOCATE OVERHEAD SIGN

NOTE: ALL EQUIPMENT AND/OR MATERIALS TO BE REMOVED BY THE CONTRACTOR, BUT NOT LISTED BELOW, SHALL BECOME THE PROPERTY OF THE CONTRACTOR.

QUANTITY	UNIT	DESCRIPTION
1	EA	60 FOOT MAST ARM

TEMPORARY WIRING NOTES:

1) NEW AND RELOCATED SIGNAL HEADS SHALL BE WIRED WITH SUFFICIENT CABLE TO PROVIDE REALIGNMENT IN SUBSEQUENT CONSTRUCTION PHASES.

2) EXISTING WIRING FOR EQUIPMENT WHICH IS TO BE REMOVED OR ABANDONDED SHALL BE REMOVED AND DISPOSED.

3) EXISTING WIRING NOT DETAILED SHALL BE MAINTAINED UNLESS OTHERWISE NOTED.

~~PHASE 3 WIRING DIAGRAM~~

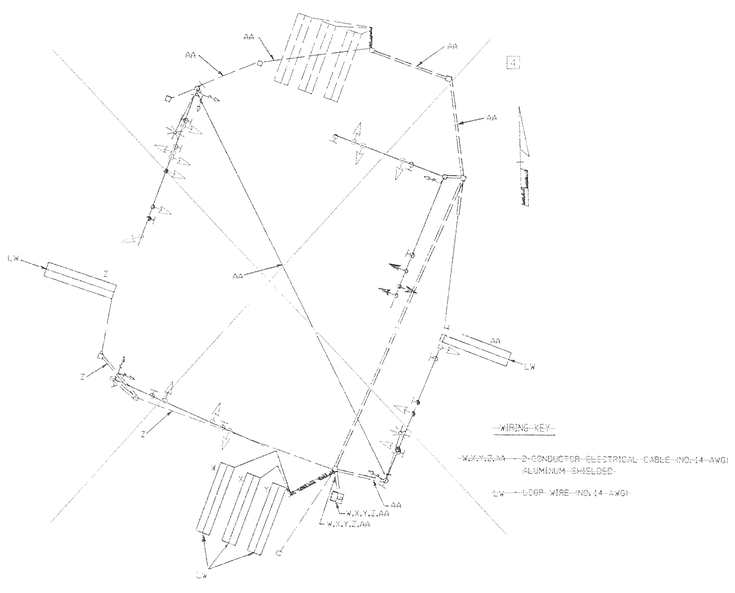

REVISION "C"

KCI TECHNOLOGIES

KCI TECHNOLOGIES INC.
ENGINEERS AND PLANNERS
10 NORTH PARK DRIVE
HUNT VALLEY, MARYLAND
21030-1888
(410) 316-7800

REVISIONS

(B) 3-94 MODIFY SIGNAL DUE TO NEW GEOMETRICS FOR EB MD 28	L.C.
(C) 10-00 NEW MD 28 GEOMETRICS	
Δ ADDENDUM NO. 3 NEW SHEET 12/19/2000	
[4] REDLINE NO. 4 REPLACEMENT SHEET 9/07/2001	
	Q.A.

APPROVALS

PROJECT MANAGER, SIGNAL DESIGN DIVISION
ORIGINAL
ASST. CHIEF, TRAFFIC ENGINEERING DESIGN DIVISION
ON
CHIEF, TRAFFIC ENGINEERING DESIGN DIVISION
FILE
DIRECTOR, TRAFFIC & SAFETY

TSP 44

MARYLAND DOT - STATE HIGHWAY ADMINISTRATION
Office of Traffic & Safety
TRAFFIC ENGINEERING DESIGN DIVISION
GENERAL INFORMATION SHEET
PHASE 3 CONSTRUCTION
MD 28 (DARNESTOWN RD) AND MUDDY BRANCH RD.

DRAWN BY: T.Z.	F.A.P. NO.		TS NO.	SHEET NO.
CHECKED BY: T.M.	S.H.A. NO.	BW-730-302-3412	1915C-GIX-3	997
SCALE: NONE	COUNTY:	MONTGOMERY	T.I.M.S. NO.	843 OF 434
DATE: 7-30-83	LOG MILE:	15002317.77	0107	

M:\997\0197029\M028\

9/22/01 5:54:26 PM G:\PLOTTING\PS7\OCT\MYLAR_HP get McSendy Pierre Division: Transportation m:\1997\0197029\md28\muddyBR\ej05bmt.PRF