K&E BALTIMORE 17 0153 PHOENIX 54090+

FED. ROAD DIV. NO.	STATE	FED. AID PROJ. NO.	SHEET NO.	TOTAL SHEETS
3	MD.		7	11

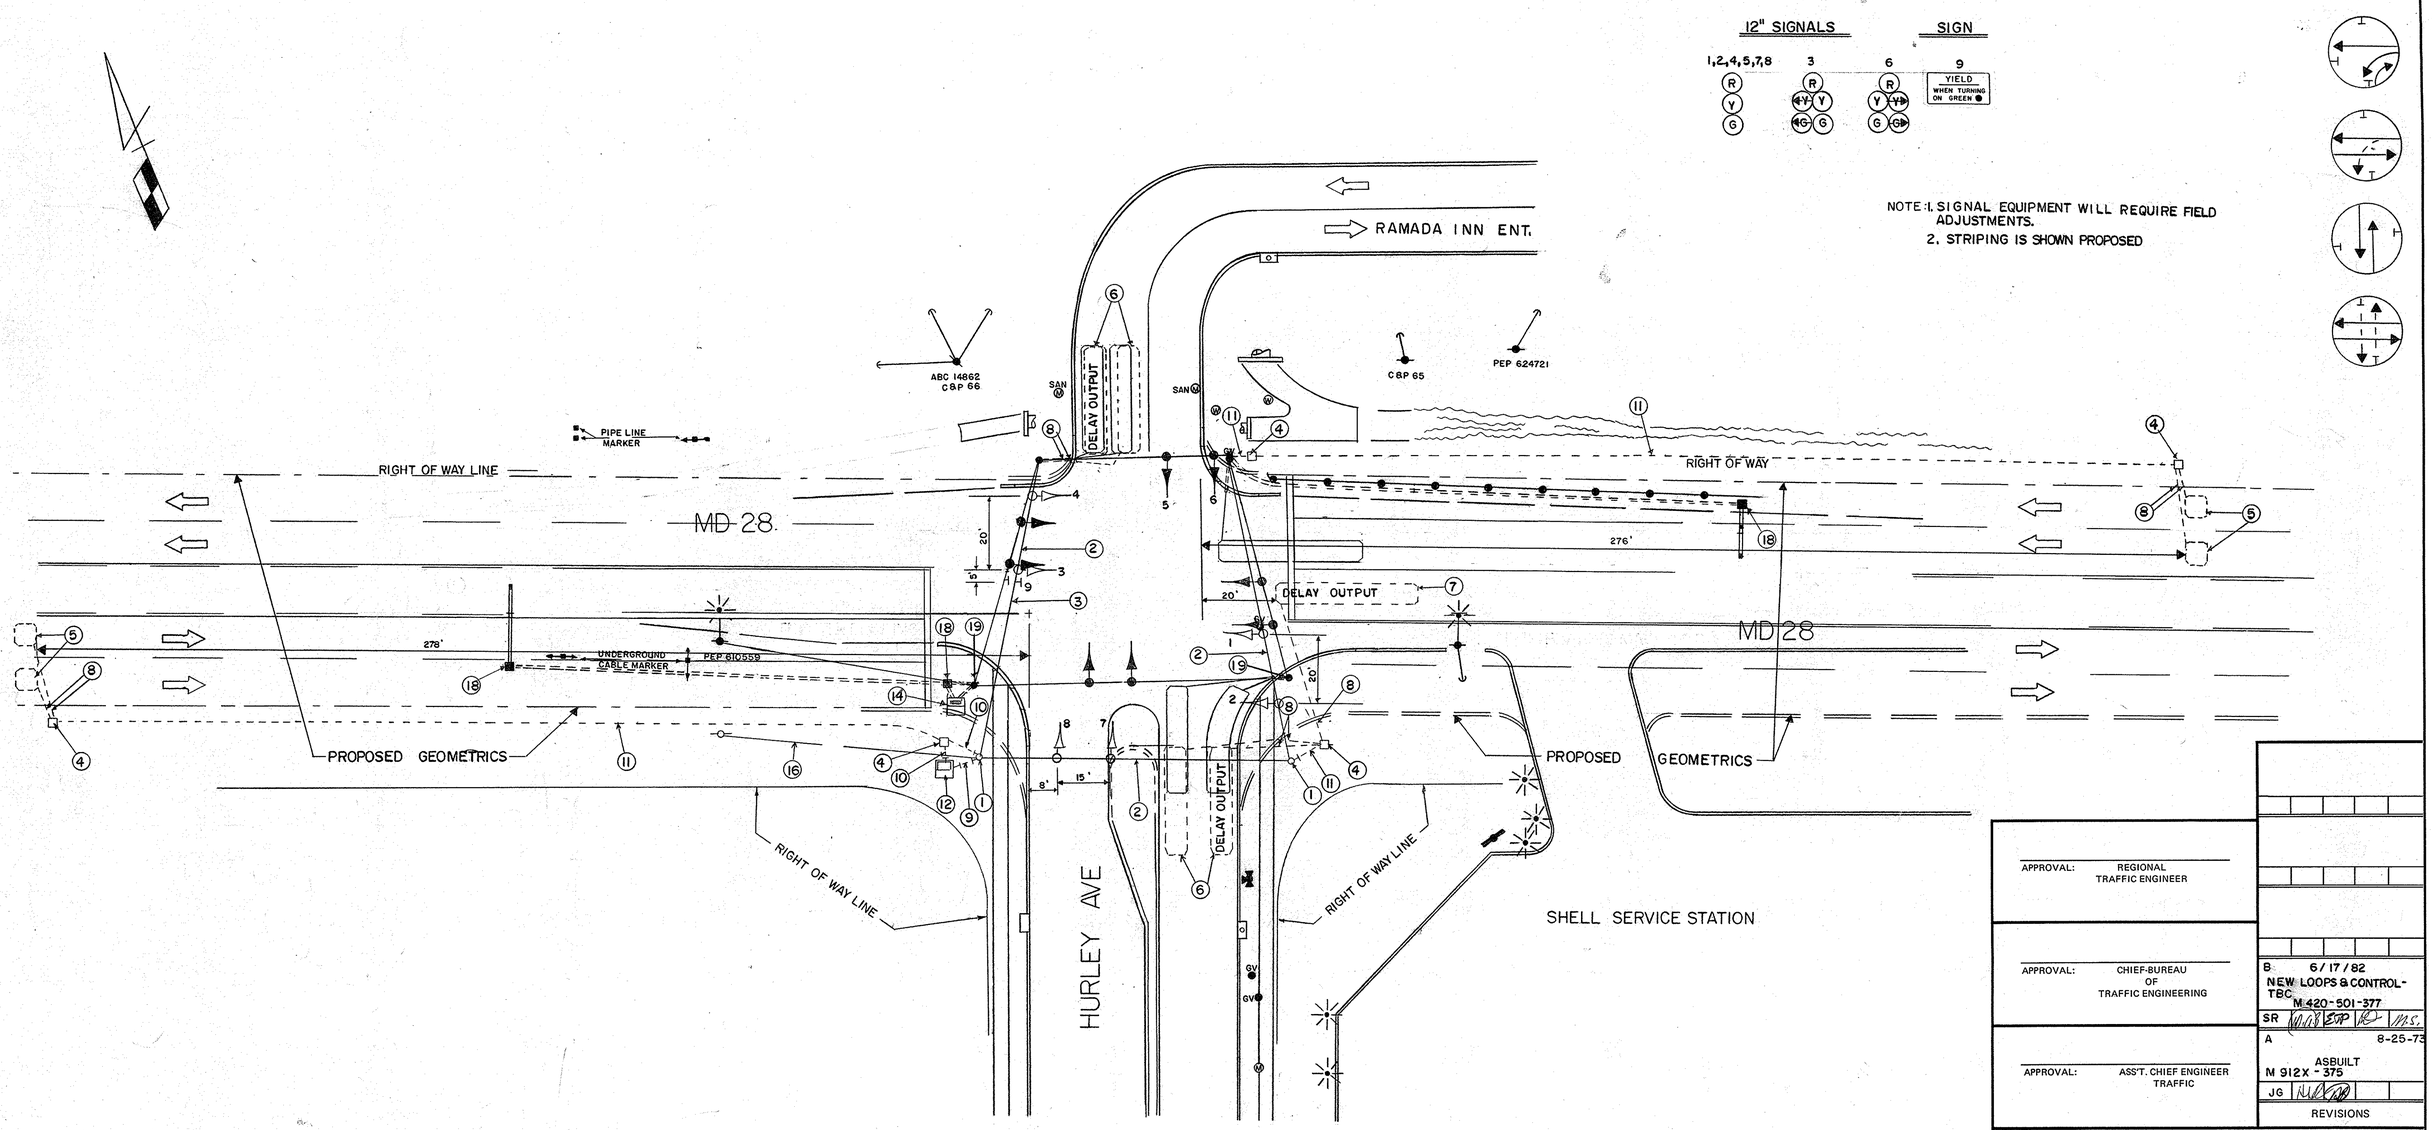

APPROVAL: REGIONAL TRAFFIC ENGINEER

APPROVAL: CHIEF-BUREAU OF TRAFFIC ENGINEERING

APPROVAL: ASS'T. CHIEF ENGINEER TRAFFIC

B 6/17/82 NEW LOOPS & CONTROL-TBC M 420-501-377

SR

A 8-25-73 ASBUILT M 912X-375

JG

REVISIONS

STATE OF MARYLAND
DEPARTMENT OF TRANSPORTATION
STATE HIGHWAY ADMINISTRATION

TRAFFIC DIVISION – BUREAU OF TRAFFIC ENGINEERING

MD 28 & HURLEY AVE

SCALE 1"=20' DATE 2-7-73 CONTRACT NO.

DRAWN BY: J GORDON COUNTY: MONTGOMERY

DESIGNED BY: W. RICHARDSON SIGNAL NO.: 15198

CHECKED BY:

DRAWING NO. TS- 858