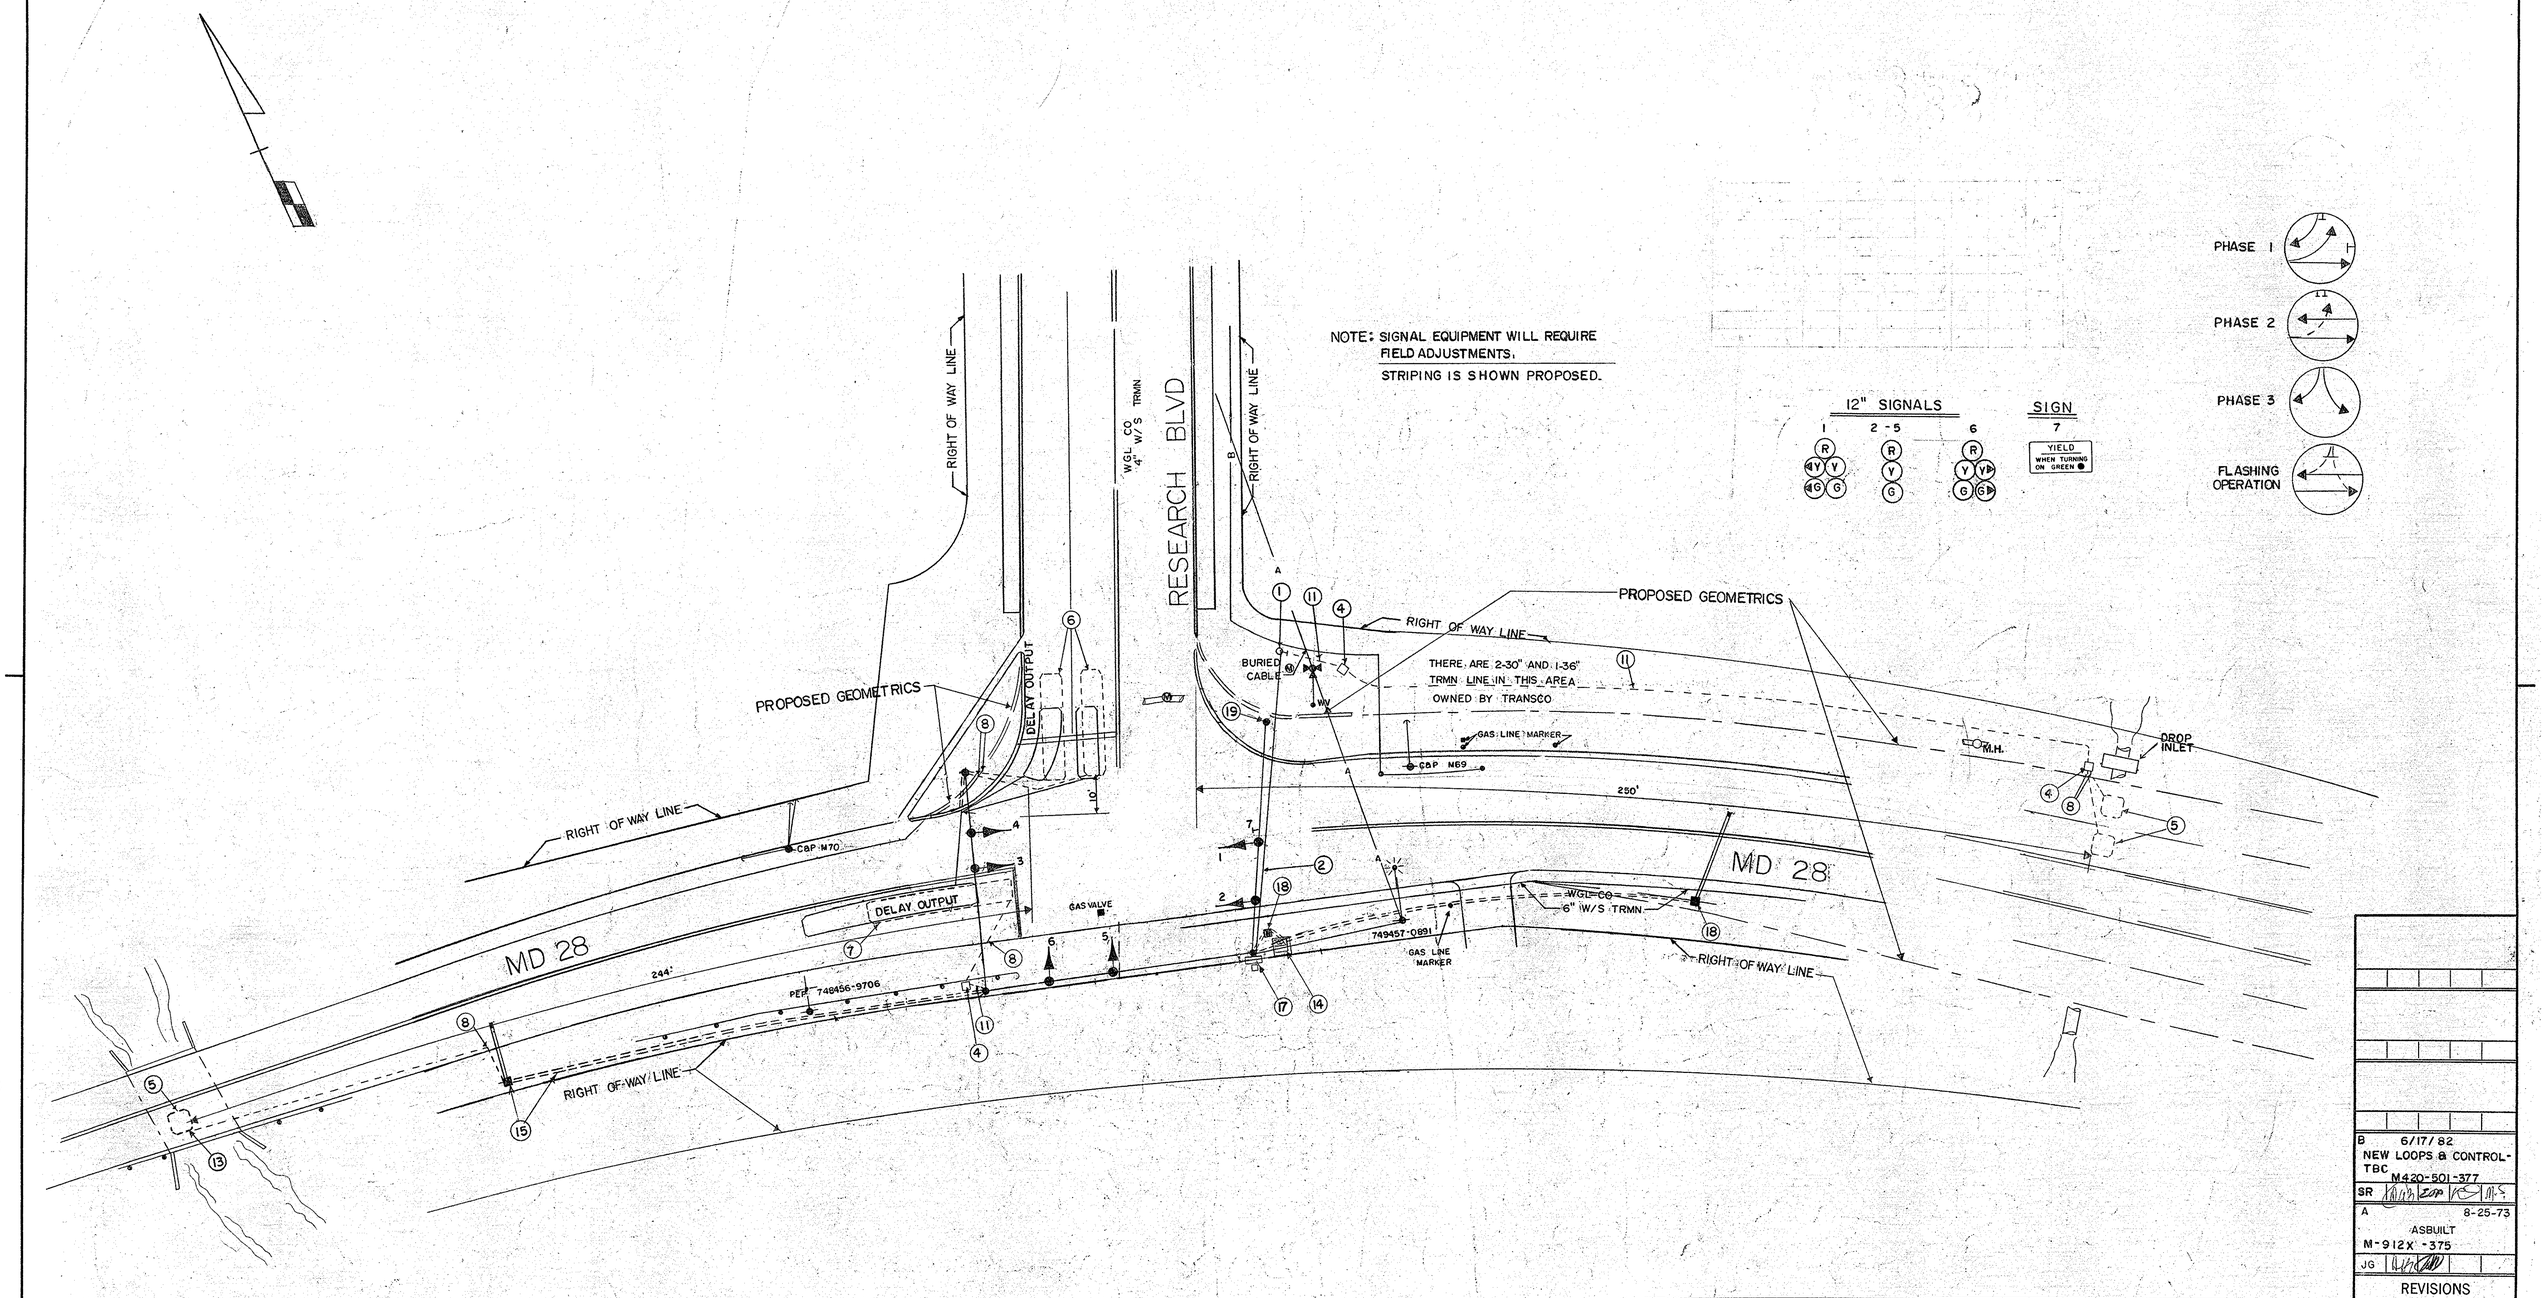

B	6/17/82 NEW LOOPS & CONTROL-TBC M420-501-377
SR	
A	8-25-73 ASBUILT M-912X-375
JG	

REVISIONS

APPROVAL: CHIEF - BUREAU OF TRAFFIC ENGINEERING

GINEER
FETY

MARYLAND STATE ROADS COMMISSION
DIVISION OF TRAFFIC SAFETY
BUREAU OF TRAFFIC ENGINEERING

MD28 & RESEARCH BLVD

SIGNAL NO. 15183

DATE 10-11-72
SCALE 1"=20'
DRAWN BY: S FOSTER
CONTRACT NO
COUNTY MONTGOMERY
CHECKED BY: William J. Fitch

DRAWING NO. TS-545.

DIETZGEN 10820