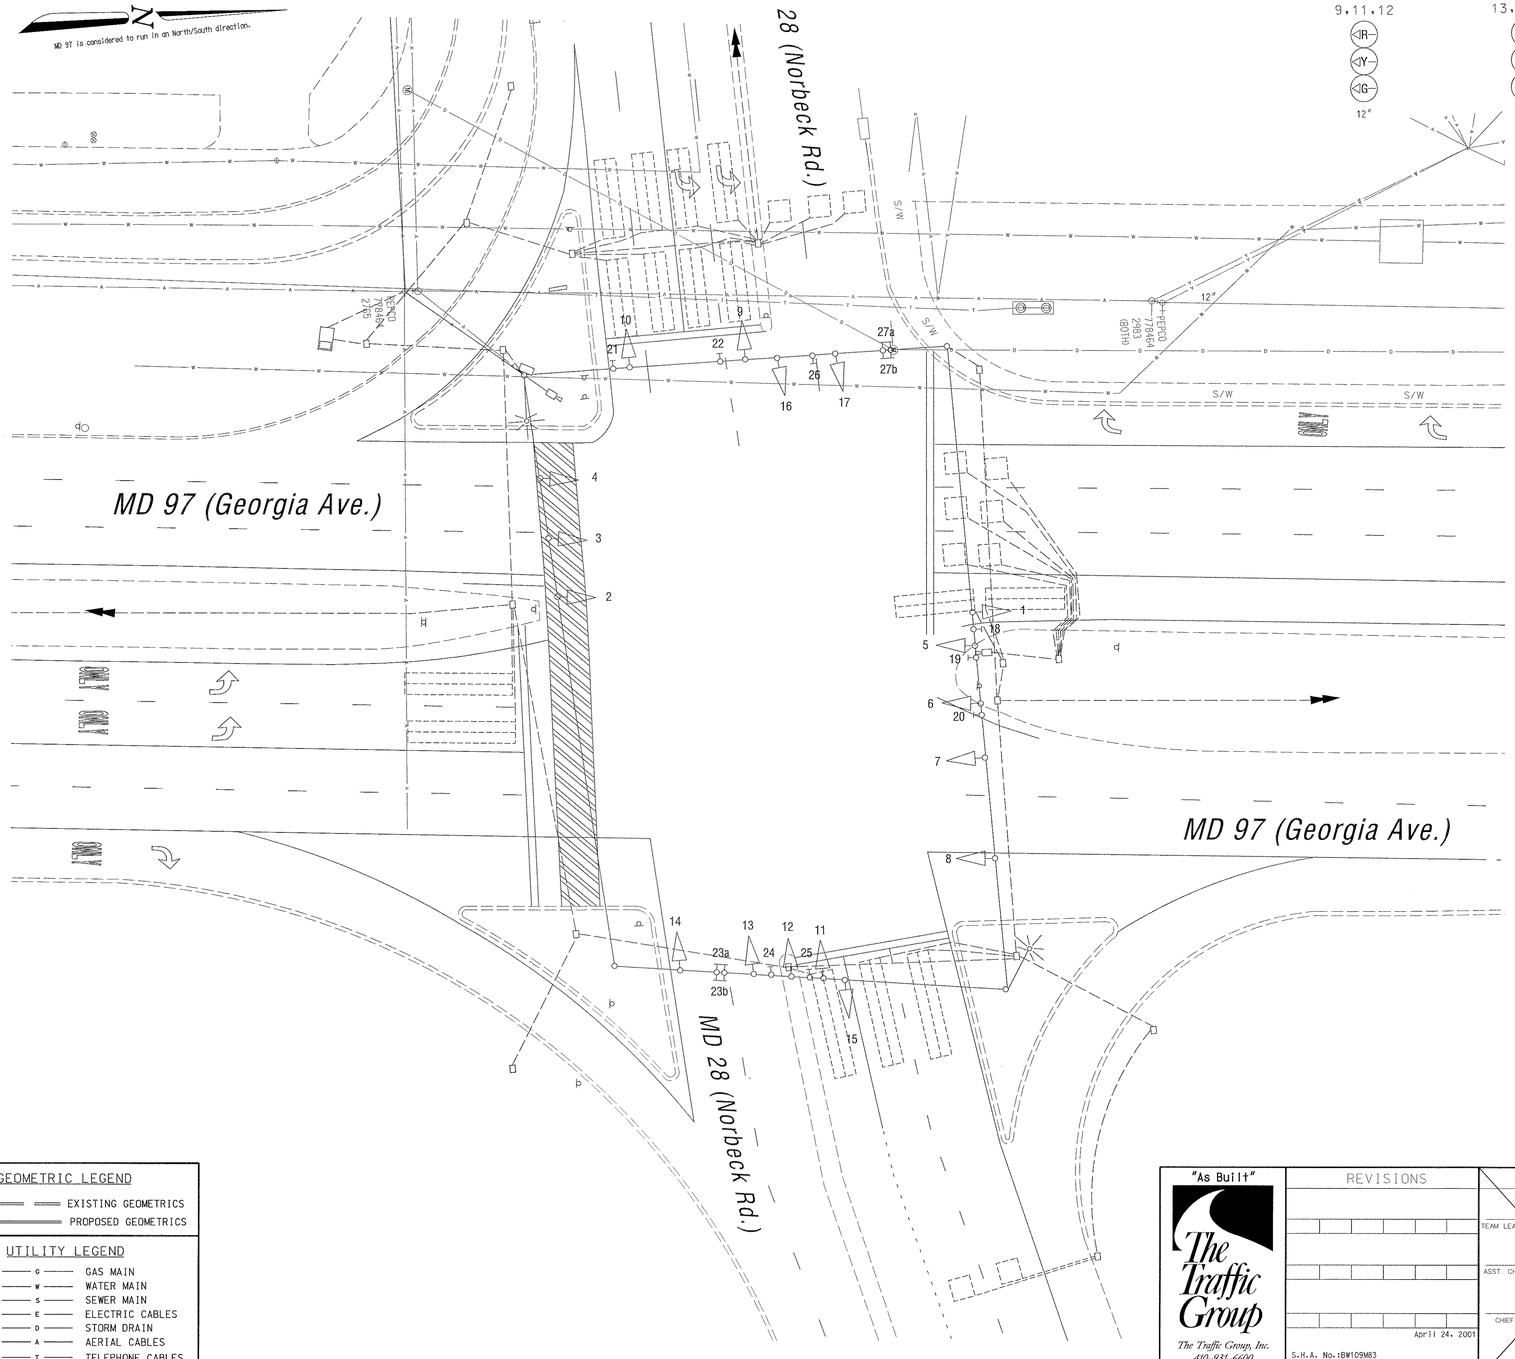

EXISTING SIGNALS

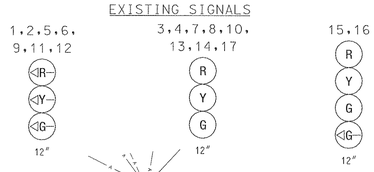

EXISTING NEMA PHASING

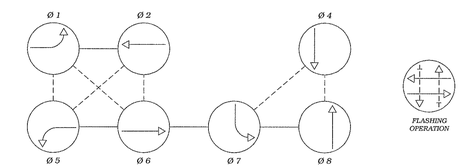

EXISTING SIGNS

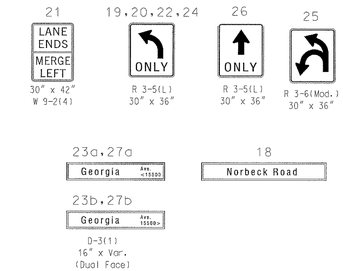

GEOMETRIC LEGEND

EXISTING GEOMETRICS

PROPOSED GEOMETRICS

UTILITY LEGEND

G	GAS MAIN
W	WATER MAIN
S	SEWER MAIN
E	ELECTRIC CABLES
D	STORM DRAIN
A	AERIAL CABLES
T	TELEPHONE CABLES

"As Built"

The Traffic Group

The Traffic Group, Inc.
410-931-6600
Fax 410-931-6601

REVISIONS

April 24, 2001

S.H.A. No.:BW109M83

rmd

APPROVALS

TEAM LEADER, TRAFFIC ENGINEERING DESIGN DIVISION

ASST. CHIEF TRAFFIC ENGINEERING DESIGN DIVISION

CHIEF, TRAFFIC ENGINEERING DESIGN DIVISION

DIRECTOR, TRAFFIC & SAFETY

ORIGINAL ON FILE

MARYLAND DOT - STATE HIGHWAY ADMINISTRATION

Office of Traffic & Safety

TRAFFIC ENGINEERING DESIGN DIVISION

(Traffic Signal Plan)

MD 97 (Georgia Ave.) at MD 28 (Norbeck Rd.)

DRAWN BY:	B. Kent	F.A.P. NO.		TS NO. 190A	SHEET NO.
CHECKED BY:		S.H.A. NO.			
SCALE:	1" = 20'	COUNTY:	Montgomery	T.I.M.S. NO.	1 OF 1
DATE:	June 13, 1990	LOG MILE:	15002827.04		

f:\1995\951020-a\des\asbuilt-a1.dgn 24 APR 2001