EXISTING SIGNS

11a,13a
Rossmoor Blvd. 3800>

11b,13b
Rossmoor Blvd. <3700
D-3(1)
16" x Var.

14a,17a
Georgia Ave. <16800

14b,17b
Georgia Ave. 15000>
D-3(1)
16" x Var.

12
LEFT TURN YIELD ON GREEN
R 10-12
36" x 42"

15
ONLY
R 3-5(L)
30" x 36"

16
R 3-6(L)
30" x 36"

EXISTING SIGNALS

1 R Y G 12"
1 R Y G 12"
1 R Y G 8"
1 R Y G 12"/8"

EXISTING NEMA PHASING

Ø2 Ø3 Ø4 Ø5 Ø6

FLASHING OPERATION

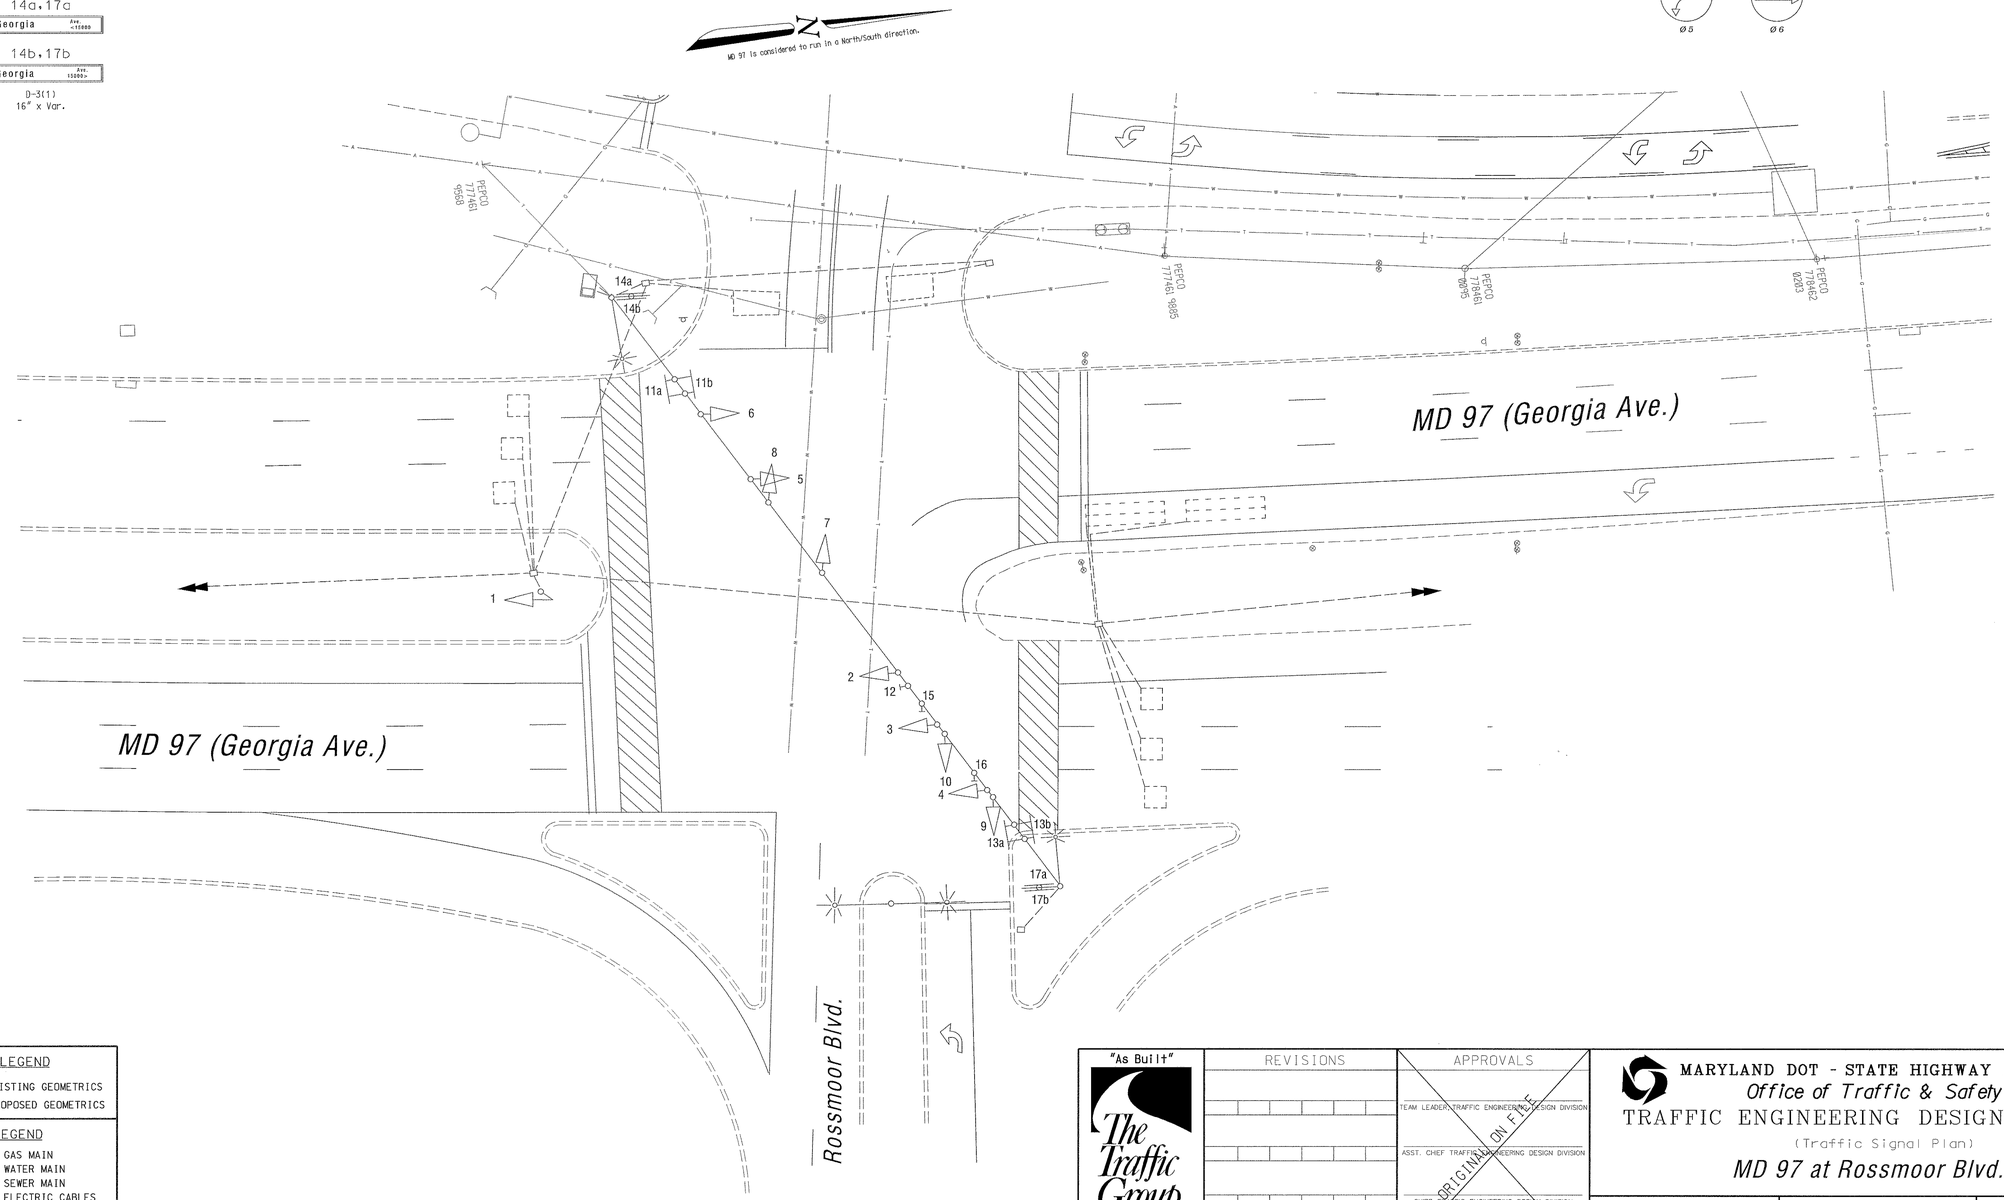

GEOMETRIC LEGEND

EXISTING GEOMETRICS
PROPOSED GEOMETRICS

UTILITY LEGEND

G — GAS MAIN
W — WATER MAIN
S — SEWER MAIN
E — ELECTRIC CABLES
D — STORM DRAIN
A — AERIAL CABLES
T — TELEPHONE CABLES

"As Built"

The Traffic Group

The Traffic Group, Inc.
410-931-6600
Fax 410-931-6601

REVISIONS

April 24, 2001

S.H.A. No.:BW109M83

rmd

APPROVALS

TEAM LEADER, TRAFFIC ENGINEERING DESIGN DIVISION

ASST. CHIEF TRAFFIC ENGINEERING DESIGN DIVISION

CHIEF, TRAFFIC ENGINEERING DESIGN DIVISION

DIRECTOR, TRAFFIC & SAFETY

ORIGINAL ON FILE

MARYLAND DOT - STATE HIGHWAY ADMINISTRATION
Office of Traffic & Safety
TRAFFIC ENGINEERING DESIGN DIVISION
(Traffic Signal Plan)
MD 97 at Rossmoor Blvd.

DRAWN BY:	W. Richardson	F.A.P. NO.	XXX	TS NO. 1928 A	SHEET NO.
CHECKED BY:		S.H.A. NO.	XXX		
SCALE:	1" = 20'	COUNTY:	Montgomery	T.I.M.S. NO. XXX	1 OF 1
DATE:	January 10, 1984	LOG MILE:	15009708.25		

f:\1995\951020-a\des\asbuilt-a2.dgn 24 APR 2001