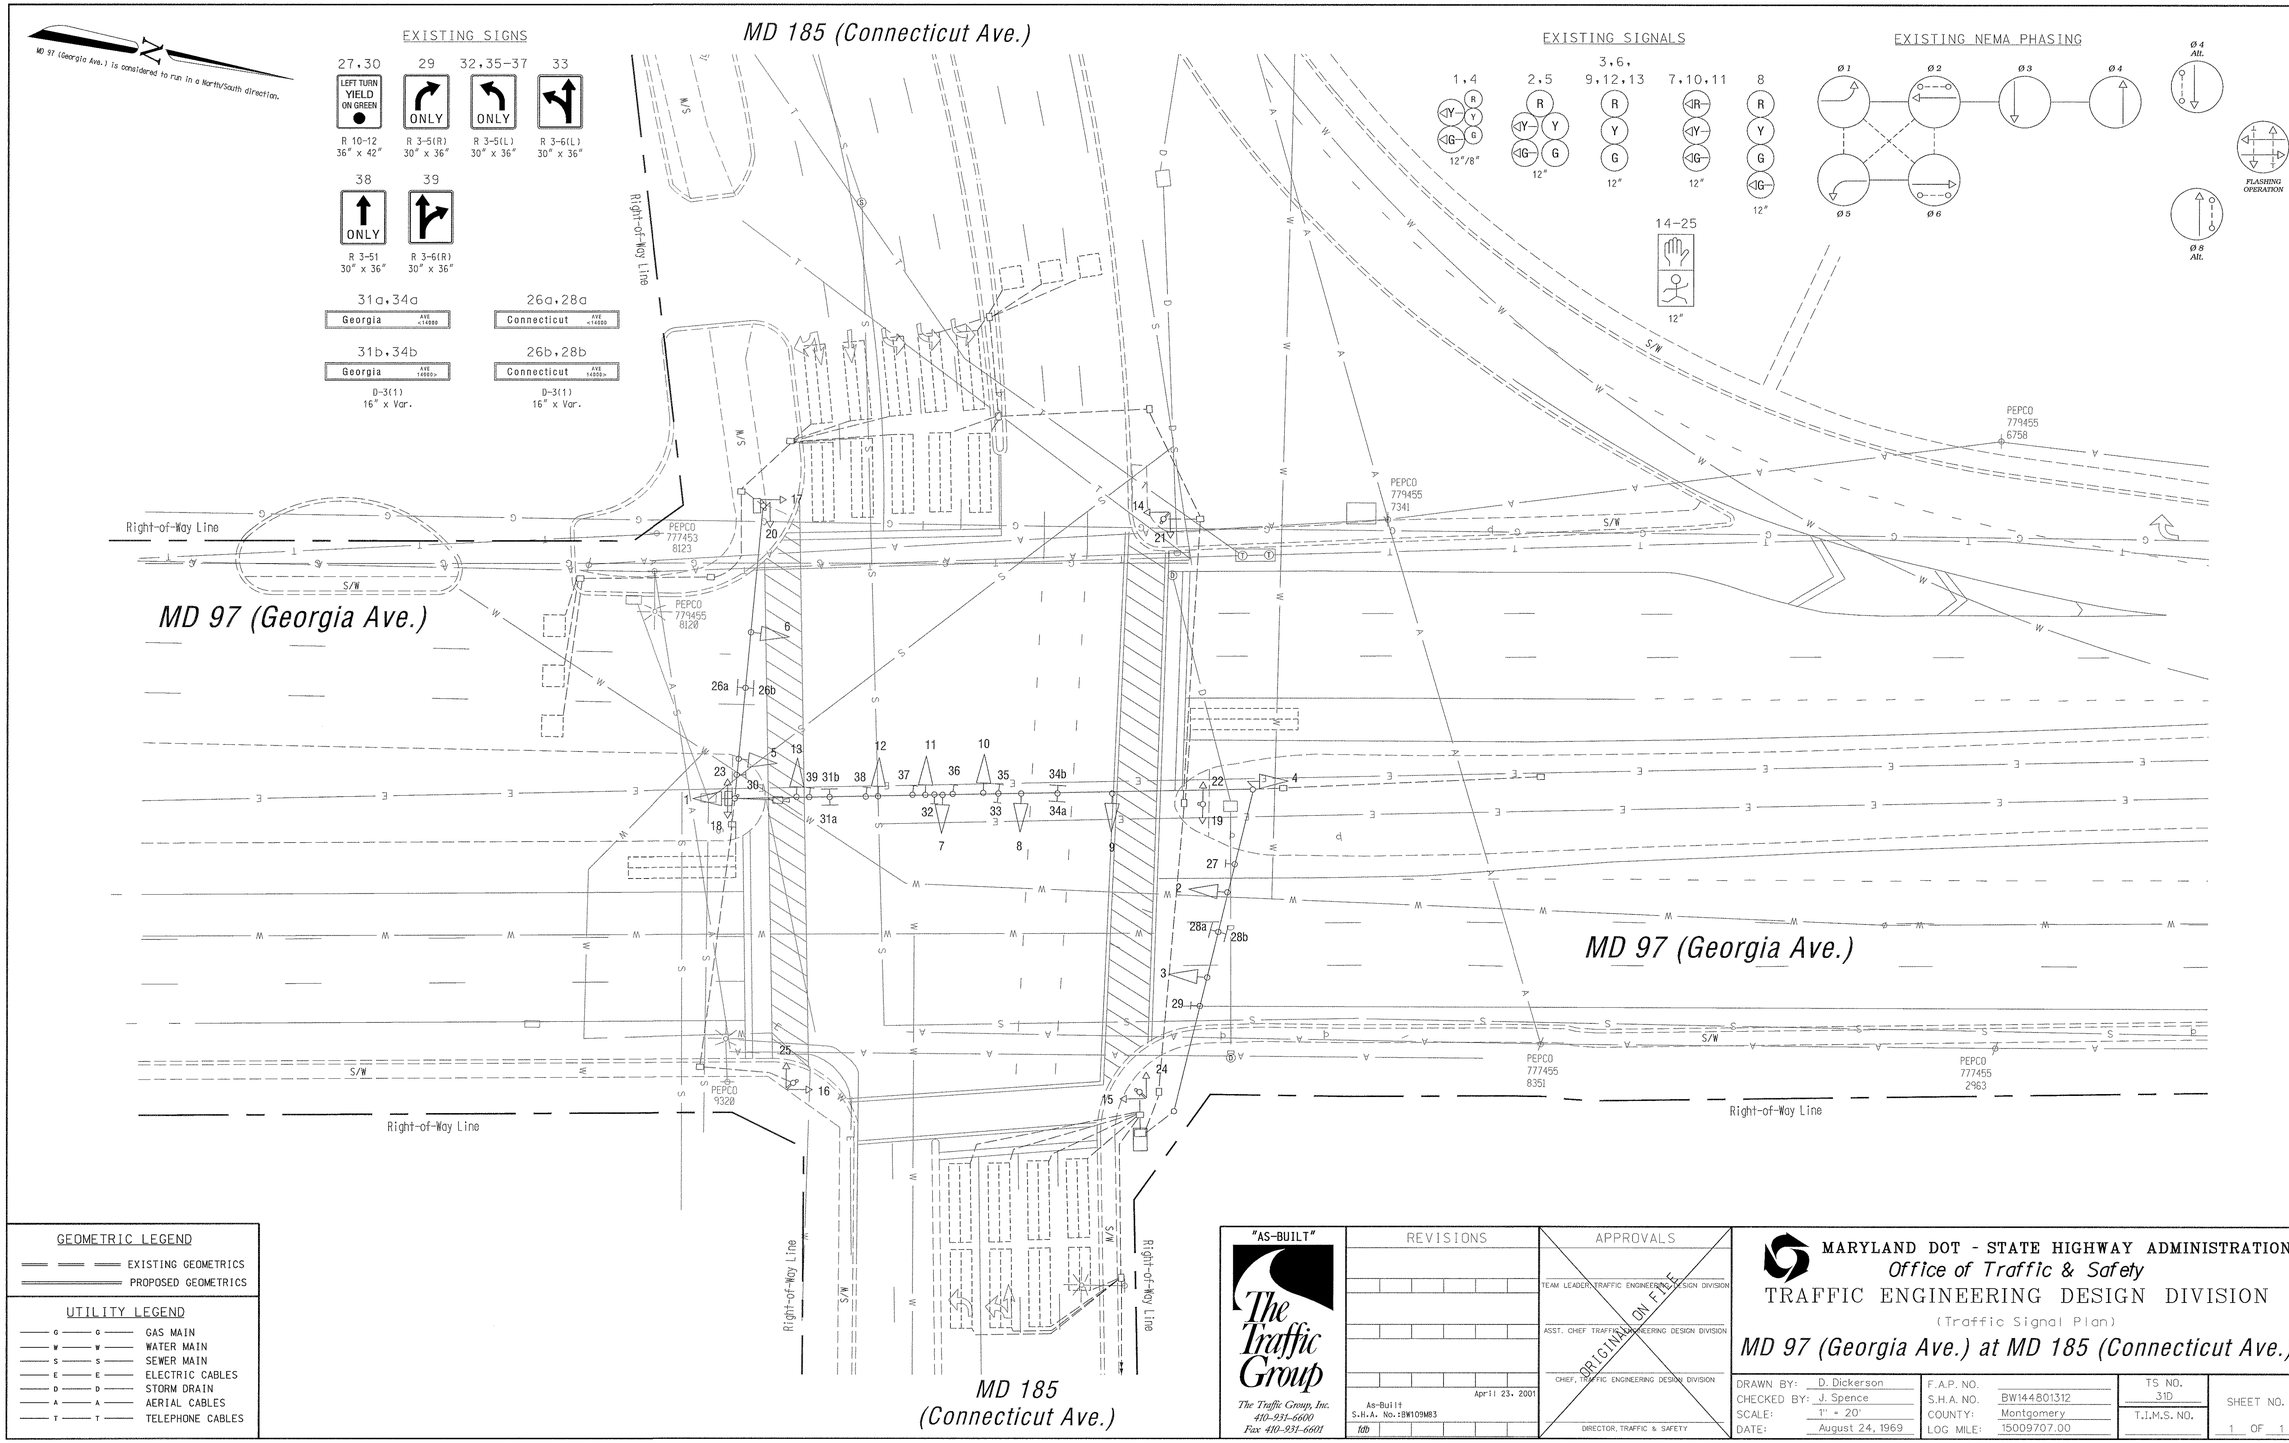

GEOMETRIC LEGEND

EXISTING GEOMETRICS

PROPOSED GEOMETRICS

UTILITY LEGEND

G	GAS MAIN
W	WATER MAIN
S	SEWER MAIN
E	ELECTRIC CABLES
D	STORM DRAIN
A	AERIAL CABLES
T	TELEPHONE CABLES

"AS-BUILT"

The Traffic Group

The Traffic Group, Inc.
410-931-6600
Fax 410-931-6601

REVISIONS

April 23, 2001

As-Built
S.H.A. No.:BW109M83

APPROVALS

TEAM LEADER, TRAFFIC ENGINEERING DESIGN DIVISION

ASST. CHIEF TRAFFIC ENGINEERING DESIGN DIVISION

CHIEF, TRAFFIC ENGINEERING DESIGN DIVISION

DIRECTOR, TRAFFIC & SAFETY

ORIGINAL ON FILE

MARYLAND DOT - STATE HIGHWAY ADMINISTRATION

Office of Traffic & Safety

TRAFFIC ENGINEERING DESIGN DIVISION

(Traffic Signal Plan)

MD 97 (Georgia Ave.) at MD 185 (Connecticut Ave.)

DRAWN BY:	D. Dickerson	F.A.P. NO.		TS NO. 31D	SHEET NO.
CHECKED BY:	J. Spence	S.H.A. NO.	BW144801312	T.I.M.S. NO.	1 OF 1
SCALE:	1" = 20'	COUNTY:	Montgomery		
DATE:	August 24, 1969	LOG MILE:	15009707.00		

f:\1995\951020-a\des\asbuilt-b2.dgn 24 APR 2001