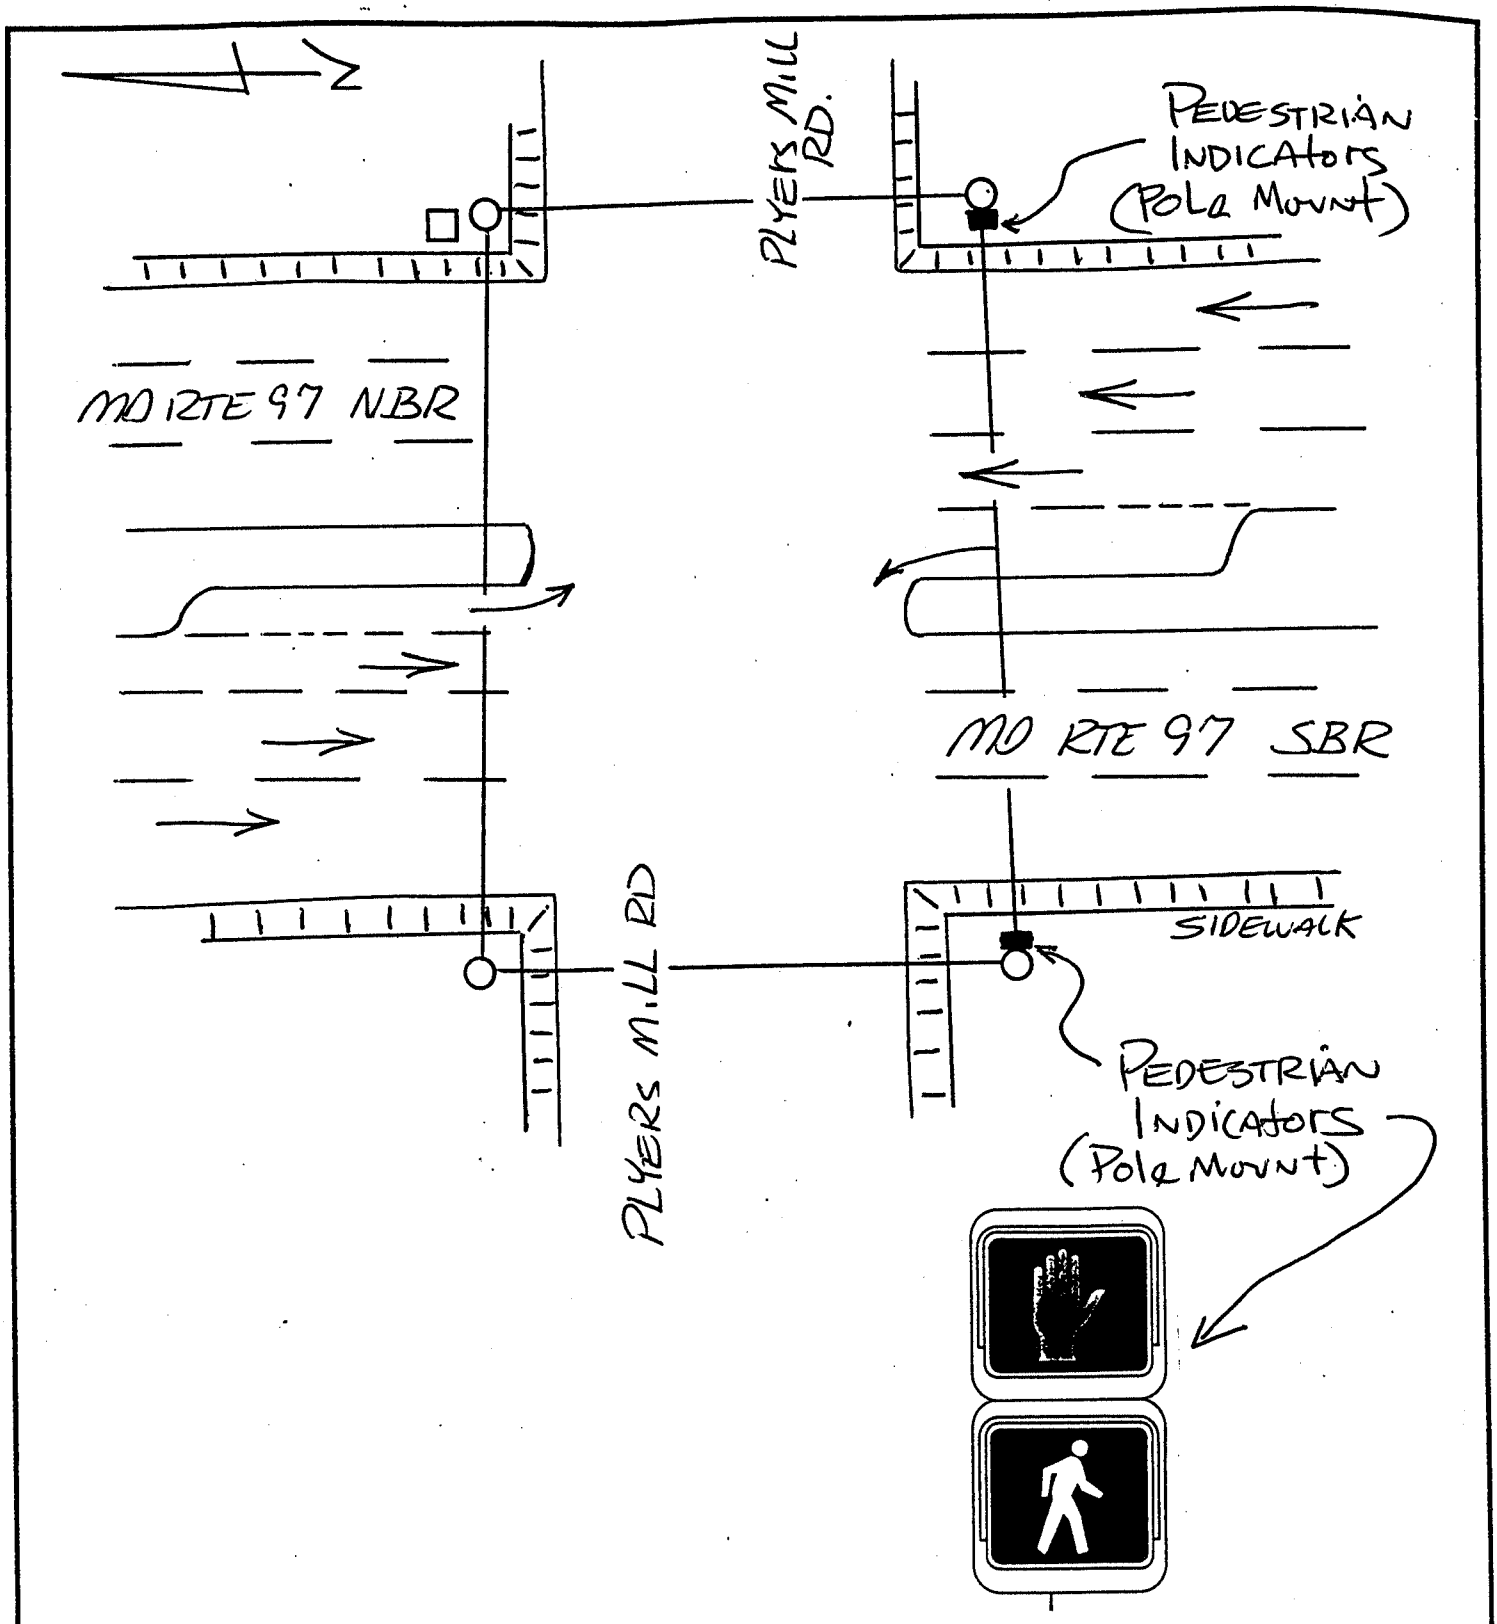

TS 215A - SHOP REVISION

TIMS # C927

APPROVALS	MDOT - STATE HIGHWAY ADMINISTRATION Office of Traffic & Safety	
Project Manager\Engineer TEDD	MD RTE 97 @ PLYERS MILL RD	
Team Leader\Engineer TEDD	Contract No.: — County M Design Date: 6/30/98	Drawn By: LSH Checked By: