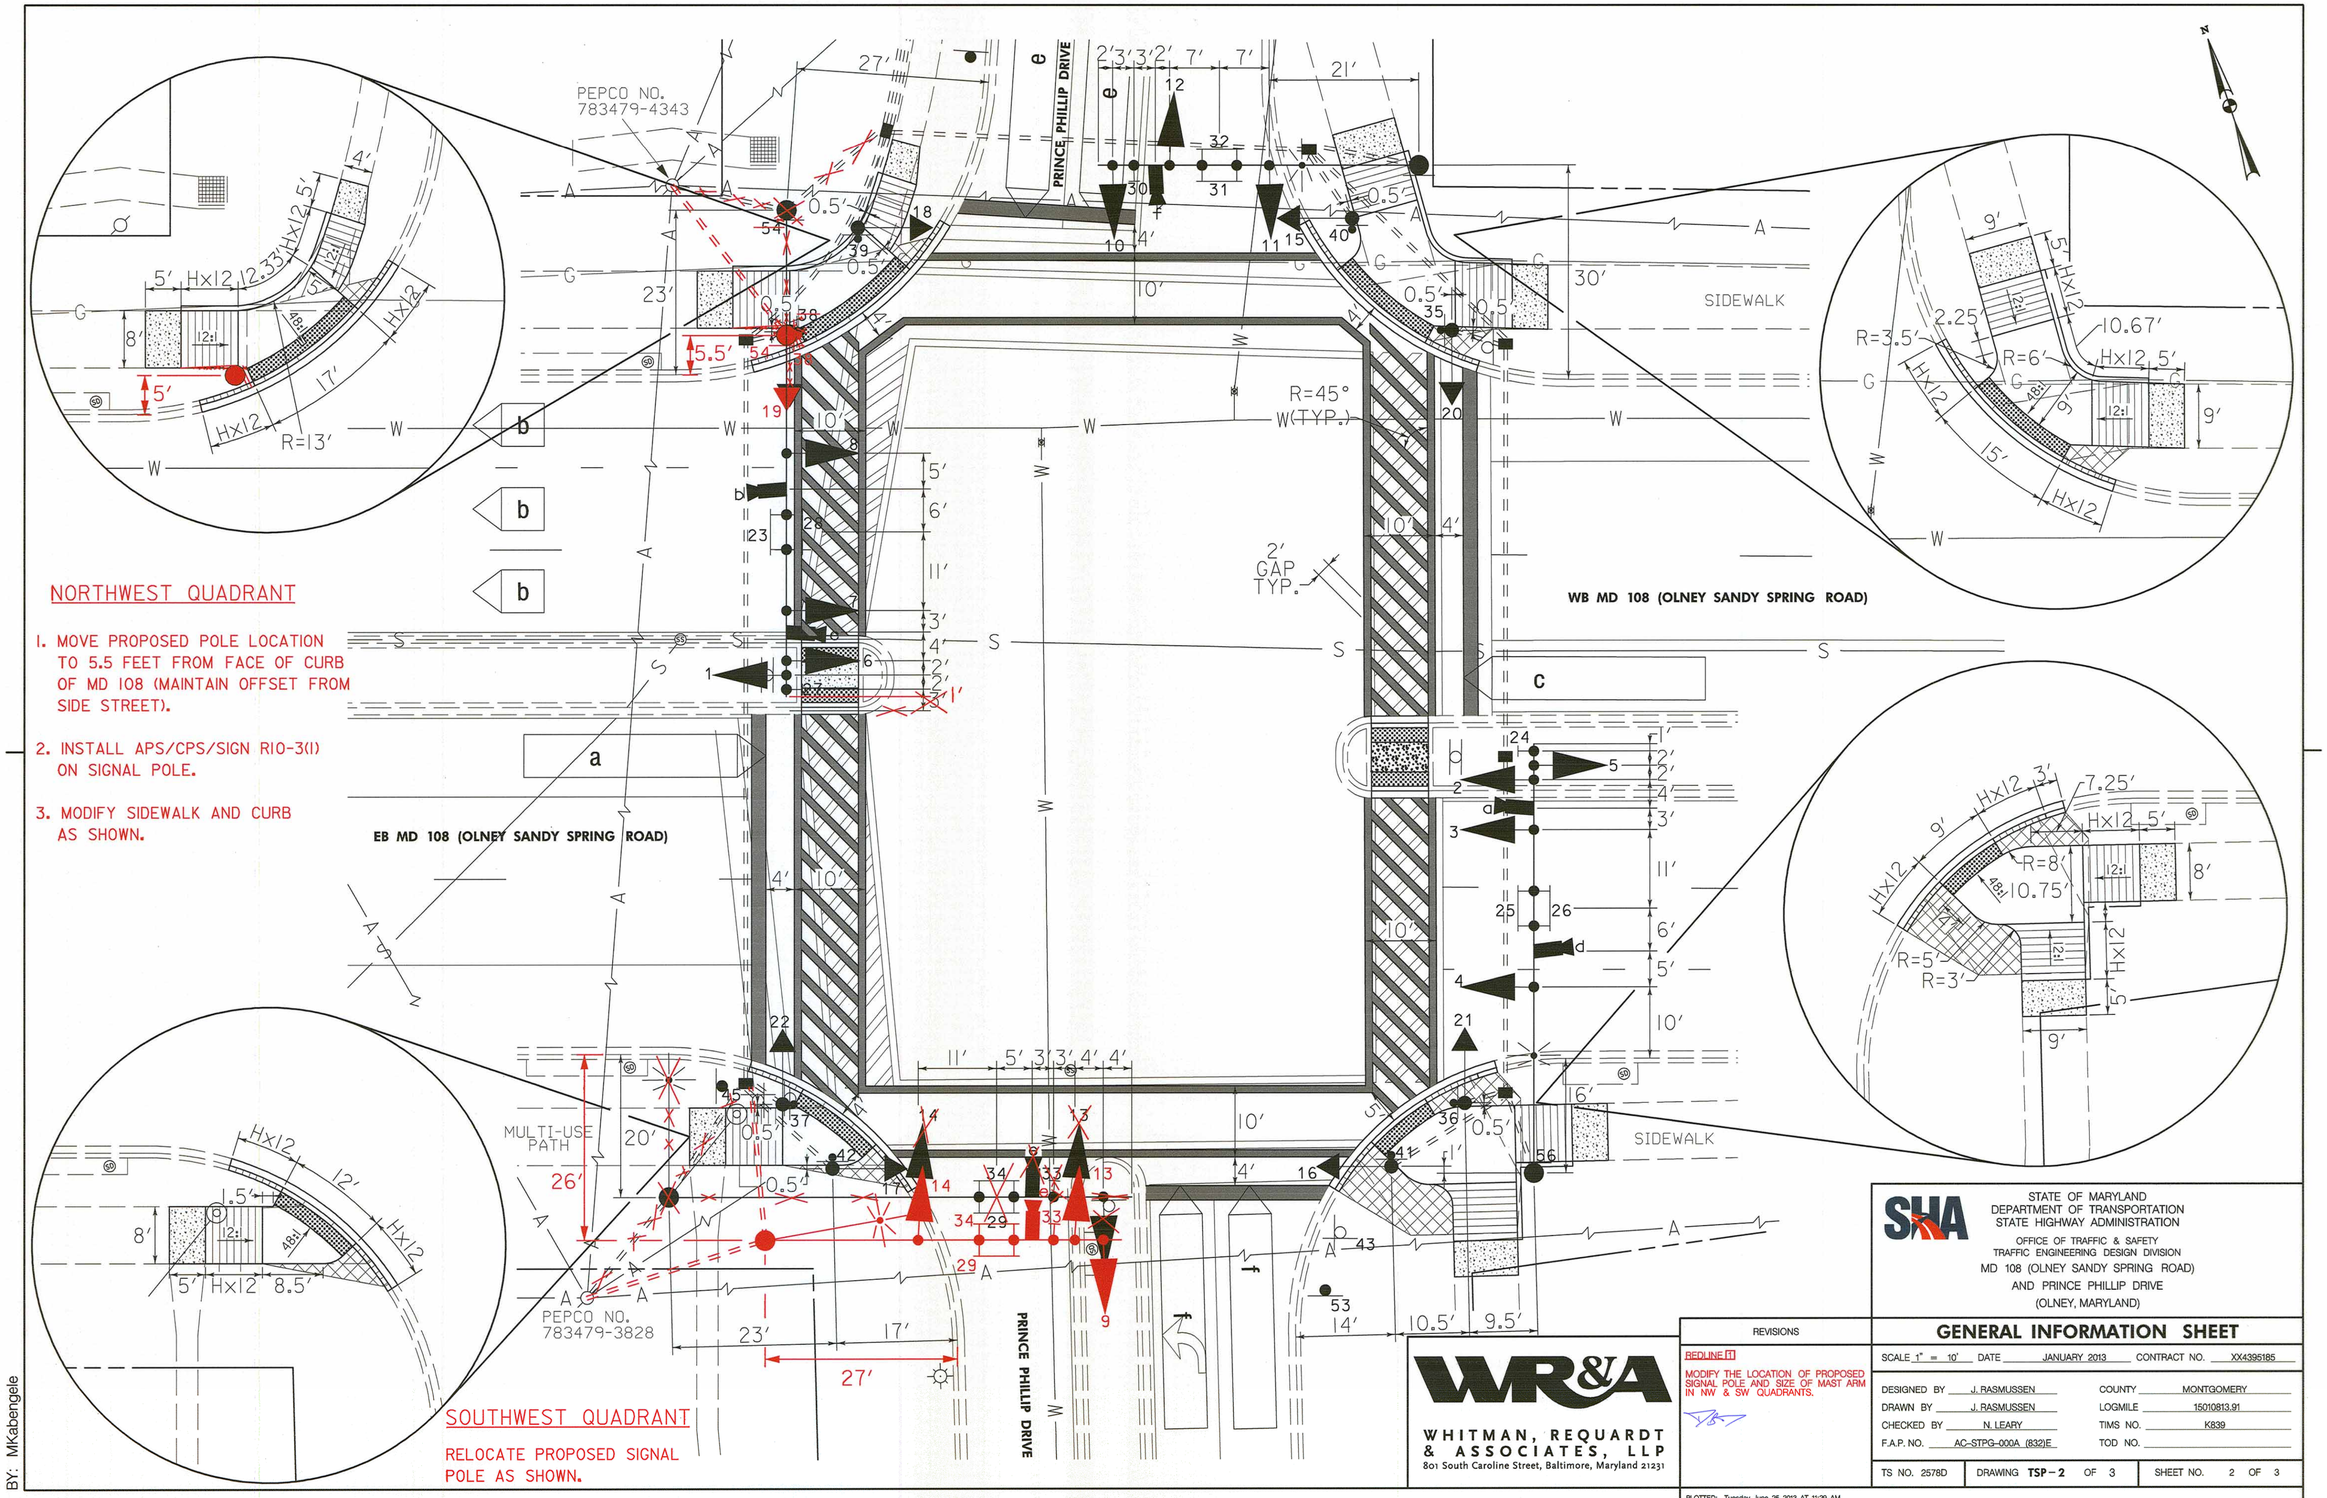

BY: MKabengele

STATE OF MARYLAND
DEPARTMENT OF TRANSPORTATION
STATE HIGHWAY ADMINISTRATION
OFFICE OF TRAFFIC & SAFETY
TRAFFIC ENGINEERING DESIGN DIVISION
MD 108 (OLNEY SANDY SPRING ROAD)
AND PRINCE PHILLIP DRIVE
(OLNEY, MARYLAND)

WHITMAN, REQUARDT & ASSOCIATES, LLP
801 South Caroline Street, Baltimore, Maryland 21231

REVISIONS

REDLINE 1
MODIFY THE LOCATION OF PROPOSED SIGNAL POLE AND SIZE OF MAST ARM IN NW & SW QUADRANTS.

GENERAL INFORMATION SHEET

SCALE 1" = 10' DATE JANUARY 2013 CONTRACT NO. XX4395185

DESIGNED BY J. RASMUSSEN
DRAWN BY J. RASMUSSEN
CHECKED BY N. LEARY
F.A.P. NO. AC-STPG-000A (832)E

COUNTY MONTGOMERY
LOGMILE 15010813.91
TIMS NO. K839
TOD NO.

TS NO. 2578D | DRAWING TSP-2 OF 3 | SHEET NO. 2 OF 3

PLOTTED: Tuesday, June 25, 2013 AT 11:29 AM
FILE: J:\DATA\K839\Design Files\PS&E\gSG-N002_MD108.dgn