F H WA REGION NO	STATE	FED. AID PROJ. NO	SHEET NO.	TOTAL SHEETS
3	MD.			

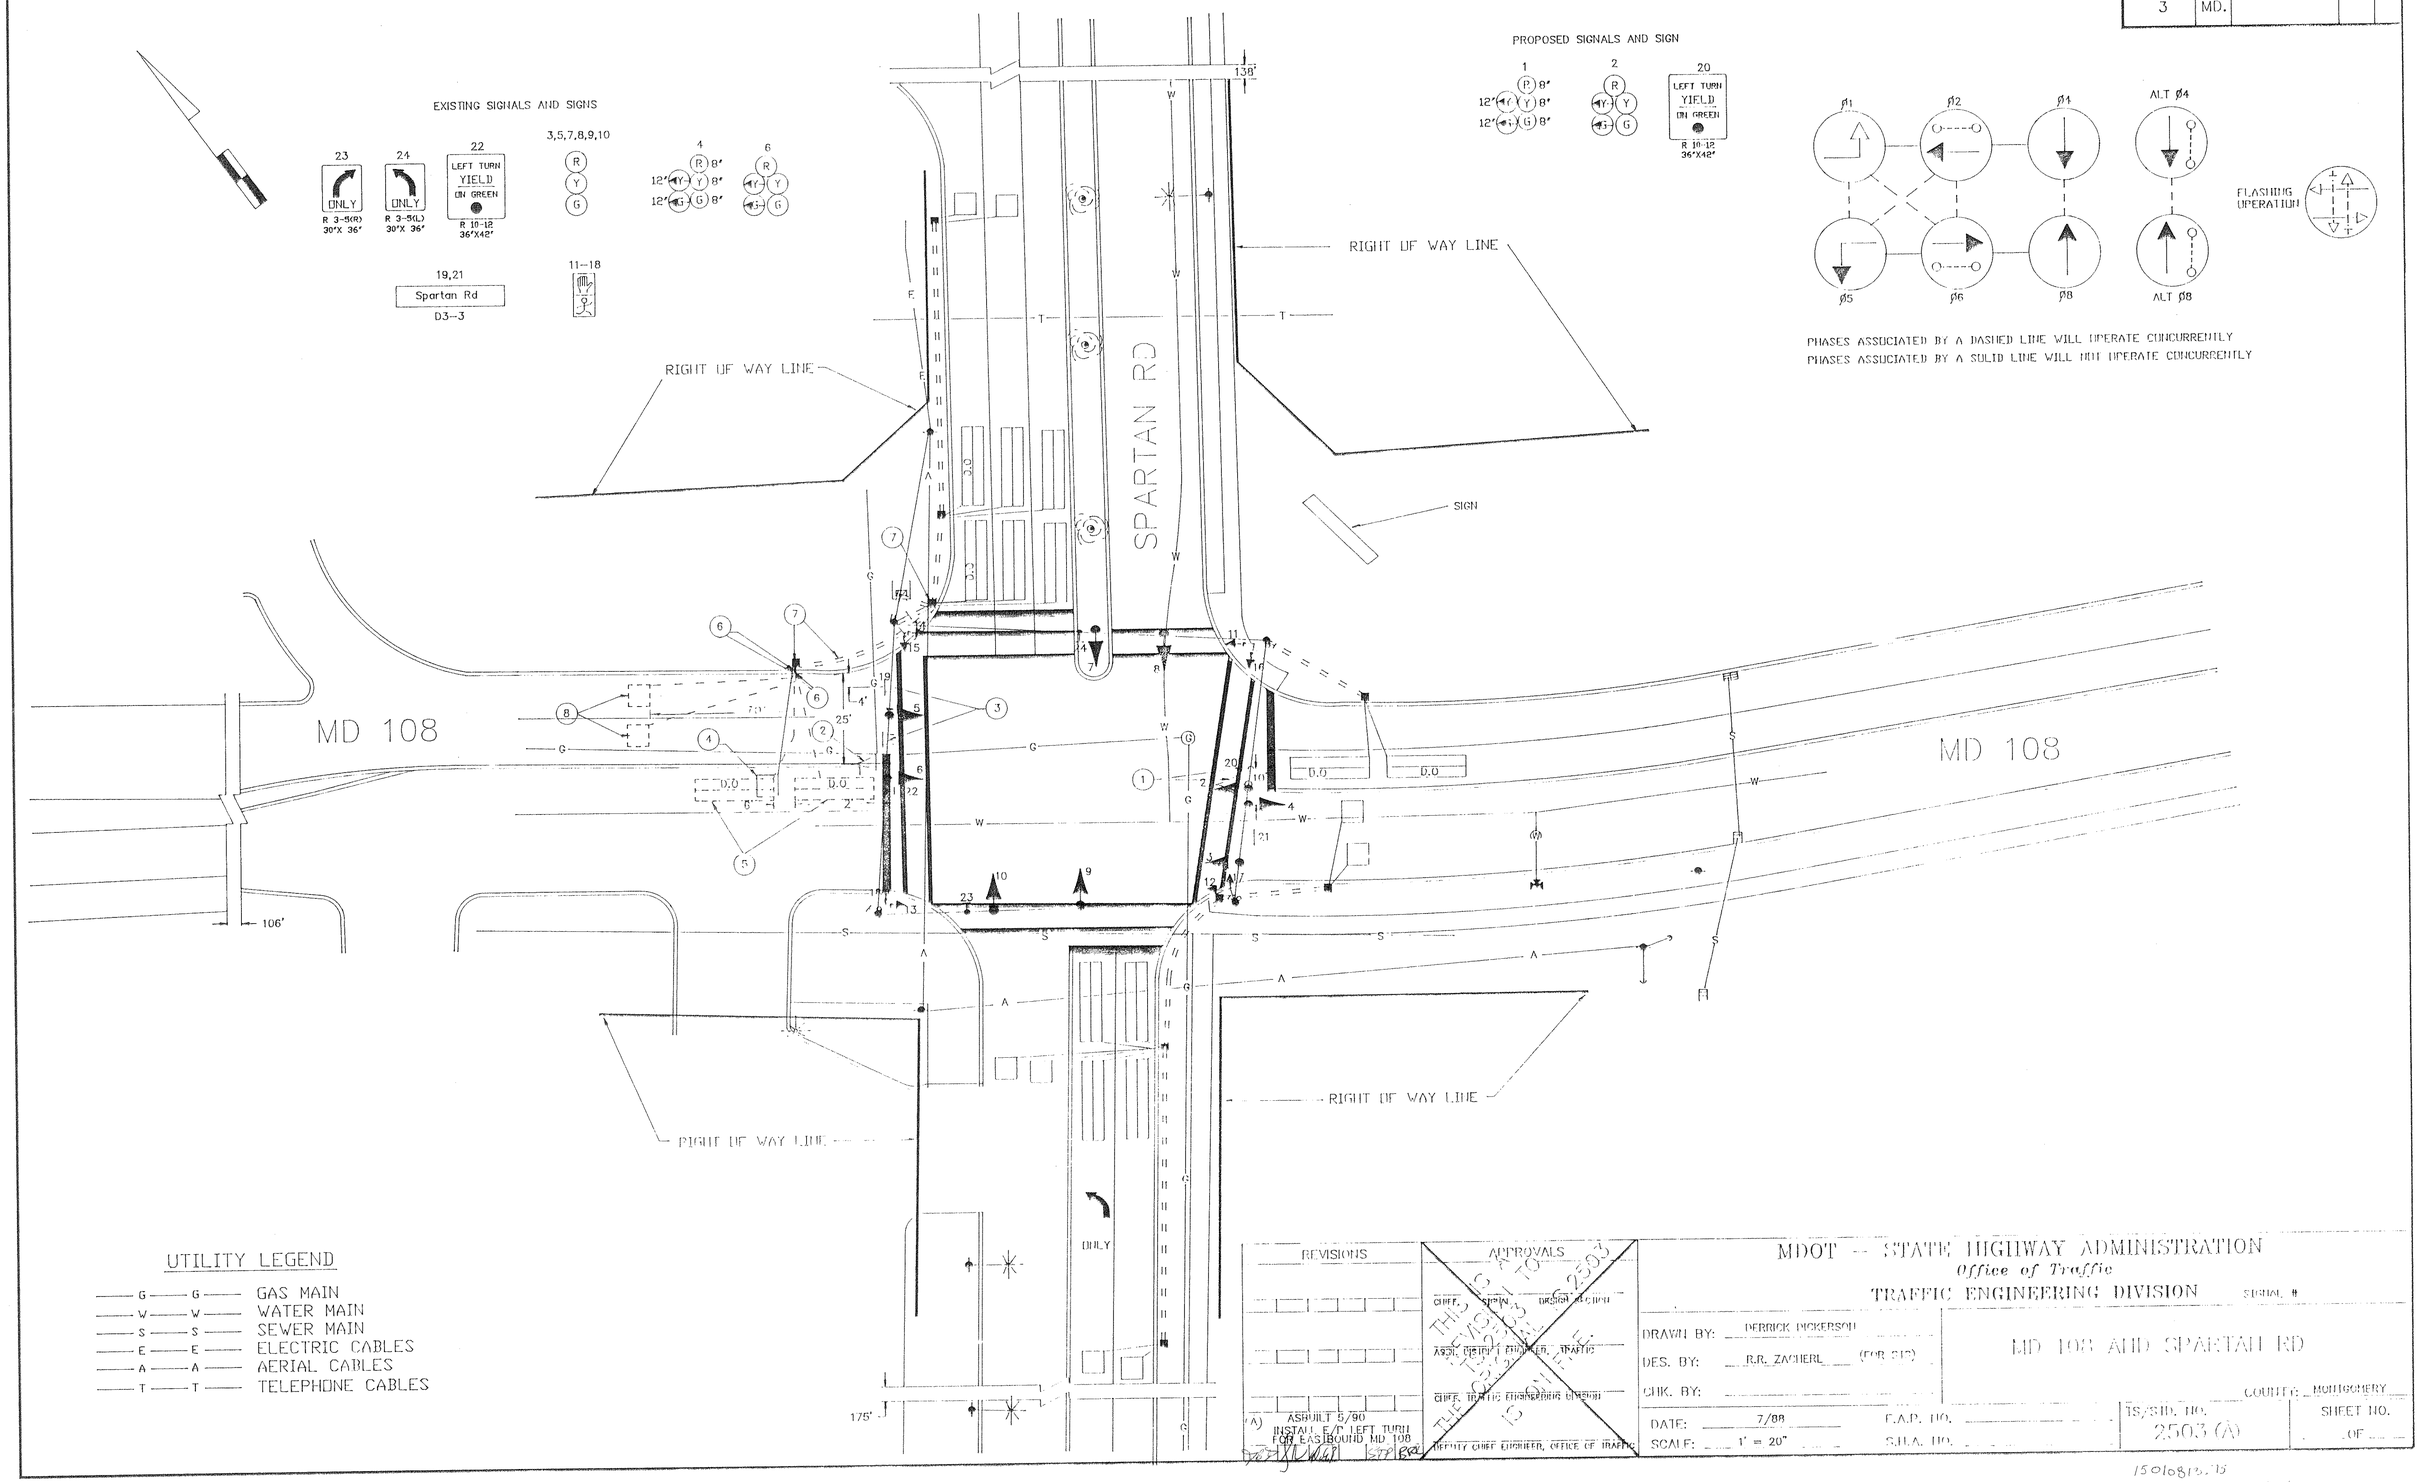

15010815.15

10/4/90 CONSULTANT
EAAM