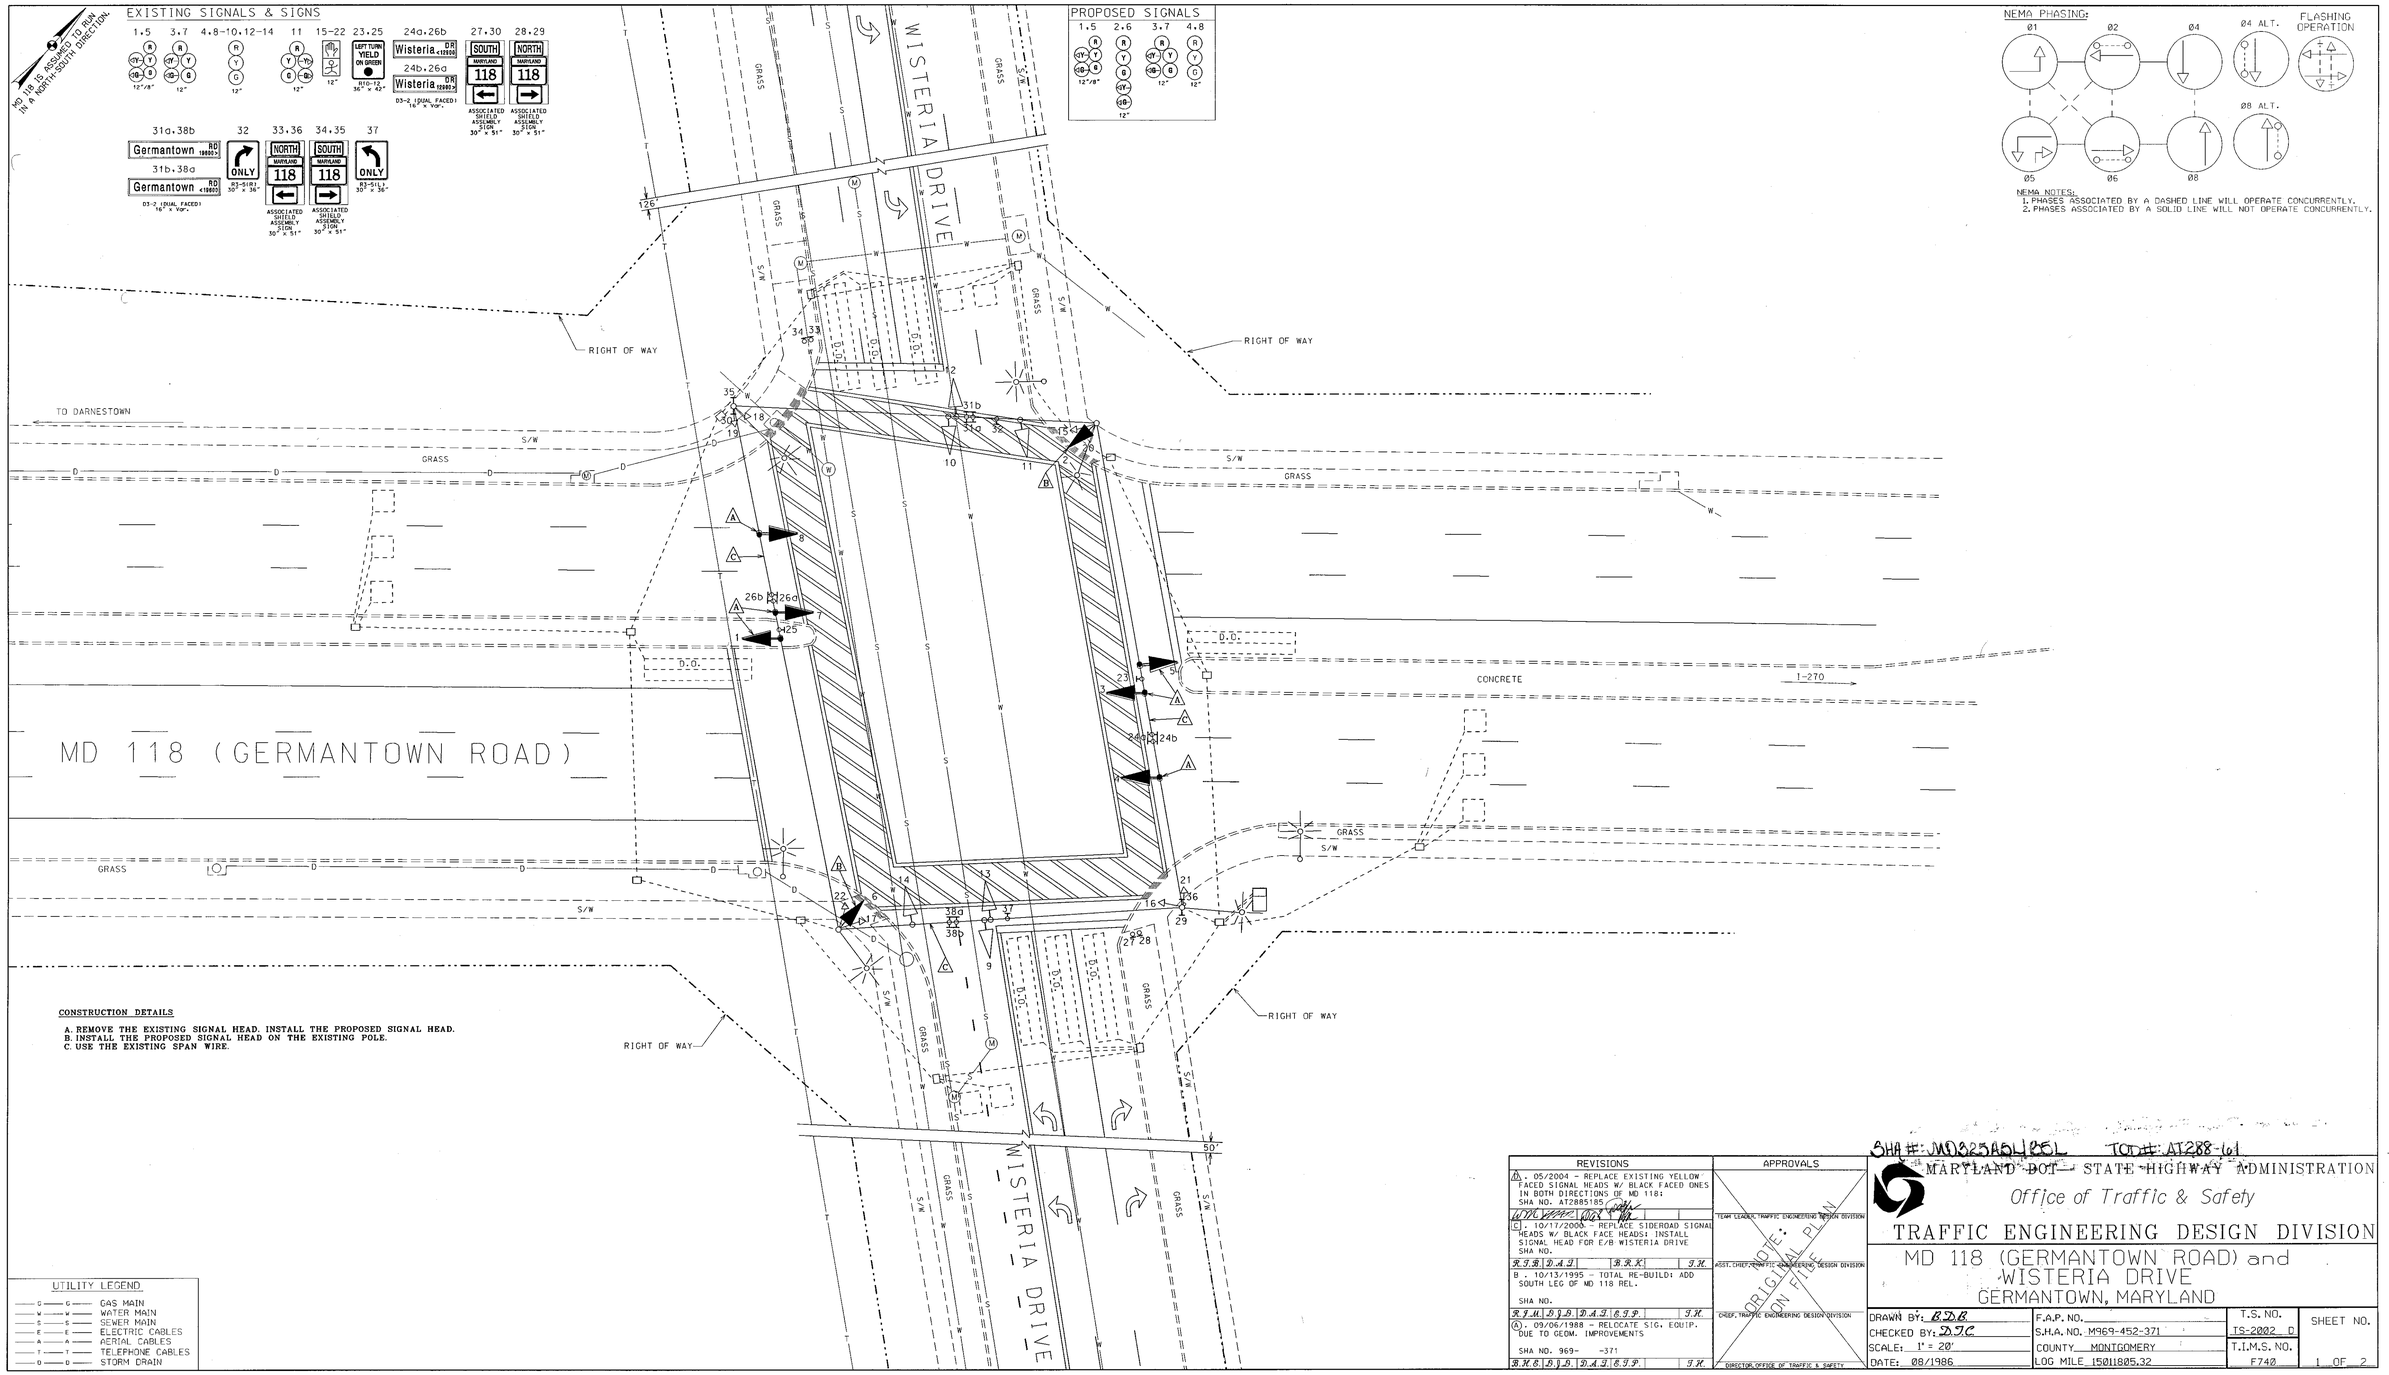

CONSTRUCTION DETAILS

A. REMOVE THE EXISTING SIGNAL HEAD. INSTALL THE PROPOSED SIGNAL HEAD.
B. INSTALL THE PROPOSED SIGNAL HEAD ON THE EXISTING POLE.
C. USE THE EXISTING SPAN WIRE.

UTILITY LEGEND

G — G	GAS MAIN
W — W	WATER MAIN
S — S	SEWER MAIN
E — E	ELECTRIC CABLES
A — A	AERIAL CABLES
T — T	TELEPHONE CABLES
D — D	STORM DRAIN

REVISIONS	APPROVALS
D. 05/2004 - REPLACE EXISTING YELLOW FACED SIGNAL HEADS W/ BLACK FACED ONES IN BOTH DIRECTIONS OF MD 118: SHA NO. AT2885185	TEAM LEADER, TRAFFIC ENGINEERING DESIGN DIVISION
C. 10/17/2000 - REPLACE SIDEROAD SIGNAL HEADS W/ BLACK FACE HEADS: INSTALL SIGNAL HEAD FOR E/B WISTERIA DRIVE SHA NO. K.J.B. D.A.J. B.K.K. S.H.	ASST. CHIEF, TRAFFIC ENGINEERING DESIGN DIVISION
B. 10/13/1995 - TOTAL RE-BUILD: ADD SOUTH LEG OF MD 118 REL. SHA NO. R.J.W. B.S.S. D.A.J. E.T.P. S.H.	CHIEF, TRAFFIC ENGINEERING DESIGN DIVISION
A. 09/06/1988 - RELOCATE SIG. EQUIP. DUE TO GEOM. IMPROVEMENTS SHA NO. 969- -371 B.K.K. B.S.S. D.A.J. E.T.P. S.H.	DIRECTOR, OFFICE OF TRAFFIC & SAFETY

NOTE: ORIGINAL PLAN ON FILE

SHA #: MD325A&D,L&S,L TOD #: AT288-61

MARYLAND DEPT. OF TRANSPORTATION — STATE HIGHWAY ADMINISTRATION

Office of Traffic & Safety

TRAFFIC ENGINEERING DESIGN DIVISION

MD 118 (GERMANTOWN ROAD) and WISTERIA DRIVE
GERMANTOWN, MARYLAND

DRAWN BY: B.D.B.	F.A.P. NO.	T.S. NO. TS-2002 D	SHEET NO.
CHECKED BY: D.J.C.	S.H.A. NO. M969-452-371		
SCALE: 1" = 20'	COUNTY MONTGOMERY	T.I.M.S. NO. F740	1 OF 2
DATE: 08/1986	LOG MILE 15011805.32		