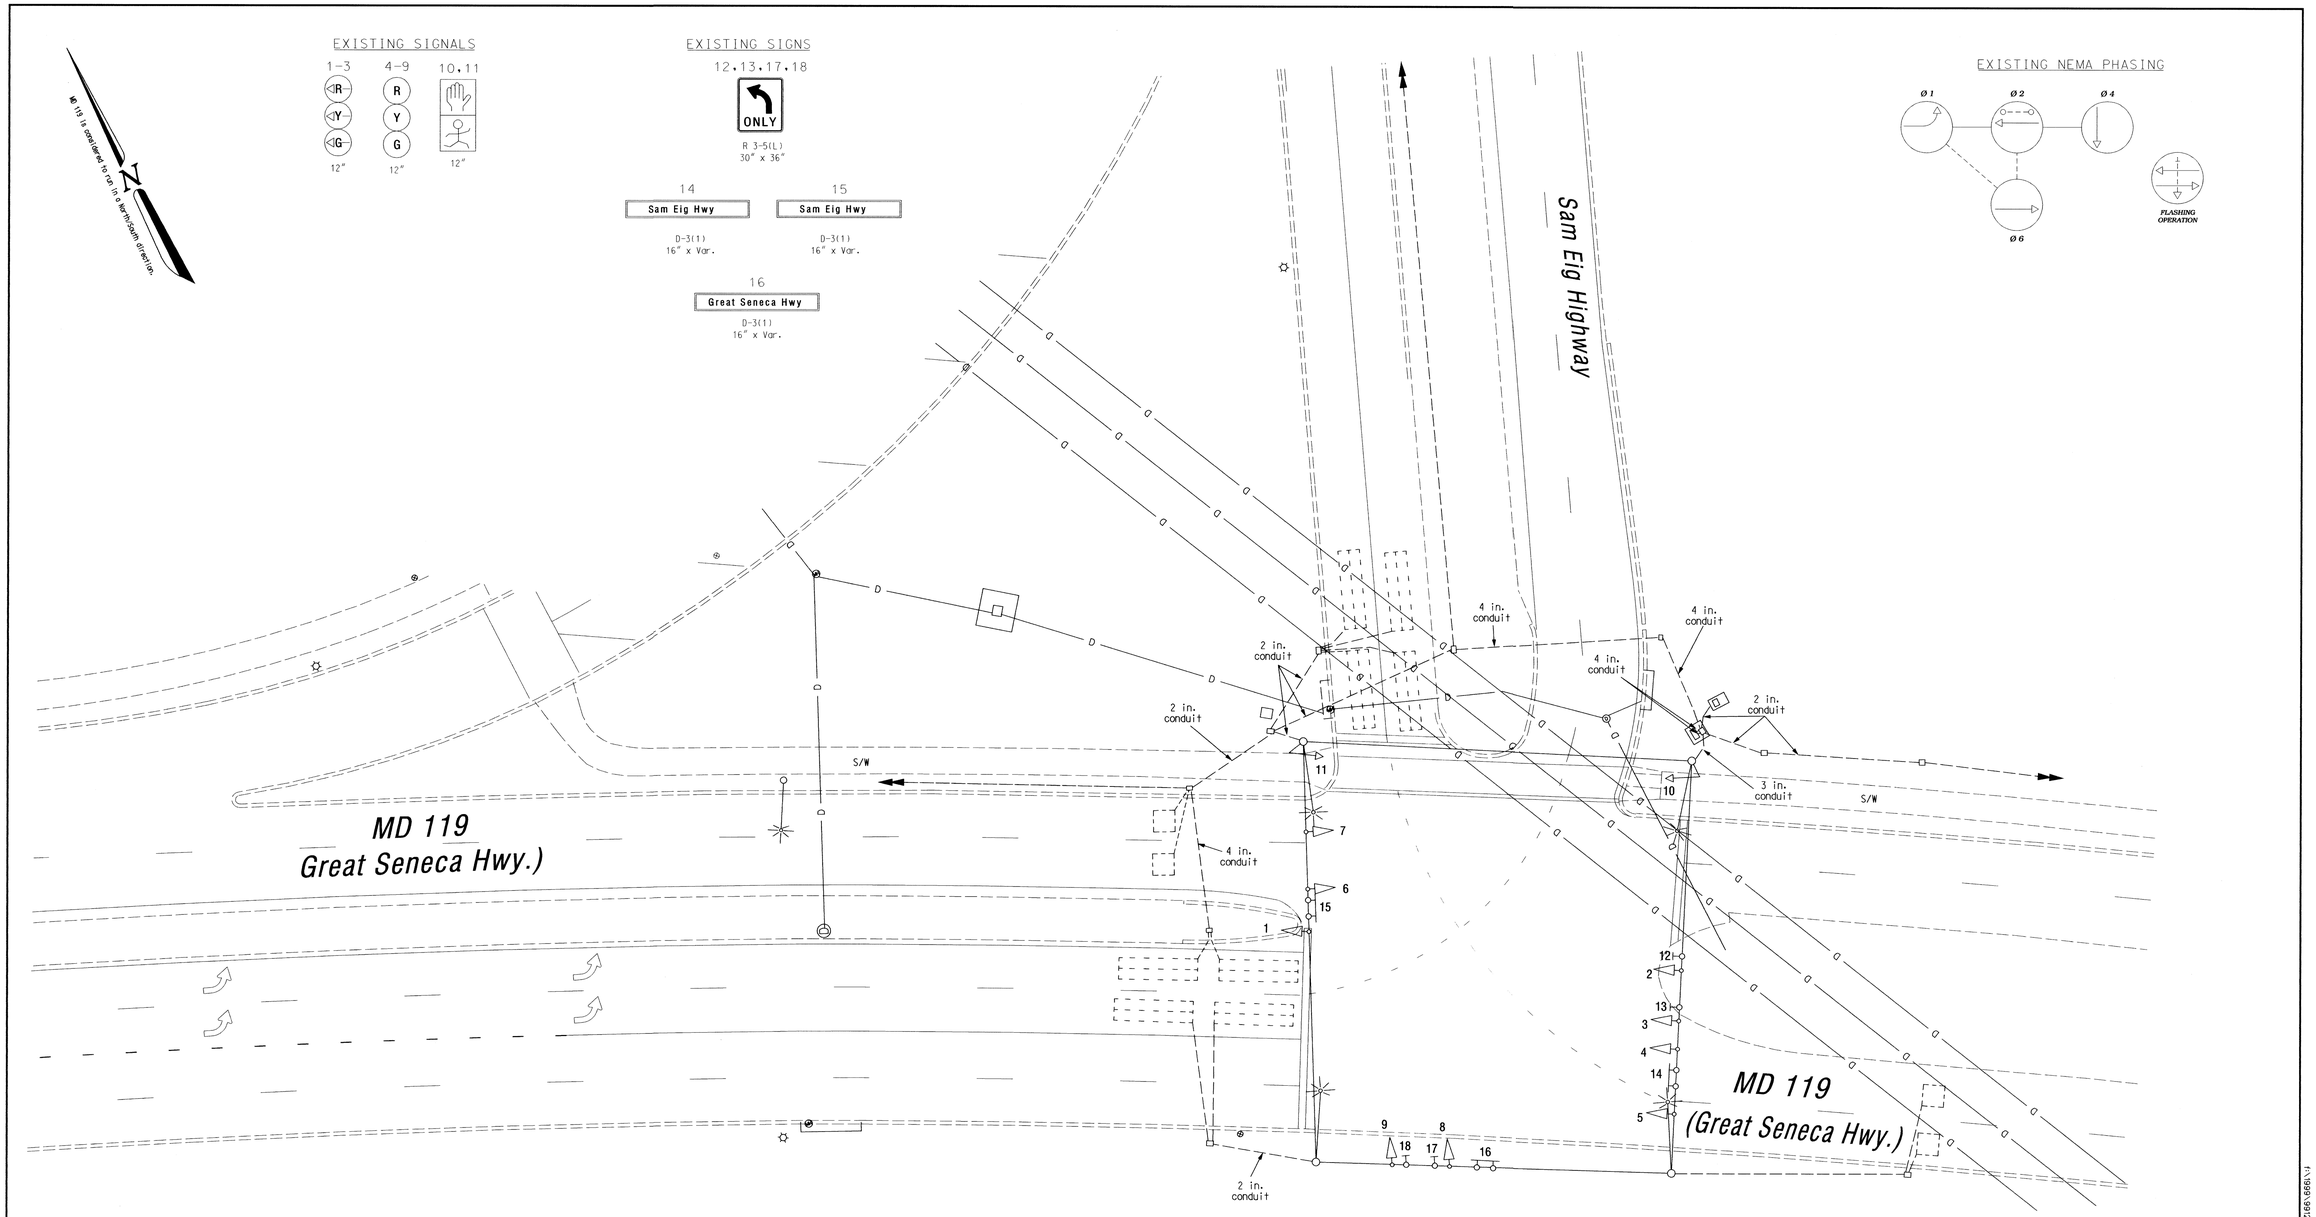

GEOMETRIC LEGEND

EXISTING GEOMETRICS

PROPOSED GEOMETRICS

UTILITY LEGEND

G	GAS MAIN
W	WATER MAIN
S	SEWER MAIN
E	ELECTRIC CABLES
D	STORM DRAIN
A	AERIAL CABLES
T	TELEPHONE CABLES

"As-Built"

The Traffic Group

The Traffic Group, Inc.
410-931-6600
Fax 410-931-6601

REVISIONS

"As-Built" January 2, 2002
S.H.A. No.:BW996M82
rmd

Install new loop and modify signal heads. December 14, 2000
S.H.A. No.:BW996M82
fjh

APPROVALS

TEAM LEADER, TRAFFIC ENGINEERING DESIGN DIVISION

ASST. CHIEF TRAFFIC ENGINEERING DESIGN DIVISION

CHIEF, TRAFFIC ENGINEERING DESIGN DIVISION

DIRECTOR, TRAFFIC & SAFETY

MARYLAND DOT - STATE HIGHWAY ADMINISTRATION
Office of Traffic & Safety
TRAFFIC ENGINEERING DESIGN DIVISION
(Traffic Signal Plan)

MD 119 (Great Senenca Highway) at Sam Eig Highway

DRAWN BY:	CAS	F.A.P. NO.	N/A	TS NO. 4059	SHEET NO.
CHECKED BY:	KLT	S.H.A. NO.			
SCALE:	1" = 20'	COUNTY:	Montgomery	T.I.M.S. NO. E127	1 OF 1
DATE:	March, 1998	LOG MILE:			

f:\1999\991210\des\updatejan2002\ab-plan4.dgn 08 FEB 2002