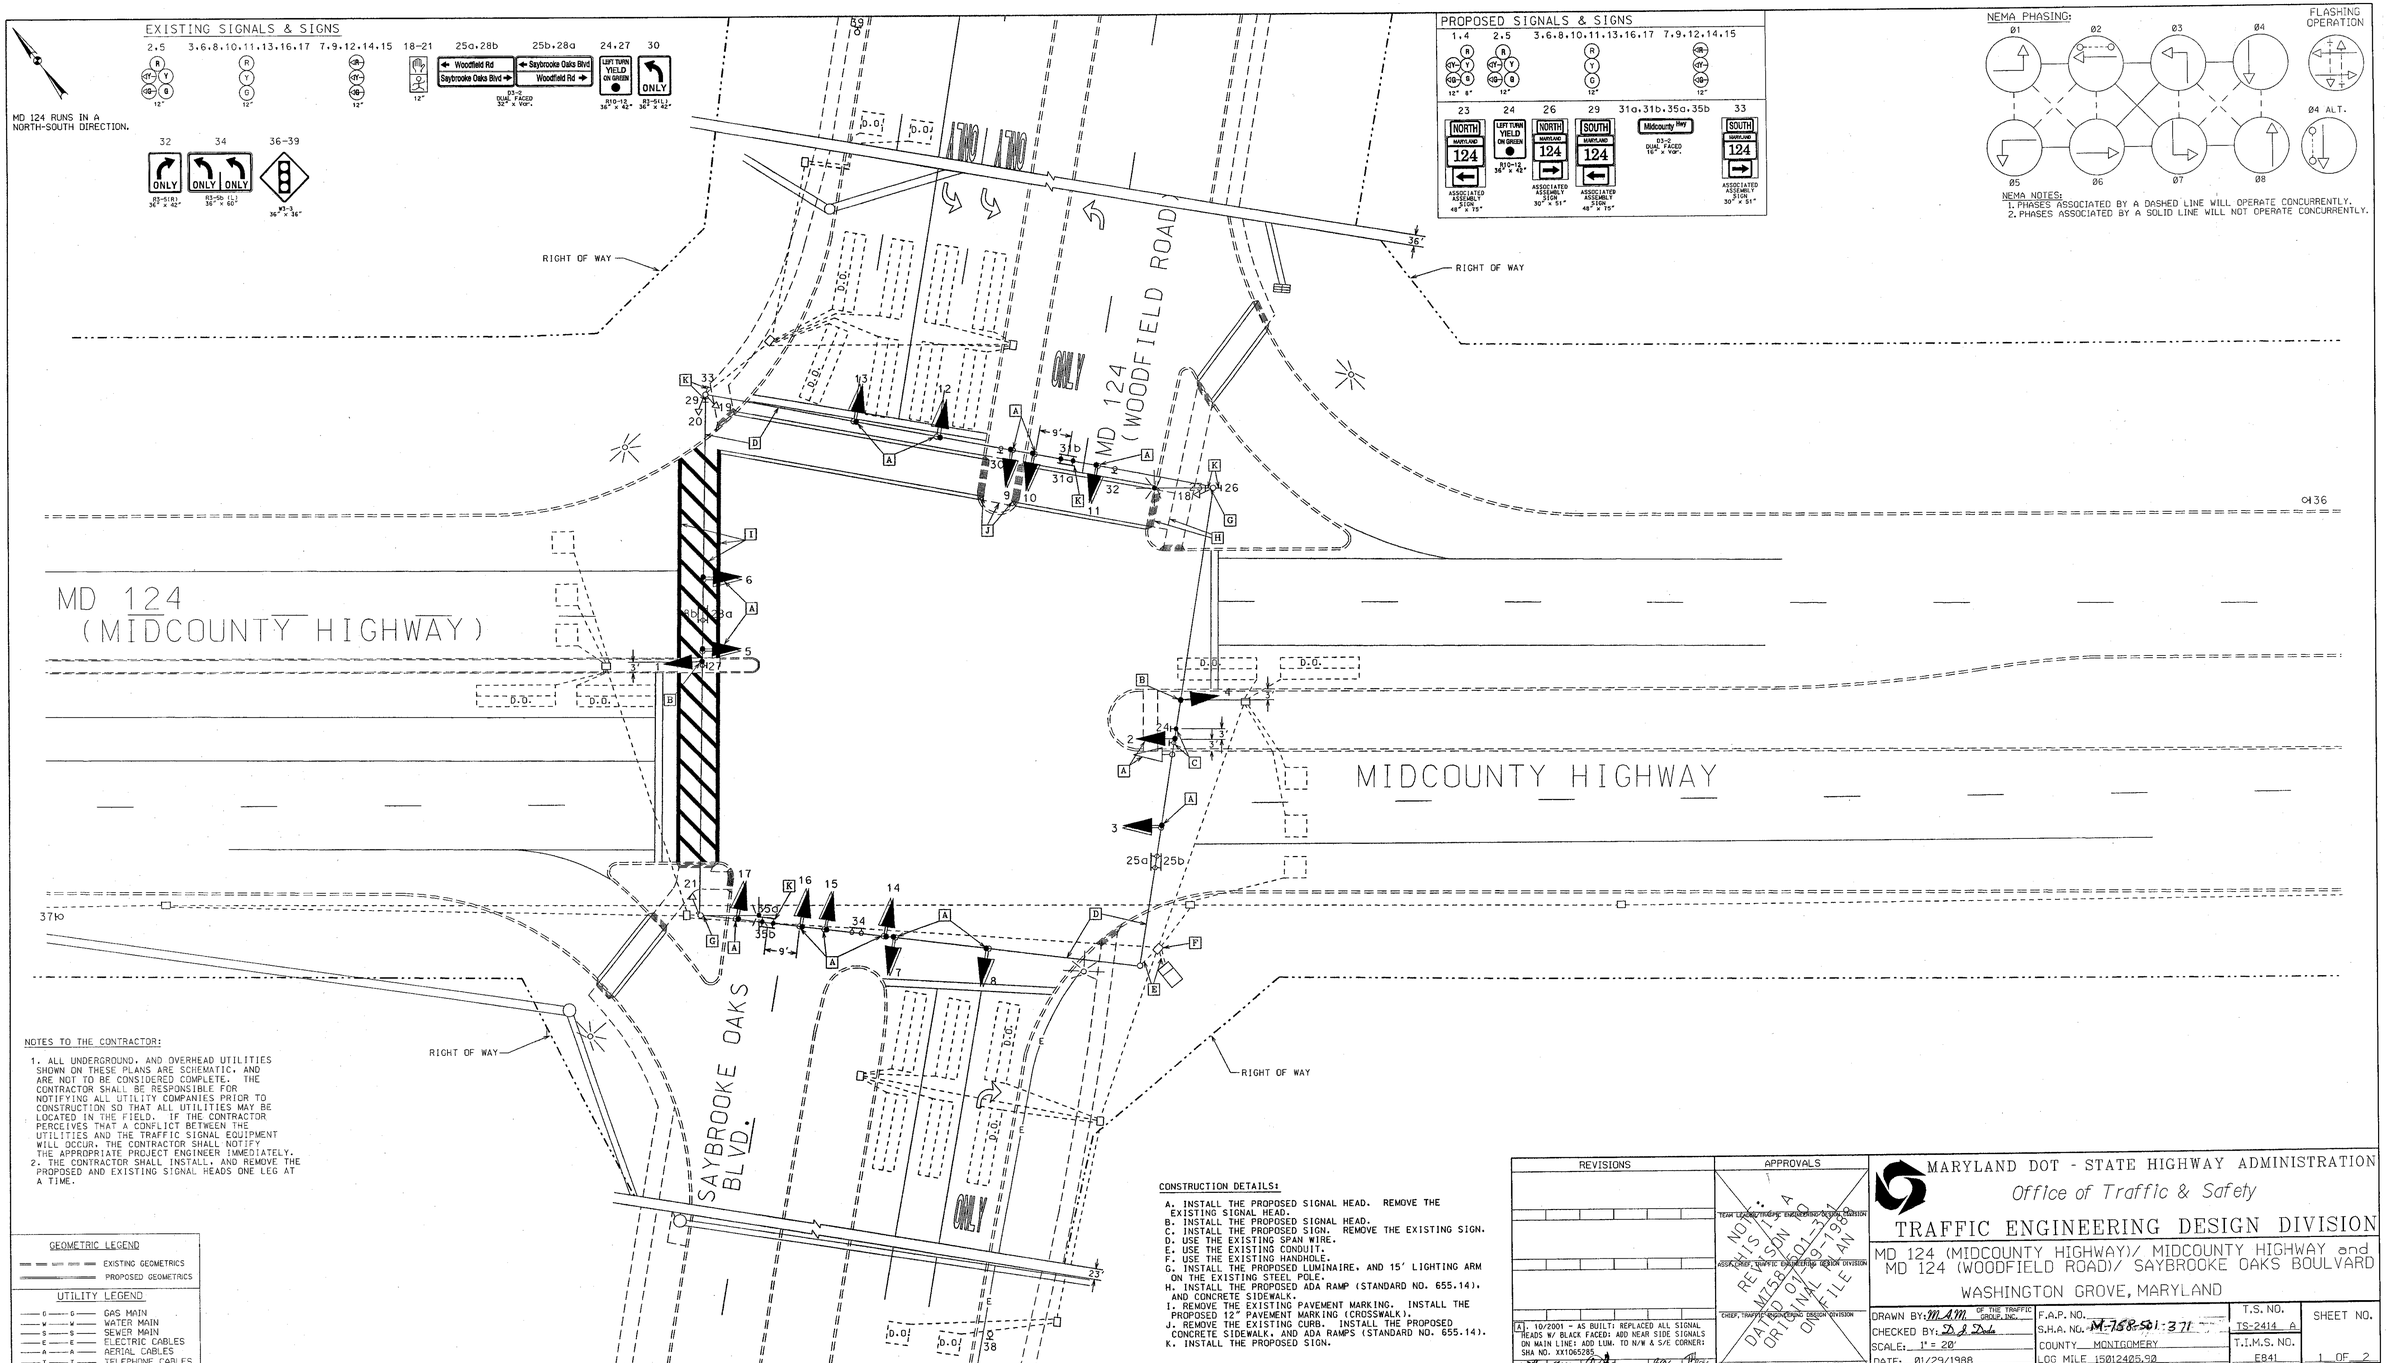

NOTES TO THE CONTRACTOR:

1. ALL UNDERGROUND, AND OVERHEAD UTILITIES SHOWN ON THESE PLANS ARE SCHEMATIC, AND ARE NOT TO BE CONSIDERED COMPLETE. THE CONTRACTOR SHALL BE RESPONSIBLE FOR NOTIFYING ALL UTILITY COMPANIES PRIOR TO CONSTRUCTION SO THAT ALL UTILITIES MAY BE LOCATED IN THE FIELD. IF THE CONTRACTOR PERCEIVES THAT A CONFLICT BETWEEN THE UTILITIES AND THE TRAFFIC SIGNAL EQUIPMENT WILL OCCUR, THE CONTRACTOR SHALL NOTIFY THE APPROPRIATE PROJECT ENGINEER IMMEDIATELY.
2. THE CONTRACTOR SHALL INSTALL, AND REMOVE THE PROPOSED AND EXISTING SIGNAL HEADS ONE LEG AT A TIME.

GEOMETRIC LEGEND

- EXISTING GEOMETRICS
- PROPOSED GEOMETRICS

UTILITY LEGEND

- G — GAS MAIN
- W — WATER MAIN
- S — SEWER MAIN
- E — ELECTRIC CABLES
- A — AERIAL CABLES
- T — TELEPHONE CABLES
- D — STORM DRAIN

CONSTRUCTION DETAILS:

A. INSTALL THE PROPOSED SIGNAL HEAD. REMOVE THE EXISTING SIGNAL HEAD.
B. INSTALL THE PROPOSED SIGNAL HEAD.
C. INSTALL THE PROPOSED SIGN. REMOVE THE EXISTING SIGN.
D. USE THE EXISTING SPAN WIRE.
E. USE THE EXISTING CONDUIT.
F. USE THE EXISTING HANDHOLE.
G. INSTALL THE PROPOSED LUMINAIRE, AND 15' LIGHTING ARM ON THE EXISTING STEEL POLE.
H. INSTALL THE PROPOSED ADA RAMP (STANDARD NO. 655.14), AND CONCRETE SIDEWALK.
I. REMOVE THE EXISTING PAVEMENT MARKING. INSTALL THE PROPOSED 12" PAVEMENT MARKING (CROSSWALK).
J. REMOVE THE EXISTING CURB. INSTALL THE PROPOSED CONCRETE SIDEWALK, AND ADA RAMPS (STANDARD NO. 655.14).
K. INSTALL THE PROPOSED SIGN.

REVISIONS	APPROVALS
A. 10/2001 - AS BUILT: REPLACED ALL SIGNAL HEADS W/ BLACK FACED; ADD NEAR SIDE SIGNALS ON MAIN LINE; ADD LUM. TO N/W & S/E CORNER; SHA NO. XX1065285	TEAM LEADER, TRAFFIC ENGINEERING DESIGN DIVISION; ASSIST. CHIEF, TRAFFIC ENGINEERING DESIGN DIVISION; CHIEF, TRAFFIC ENGINEERING DESIGN DIVISION; DIRECTOR, OFFICE OF TRAFFIC & SAFETY

NOT IN A REVISION TO MTSB 01-31-90 DATED 07-09-90 ORIGINAL AN ON FILE

MARYLAND DOT - STATE HIGHWAY ADMINISTRATION

Office of Traffic & Safety

TRAFFIC ENGINEERING DESIGN DIVISION

MD 124 (MIDCOUNTY HIGHWAY)/ MIDCOUNTY HIGHWAY and MD 124 (WOODFIELD ROAD)/ SAYBROOKE OAKS BOULVARD

WASHINGTON GROVE, MARYLAND

DRAWN BY: M.A.M. OF THE TRAFFIC GROUP, INC.	F.A.P. NO.	T.S. NO.	SHEET NO.
CHECKED BY: D.J. Dada	S.H.A. NO. M-158-501:371	TS-2414 A	
SCALE: 1" = 20'	COUNTY MONTGOMERY	T.I.M.S. NO.	
DATE: 01/29/1988	LOG MILE 15012425.90	E841	1 OF 2