K&E 19 1153 6-81 MC 2647

F.H.W.A. REGION NO.	STATE	FED. AID PROJ. NO.	SHEET NO.	TOTAL SHEETS
3	MD.		4	13

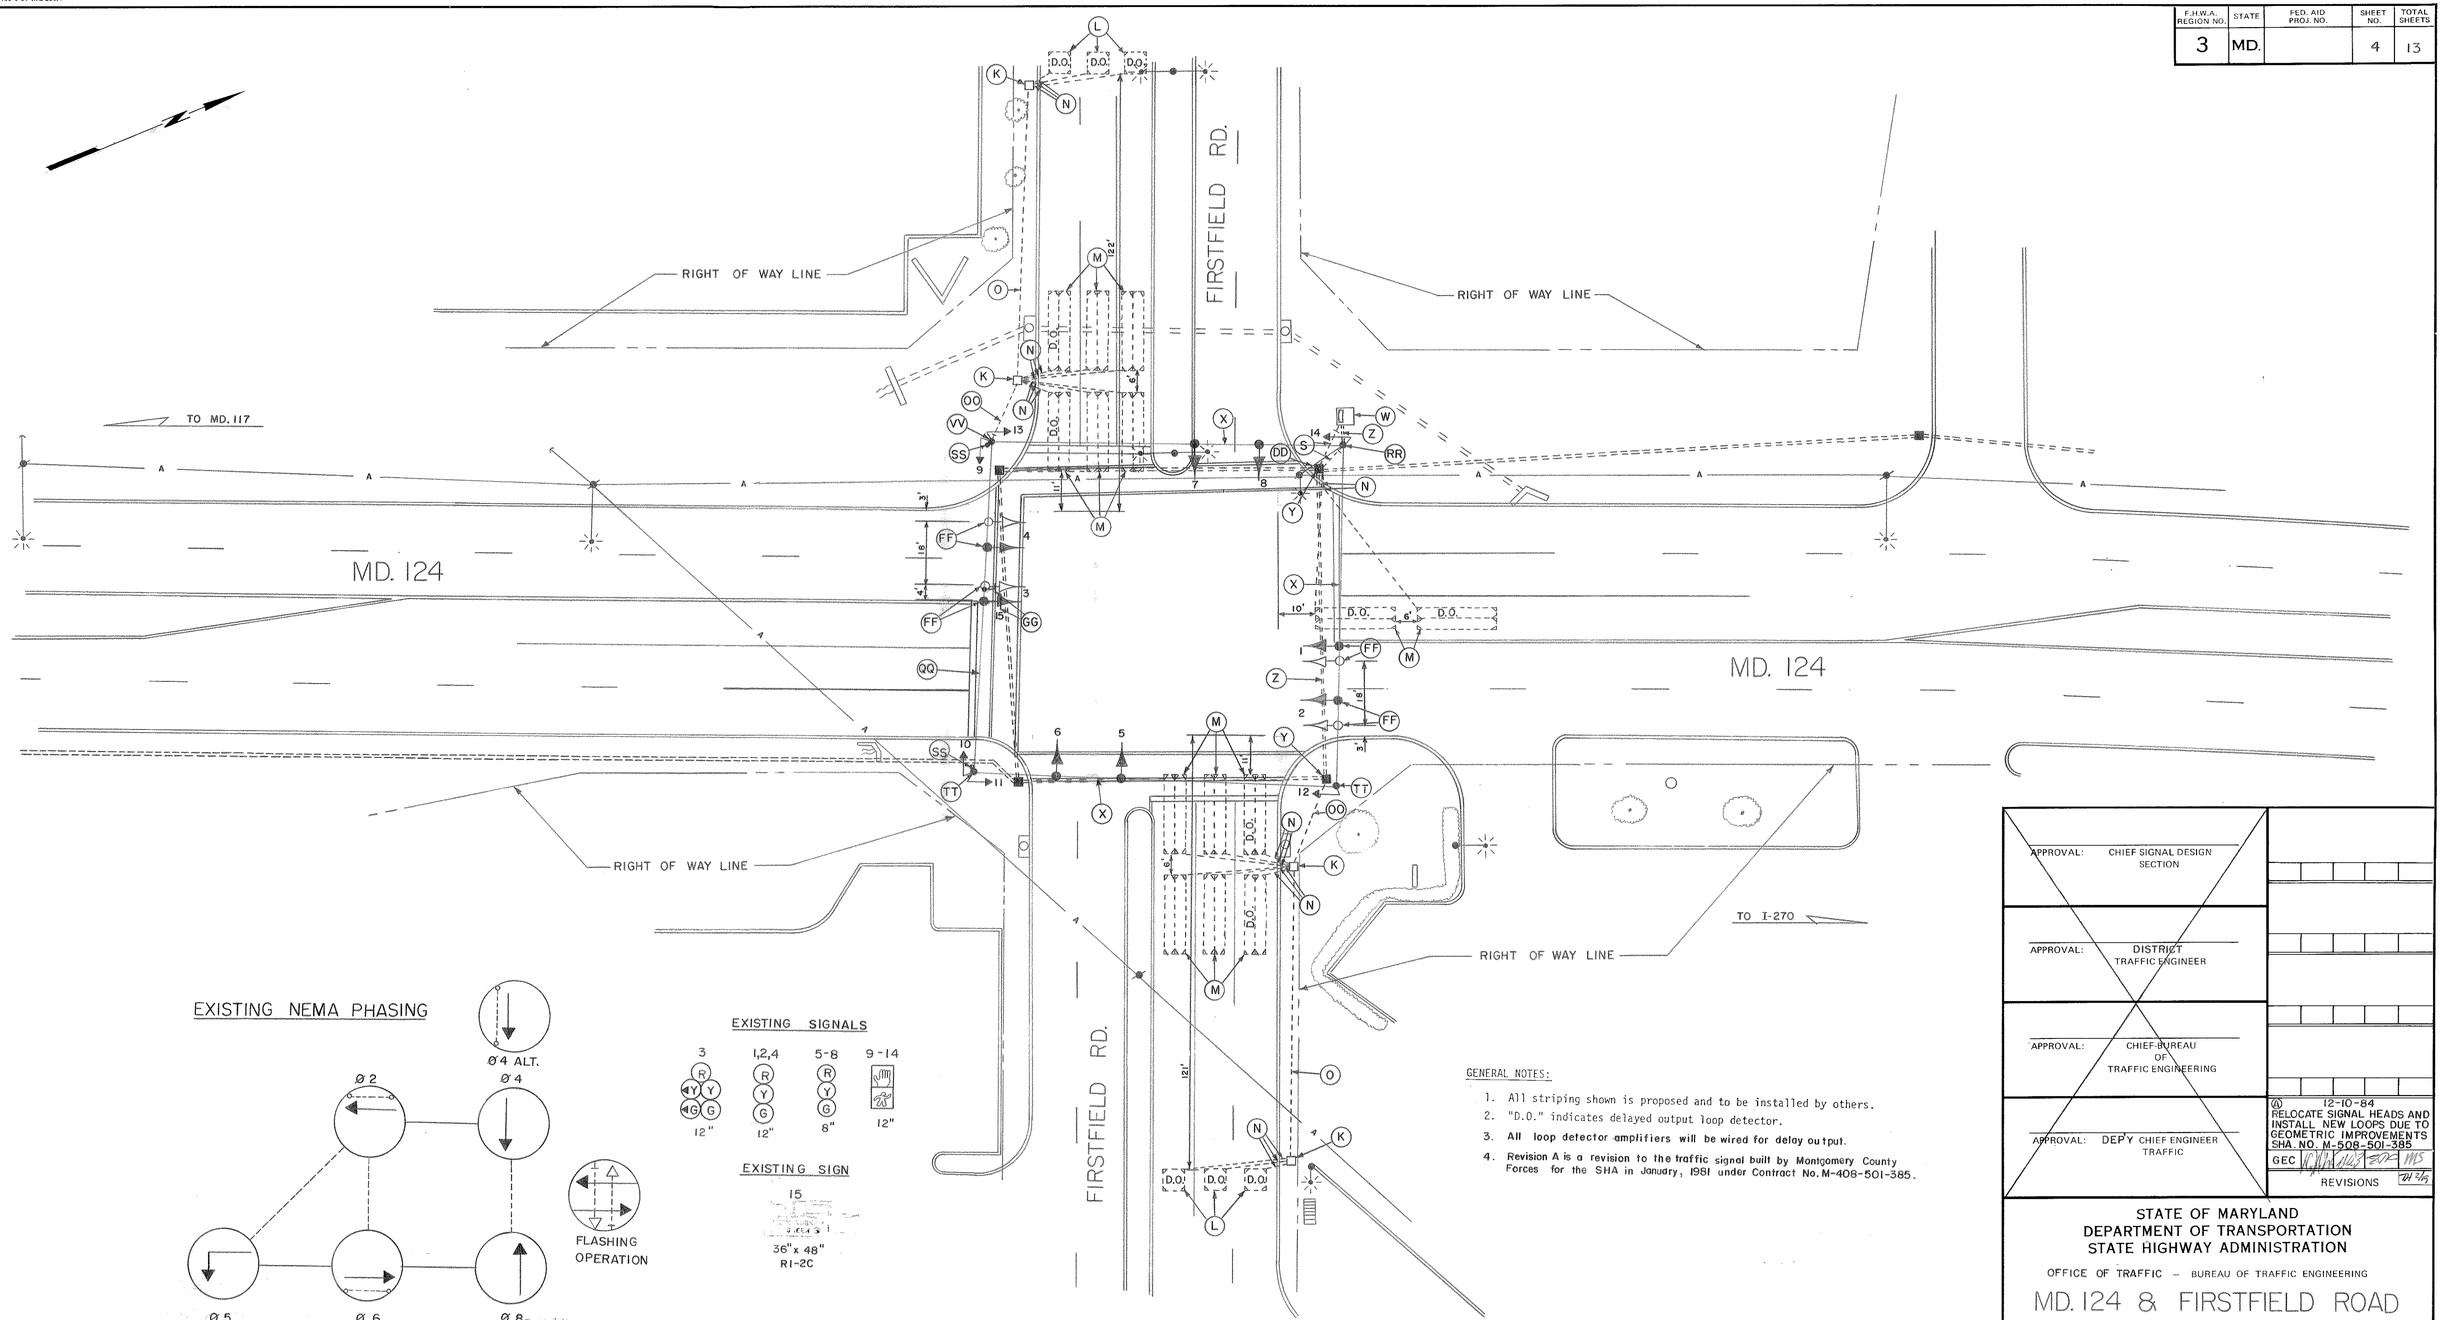

APPROVAL: CHIEF SIGNAL DESIGN SECTION

APPROVAL: DISTRICT TRAFFIC ENGINEER

APPROVAL: CHIEF-BUREAU OF TRAFFIC ENGINEERING

APPROVAL: DEPY CHIEF ENGINEER TRAFFIC

(A) 12-10-84
RELOCATE SIGNAL HEADS AND INSTALL NEW LOOPS DUE TO GEOMETRIC IMPROVEMENTS
SHA. NO. M-508-501-385
GEC
REVISIONS

STATE OF MARYLAND
DEPARTMENT OF TRANSPORTATION
STATE HIGHWAY ADMINISTRATION

OFFICE OF TRAFFIC – BUREAU OF TRAFFIC ENGINEERING

MD. 124 & FIRSTFIELD ROAD (PROPOSED GEOMETRICS)

SCALE 1" = 20' | DATE 5/26/80 | CONTRACT NO. M-408-501-385

DRAWN BY: JWG | COUNTY: MONTGOMERY

DESIGNED BY: JWG | SIGNAL NO.:

CHECKED BY:

DRAWING NO. TS-1776A

STREET TRAFFIC STUDIES, LTD.
Suite 295, Commercentre East
1771 Reisterstown Road
Baltimore, MD 21208