K&E 19 1153 6-81 MC 2647

F.H.W.A. REGION NO.	STATE	FED. AID PROJ. NO.	SHEET NO.	TOTAL SHEETS
3	MD.		5	13

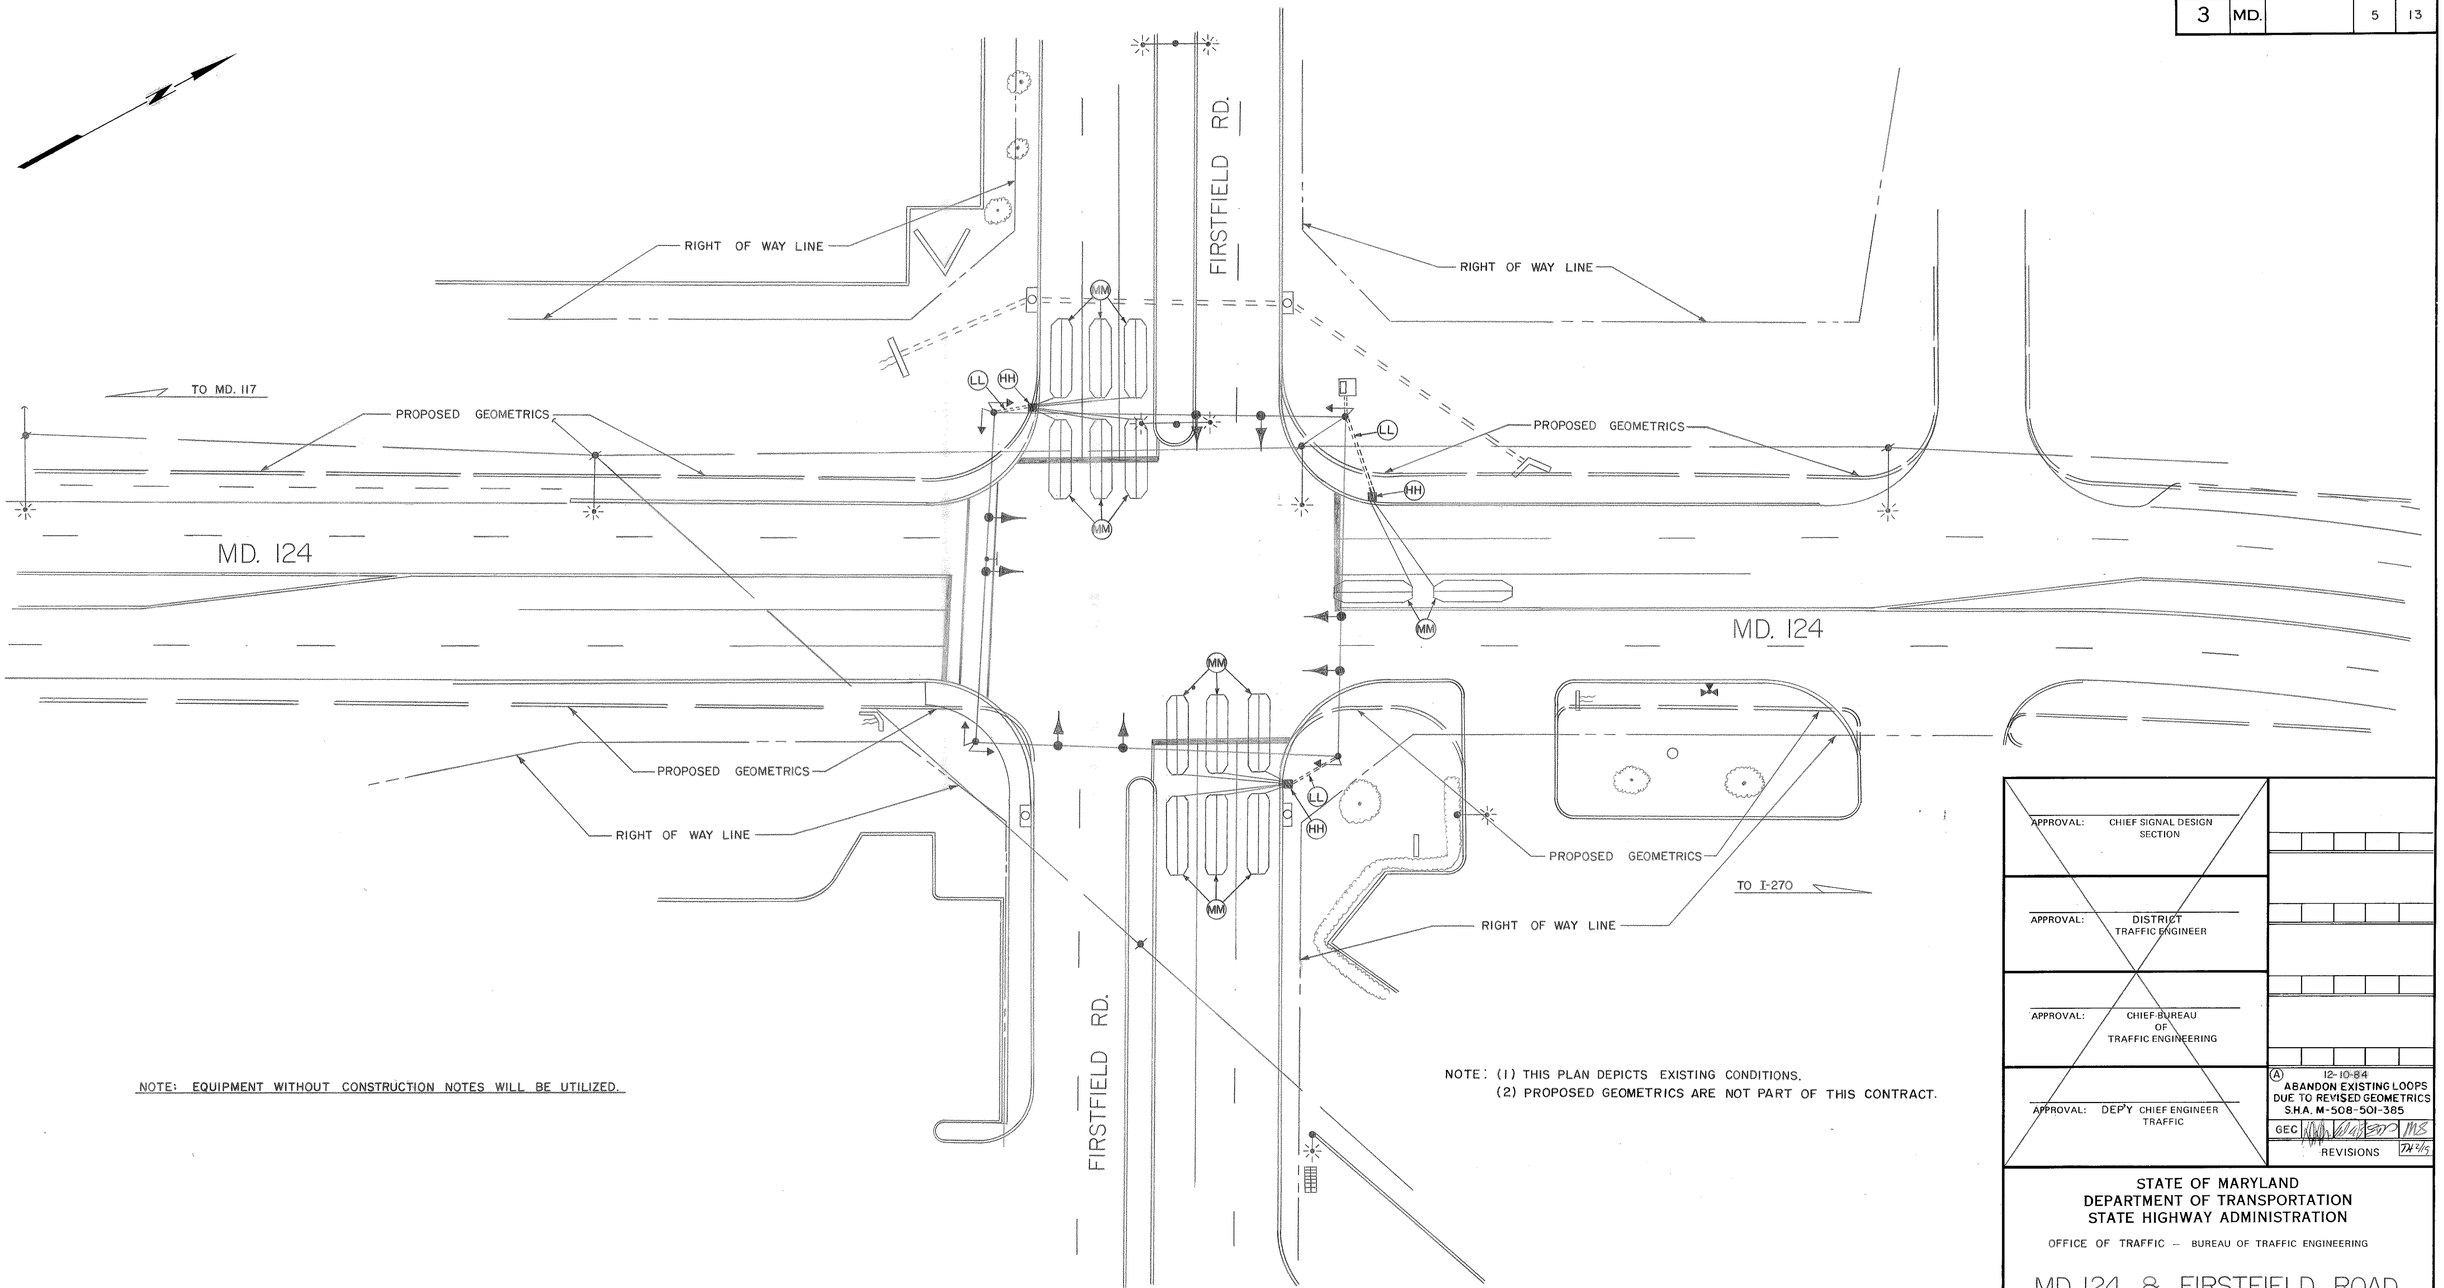

NOTE: EQUIPMENT WITHOUT CONSTRUCTION NOTES WILL BE UTILIZED.

NOTE: (1) THIS PLAN DEPICTS EXISTING CONDITIONS.
(2) PROPOSED GEOMETRICS ARE NOT PART OF THIS CONTRACT.

APPROVAL: CHIEF SIGNAL DESIGN SECTION

APPROVAL: DISTRICT TRAFFIC ENGINEER

APPROVAL: CHIEF BUREAU OF TRAFFIC ENGINEERING

APPROVAL: DEPY CHIEF ENGINEER TRAFFIC

(A) 12-10-84
ABANDON EXISTING LOOPS DUE TO REVISED GEOMETRICS
S.H.A. M-508-501-385

GEC MB

REVISIONS

STATE OF MARYLAND
DEPARTMENT OF TRANSPORTATION
STATE HIGHWAY ADMINISTRATION

OFFICE OF TRAFFIC – BUREAU OF TRAFFIC ENGINEERING

MD. 124 & FIRSTFIELD ROAD

SCALE 1" = 20' DATE 5-26-80 CONTRACT NO. M-408-501-385

DRAWN BY: JWG COUNTY: MONTGOMERY

DESIGNED BY: JWG SIGNAL NO.:

CHECKED BY:

DRAWING NO. TS-1776AX

STREET TRAFFIC STUDIES, LTD.
Suite 295, Commercentre East
1777 Reisterstown Road
Baltimore, MD 21208