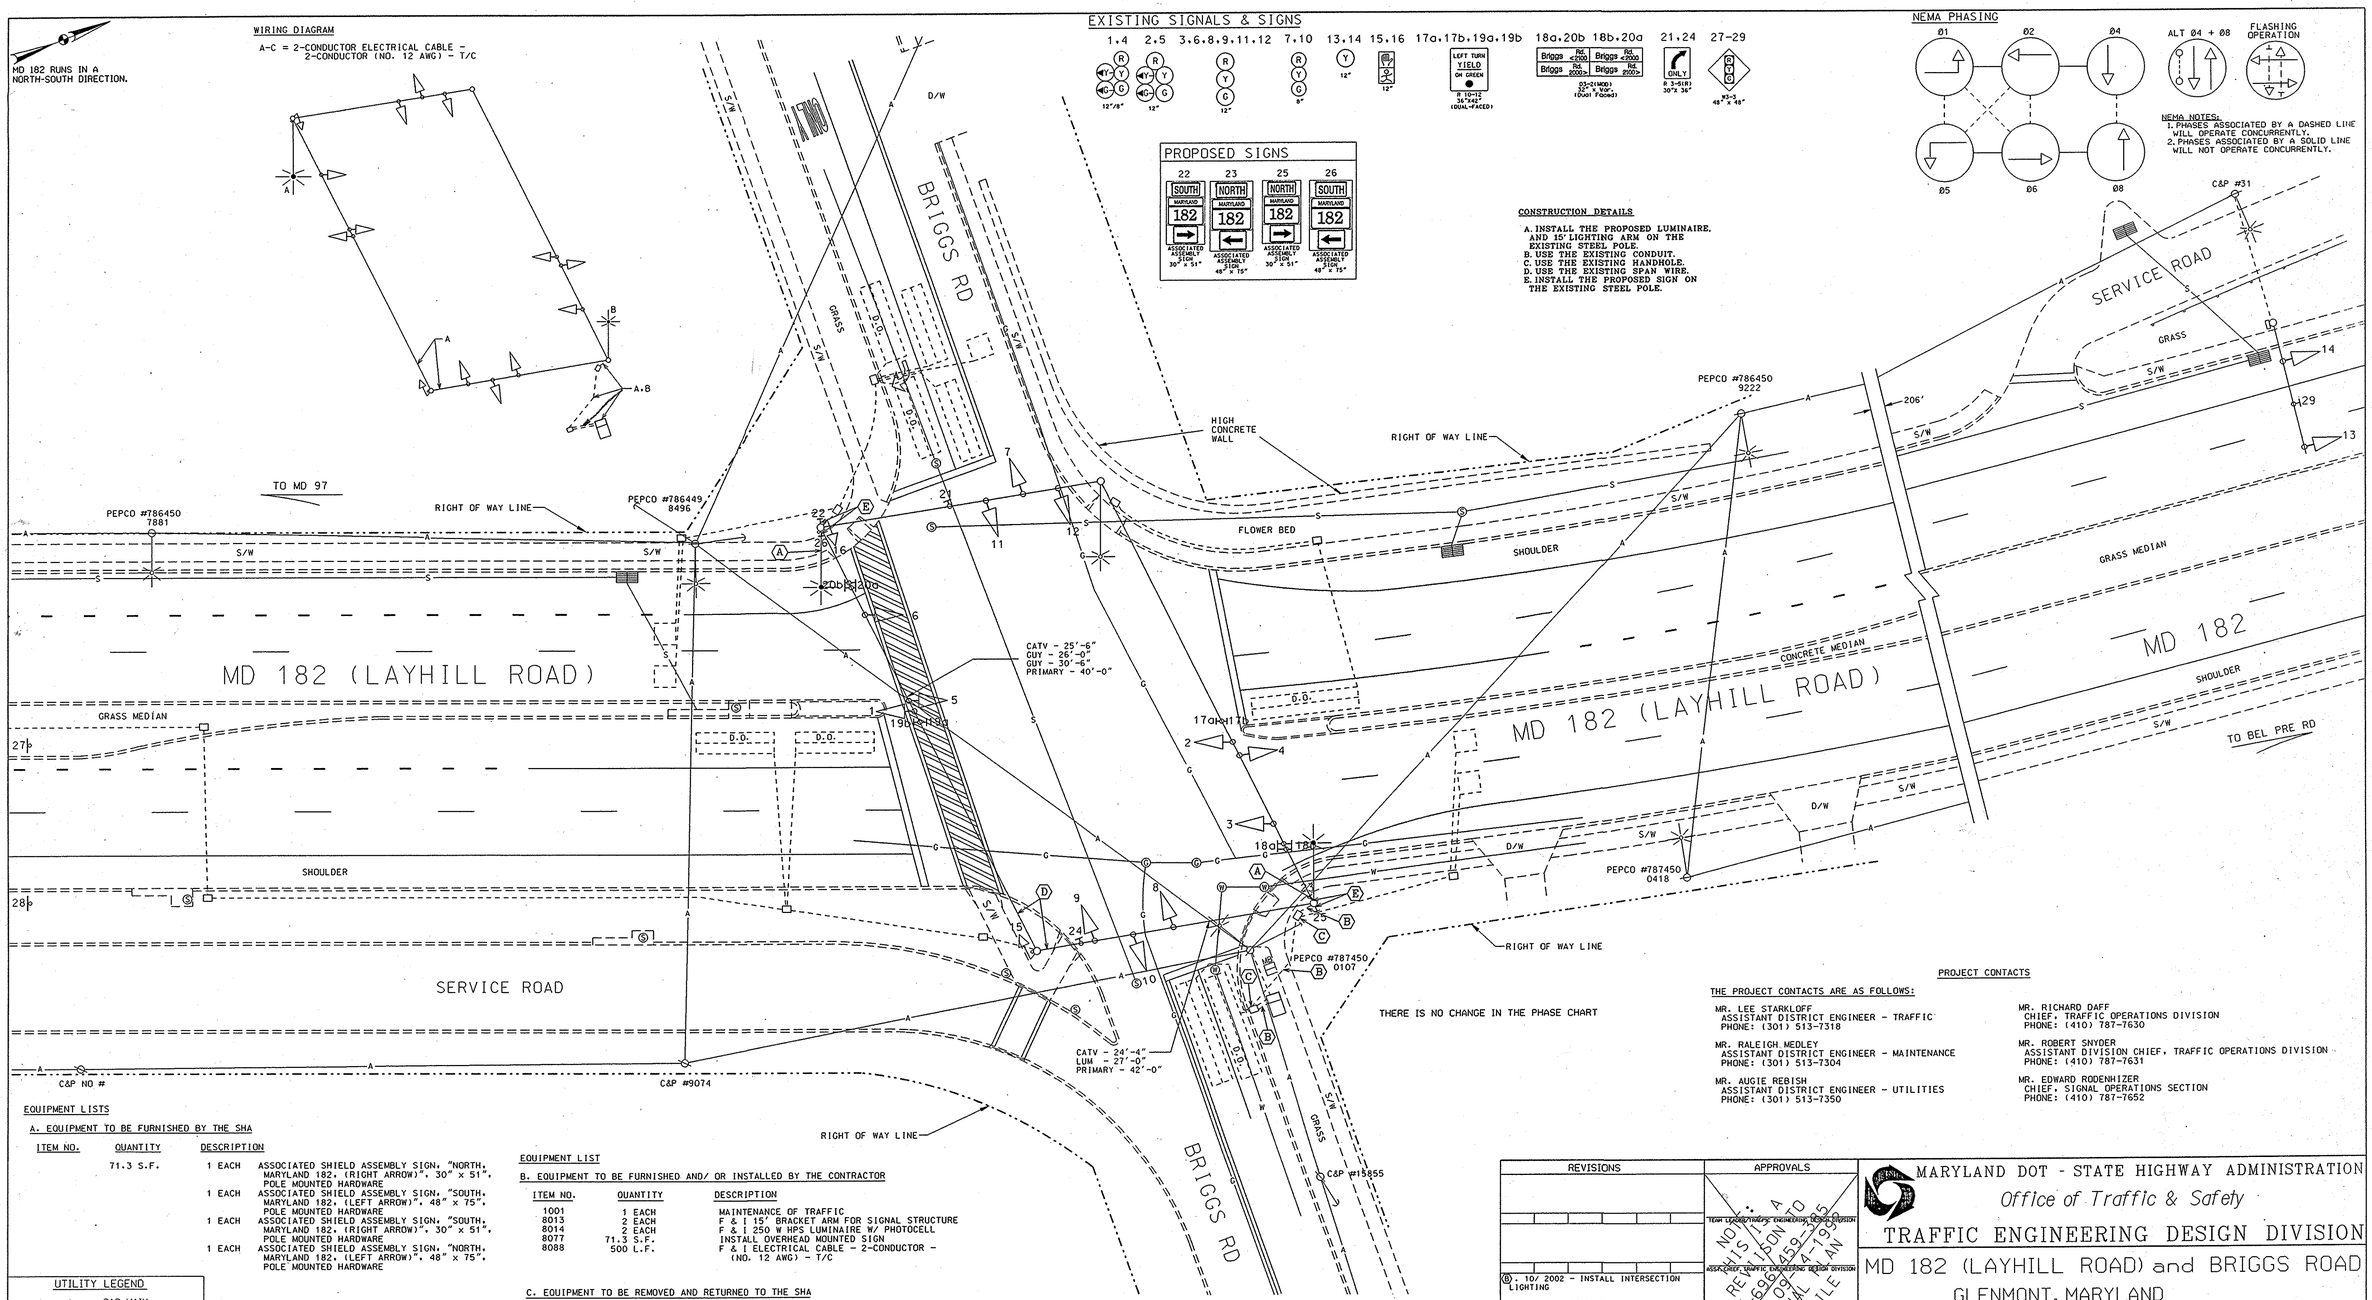

EQUIPMENT LISTS

A. EQUIPMENT TO BE FURNISHED BY THE SHA

ITEM NO.	QUANTITY	DESCRIPTION
	71.3 S.F.	
	1 EACH	ASSOCIATED SHIELD ASSEMBLY SIGN. "NORTH. MARYLAND 182. (RIGHT ARROW)". 30" x 51". POLE MOUNTED HARDWARE
	1 EACH	ASSOCIATED SHIELD ASSEMBLY SIGN. "SOUTH. MARYLAND 182. (LEFT ARROW)". 48" x 75". POLE MOUNTED HARDWARE
	1 EACH	ASSOCIATED SHIELD ASSEMBLY SIGN. "SOUTH. MARYLAND 182. (RIGHT ARROW)". 30" x 51". POLE MOUNTED HARDWARE
	1 EACH	ASSOCIATED SHIELD ASSEMBLY SIGN. "NORTH. MARYLAND 182. (LEFT ARROW)". 48" x 75". POLE MOUNTED HARDWARE

EQUIPMENT LIST

B. EQUIPMENT TO BE FURNISHED AND/ OR INSTALLED BY THE CONTRACTOR

ITEM NO.	QUANTITY	DESCRIPTION
1001	1 EACH	MAINTENANCE OF TRAFFIC
8013	2 EACH	F & I 15' BRACKET ARM FOR SIGNAL STRUCTURE
8014	2 EACH	F & I 250 W HPS LUMINAIRE W/ PHOTOCELL
8077	71.3 S.F.	INSTALL OVERHEAD MOUNTED SIGN
8088	500 L.F.	F & I ELECTRICAL CABLE - 2-CONDUCTOR - (NO. 12 AWG) - T/C

C. EQUIPMENT TO BE REMOVED AND RETURNED TO THE SHA

ITEM NO.	QUANTITY	DESCRIPTION

ALL REMOVED SIGNAL MATERIALS ARE TO BECOME THE PROPERTY OF THE CONTRACTOR

UTILITY LEGEND

—G—G—	GAS MAIN
—W—W—	WATER MAIN
—S—S—	SEWER MAIN
—E—E—	ELECTRIC CABLES
—A—A—	AERIAL CABLES
—T—T—	TELEPHONE CABLES
—D—D—	STORM DRAIN
—TV—TV—	CABLE TV

PROJECT CONTACTS

THE PROJECT CONTACTS ARE AS FOLLOWS:

MR. LEE STARKLOFF
ASSISTANT DISTRICT ENGINEER - TRAFFIC
PHONE: (301) 513-7318

MR. RALEIGH MEDLEY
ASSISTANT DISTRICT ENGINEER - MAINTENANCE
PHONE: (301) 513-7304

MR. AUGIE REBISH
ASSISTANT DISTRICT ENGINEER - UTILITIES
PHONE: (301) 513-7350

MR. RICHARD DAFF
CHIEF, TRAFFIC OPERATIONS DIVISION
PHONE: (410) 787-7630

MR. ROBERT SNYDER
ASSISTANT DIVISION CHIEF, TRAFFIC OPERATIONS DIVISION
PHONE: (410) 787-7631

MR. EDWARD RODENHIZER
CHIEF, SIGNAL OPERATIONS SECTION
PHONE: (410) 787-7652

REVISIONS	APPROVALS
B. 10/ 2002 - INSTALL INTERSECTION LIGHTING SHA NO. XX1065285 W.H. J.D.S.	TEAM LEADER/TRAFFIC ENGINEERING DESIGN DIVISION ASST. CHIEF, TRAFFIC ENGINEERING DESIGN DIVISION CHIEF, TRAFFIC ENGINEERING DESIGN DIVISION DIRECTOR, OFFICE OF TRAFFIC & SAFETY
A. 08/2002 - REPLACED DAMAGED LOOP DETECTORS F/ THE MD 182 S/B L.T. & W/B BRIGGS ROAD: SHA NO. 01-2000 (M0925854) W.H. J.D.S. D.J.S. S.R.K.	NOTE: A REVISION DATED 09/24/1996 HAS BEEN ADDED TO THE ORIGINAL PLAN ON FILE

MARYLAND DOT - STATE HIGHWAY ADMINISTRATION
Office of Traffic & Safety

TRAFFIC ENGINEERING DESIGN DIVISION

MD 182 (LAYHILL ROAD) and BRIGGS ROAD
GLENMONT, MARYLAND

DRAWN BY: W.J. Nee OF STS	F.A.P. NO. STPG-1993 (002)E	T.S. NO. TS-3264 B	SHEET NO.
CHECKED BY: D.J. Dade	S.H.A. NO. M-696-459-385	T.I.M.S. NO. F387	1 OF 1
SCALE: 1" = 20'	COUNTY MONTGOMERY		
DATE: 09/14/1992	LOG MILE 15018200.29		