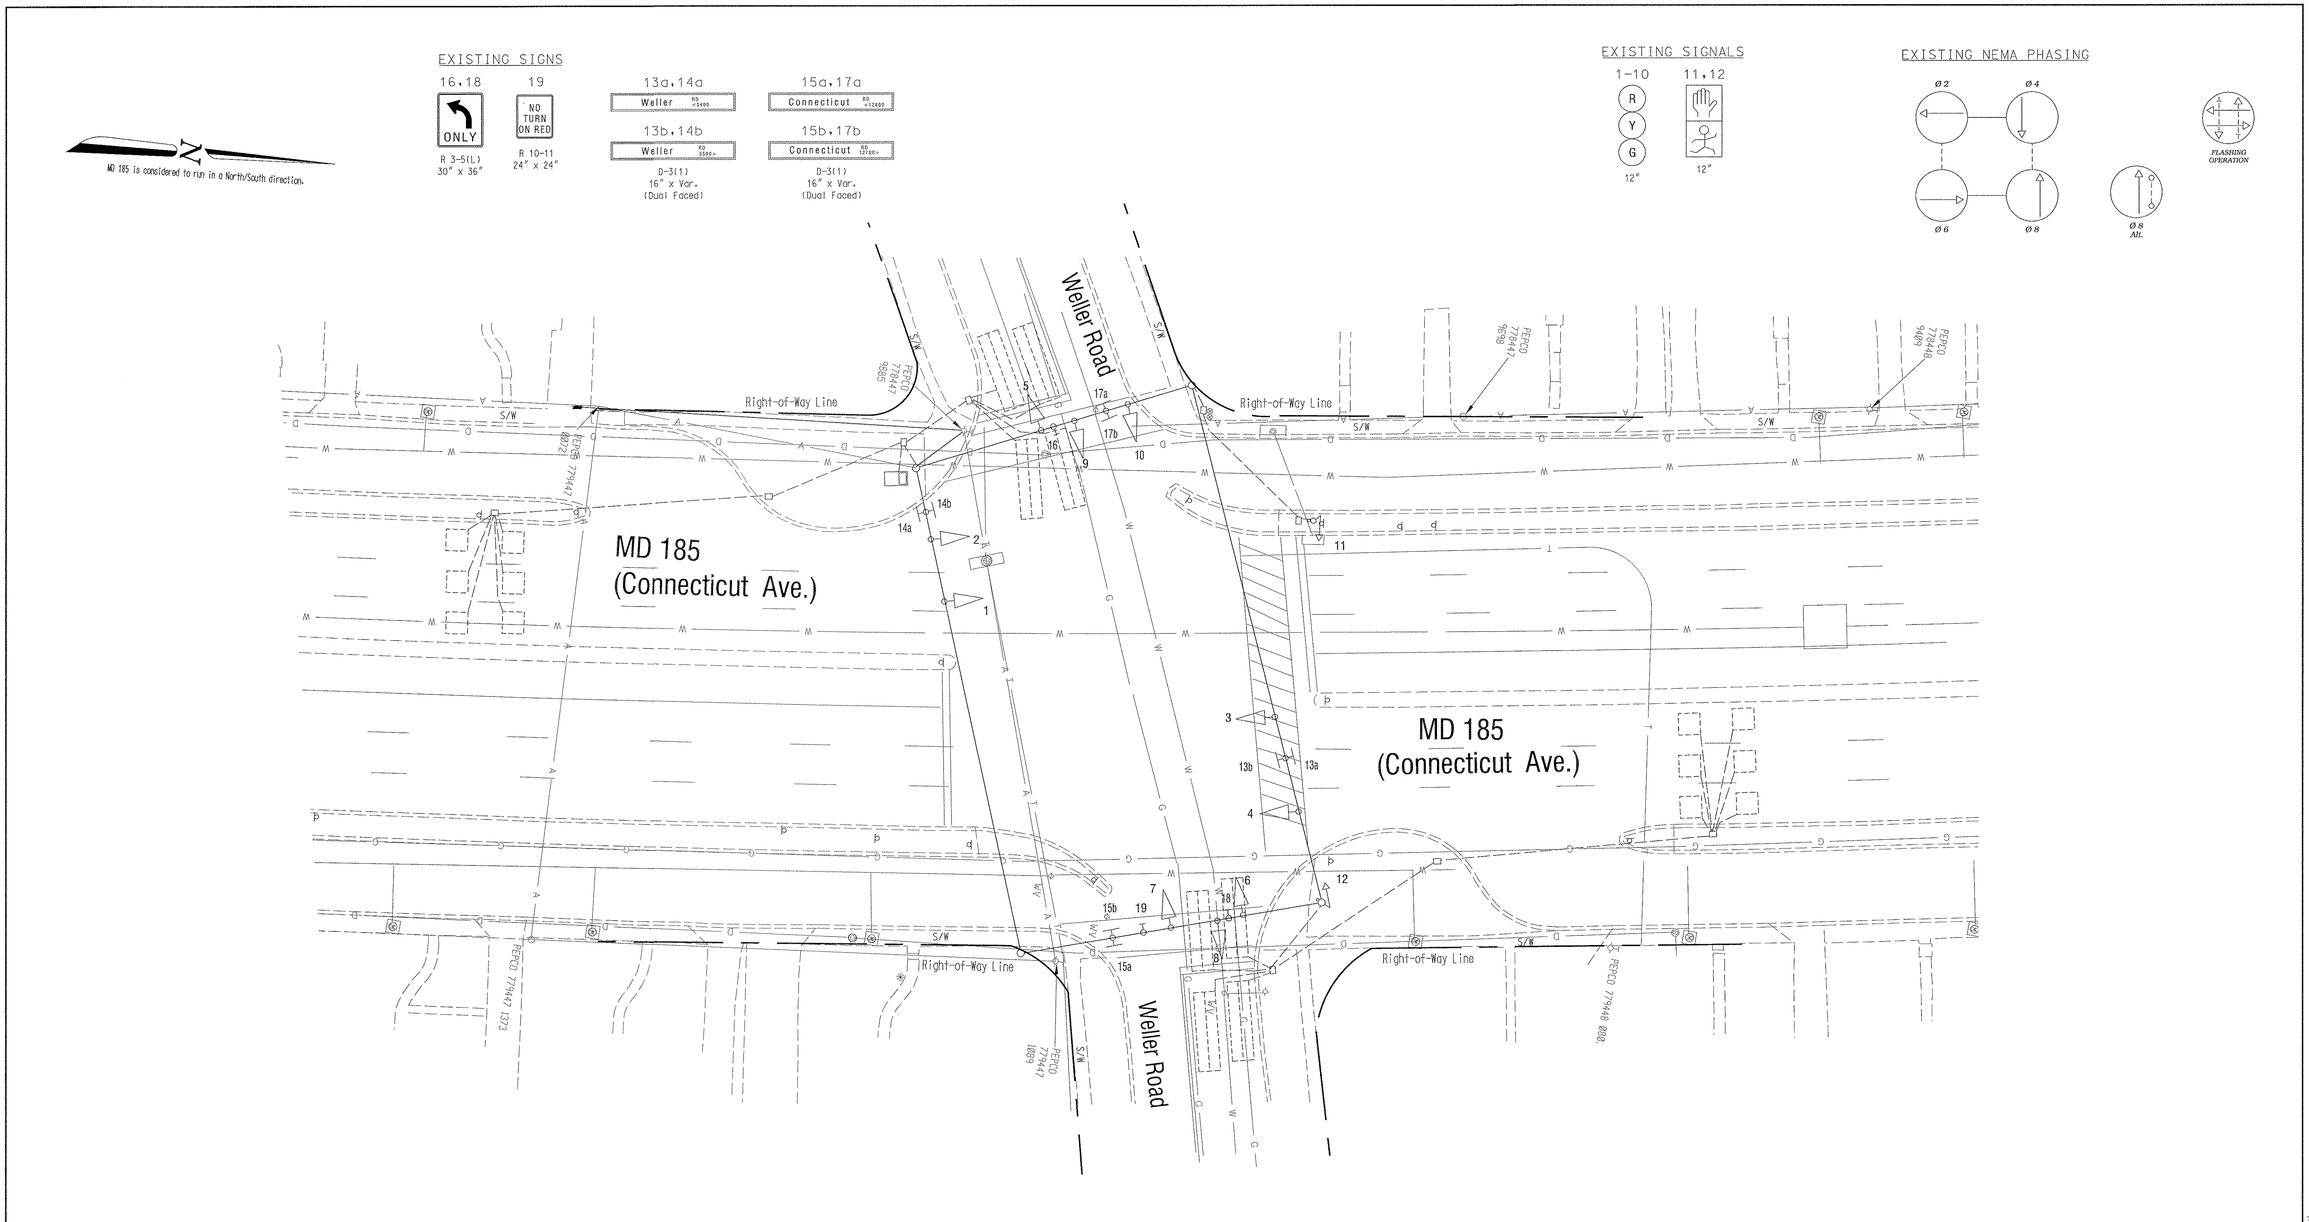

GEOMETRIC LEGEND

EXISTING GEOMETRICS

PROPOSED GEOMETRICS

UTILITY LEGEND

GAS MAIN

WATER MAIN

SEWER MAIN

ELECTRIC CABLES

STORM DRAIN

AERIAL CABLES

TELEPHONE CABLES

"AS-BUILT"

The Traffic Group

The Traffic Group, Inc.
410-931-6600
Fax 410-931-6601

REVISIONS

April 27, 20001

As-built
S.H.A. No.:BW109M83

FJH

APPROVALS

TEAM LEADER, TRAFFIC ENGINEERING DESIGN DIVISION

ASST. CHIEF TRAFFIC ENGINEERING DESIGN DIVISION

CHIEF, TRAFFIC ENGINEERING DESIGN DIVISION

DIRECTOR, TRAFFIC & SAFETY

ORIGINAL ON FILE

MARYLAND DOT - STATE HIGHWAY ADMINISTRATION

Office of Traffic & Safety

TRAFFIC ENGINEERING DESIGN DIVISION

(Traffic Signal Plan)

MD 185 (connecticut Ave) at Weller Road

DRAWN BY:	Bruce Thompson	F.A.P. NO.	N/A	TS NO. 521A	SHEET NO.
CHECKED BY:		S.H.A. NO.	M-410-501-317		
SCALE:	1" = 20'	COUNTY:	Montgomery	T.I.M.S. NO. XXX	1 OF 1
DATE:	May 25, 1985	LOG MILE:	N/A		

f:\1995\951020-o\des\asbuilt-cl.dgn 24 APR 2001