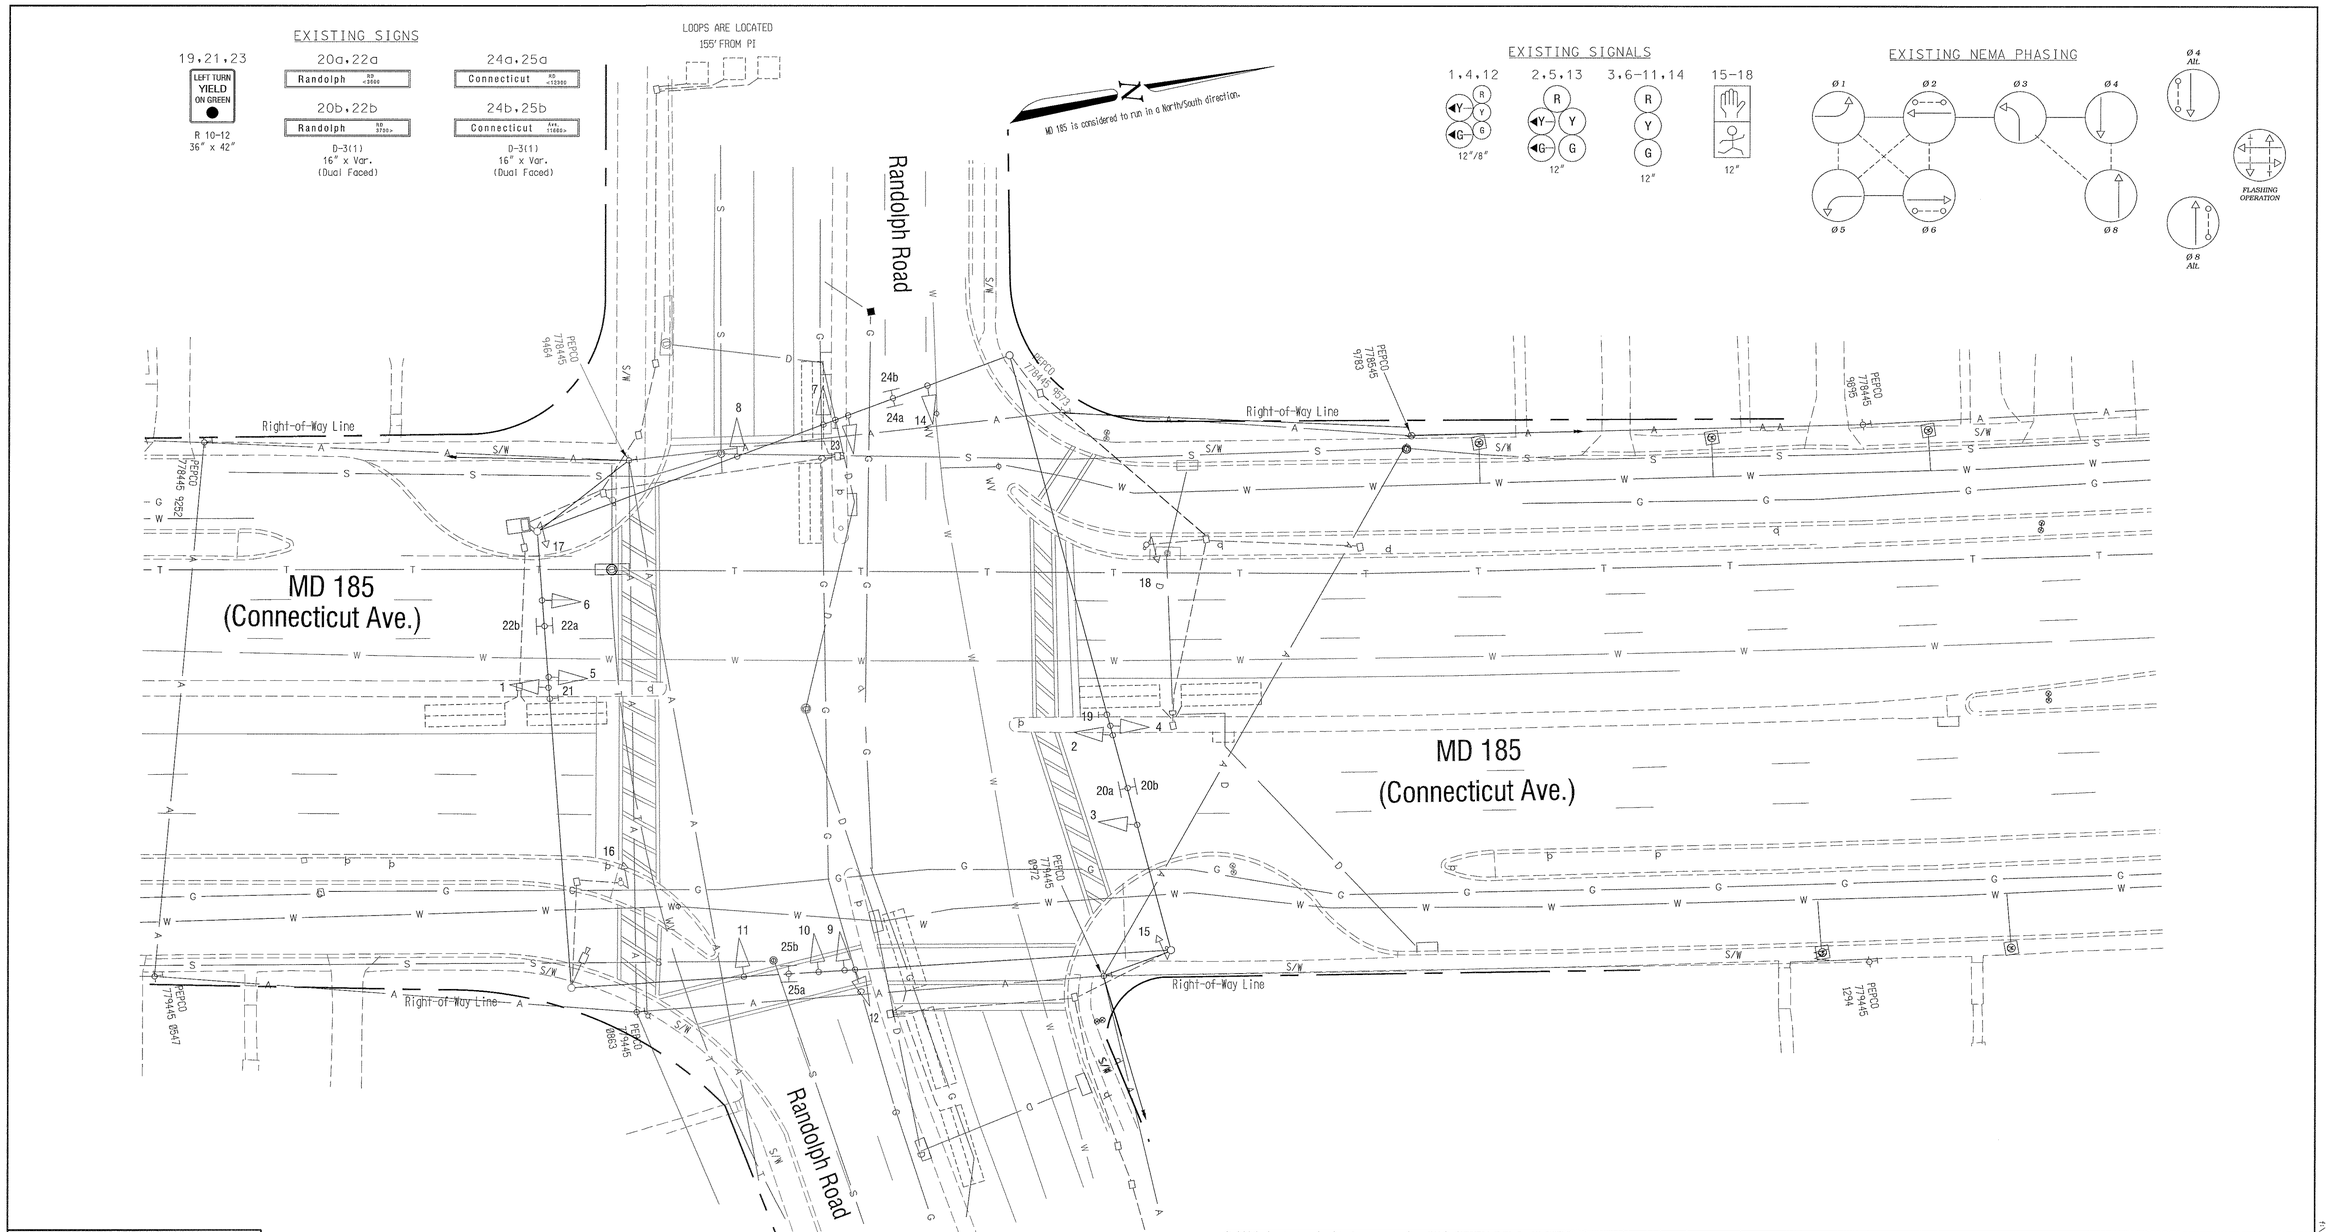

GEOMETRIC LEGEND

EXISTING GEOMETRICS

PROPOSED GEOMETRICS

UTILITY LEGEND

G	GAS MAIN
W	WATER MAIN
S	SEWER MAIN
E	ELECTRIC CABLES
D	STORM DRAIN
A	AERIAL CABLES
T	TELEPHONE CABLES

"AS-BUILT"

The Traffic Group

The Traffic Group, Inc.
410-931-6600
Fax 410-931-6601

REVISIONS

As-built
S.H.A. No.:BW109M83
FJH
April 27, 2001

APPROVALS

ORIGINAL ON FILE

TEAM LEADER, TRAFFIC ENGINEERING DESIGN DIVISION

ASST. CHIEF TRAFFIC ENGINEERING DESIGN DIVISION

CHIEF, TRAFFIC ENGINEERING DESIGN DIVISION

DIRECTOR, TRAFFIC & SAFETY

MARYLAND DOT - STATE HIGHWAY ADMINISTRATION

Office of Traffic & Safety

TRAFFIC ENGINEERING DESIGN DIVISION

(Traffic Signal Plan)

MD 185 (Connecticut Ave) at Randolph Road

DRAWN BY:	Bruce Thomson	F.A.P. NO.	N/A	TS NO. 2974A	SHEET NO.
CHECKED BY:		S.H.A. NO.	M-410-501-317		
SCALE:	1" = 20'	COUNTY:	Montgomery	T.I.M.S. NO. XXX	1 OF 1
DATE:	Sept 28, 1985	LOG MILE:			

f:\1995\95020-c\dsn\asbuilt-c2.dgn 24 APR 2001