F.H.WA. REGION NO.	STATE	FED. AID PROJ. NO.	SHEET NO.	TOTAL SHEETS
3	MD.			

NOTE ① STRIPING & STOP BARS SHOWN ARE PROPOSED

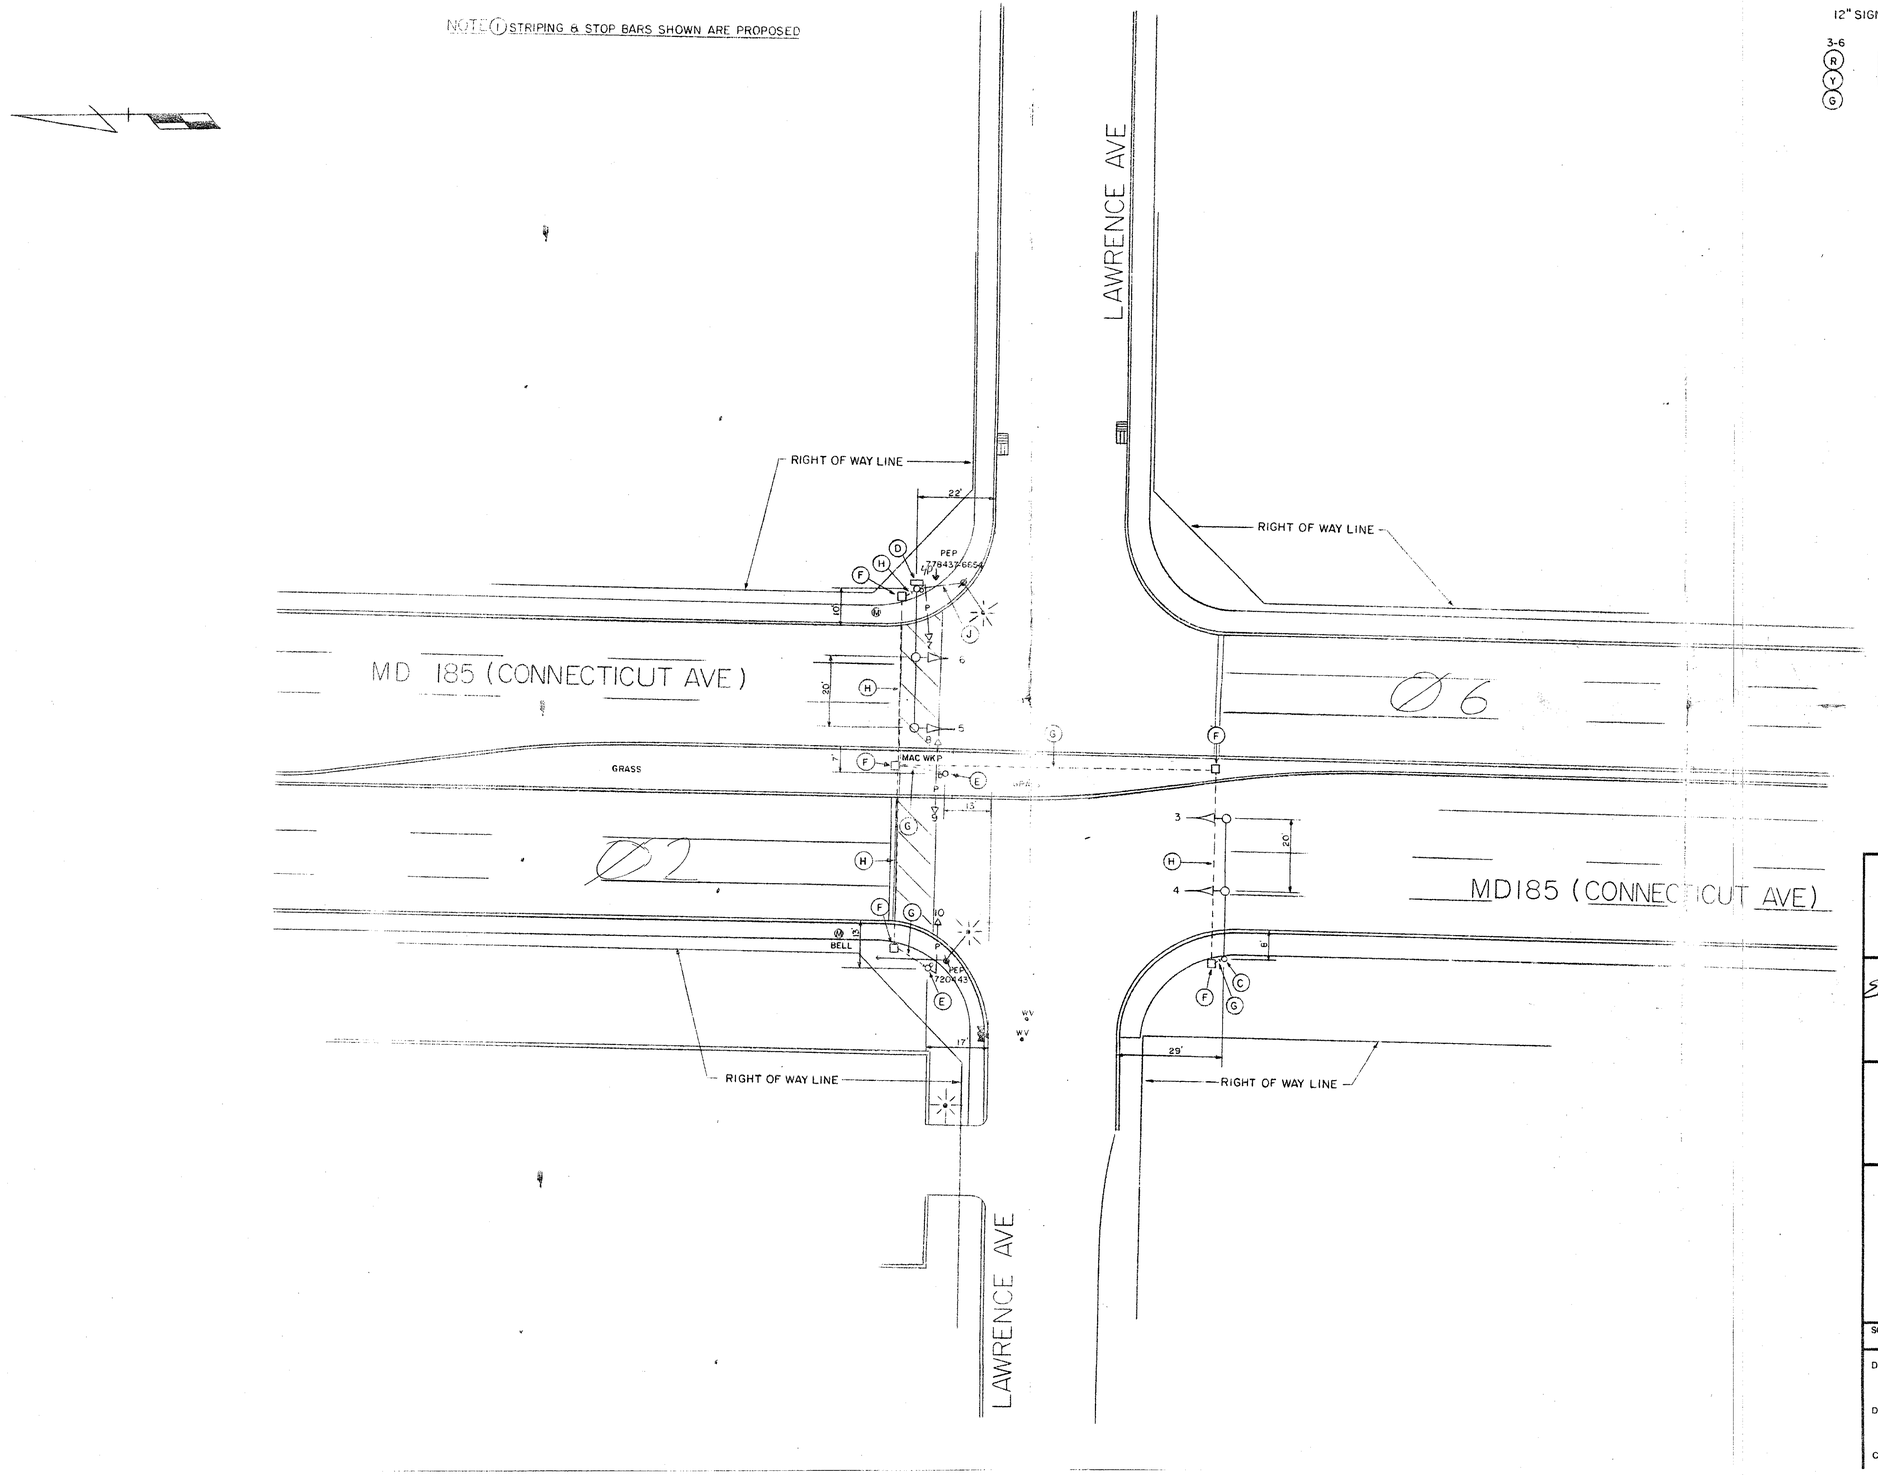

12" SIGNALS

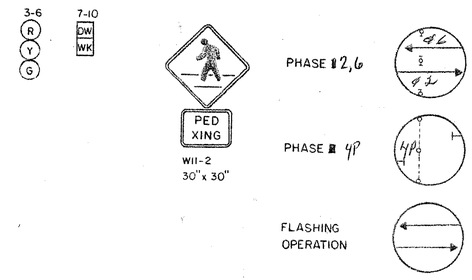

APPROVAL: REGIONAL TRAFFIC ENGINEER

Edward T Paulus Jr 2-26-76
APPROVAL: CHIEF-BUREAU OF TRAFFIC ENGINEERING

APPROVAL: ASS'T. CHIEF ENGINEER TRAFFIC

A 7-18-74
ASBUILT
M-958X-385
JG
REVISIONS

STATE OF MARYLAND
DEPARTMENT OF TRANSPORTATION
STATE HIGHWAY ADMINISTRATION

TRAFFIC DIVISION – BUREAU OF TRAFFIC ENGINEERING

MD185 & LAWRENCE AVE

SCALE 1"=20' DATE 2-25-76 CONTRACT NO. M203X-000-385

DRAWN BY: J GORDON COUNTY: MONTGOMERY

DESIGNED BY: J Gordon SIGNAL NO.:

CHECKED BY: A. Budnichuk 3-1-76.

DRAWING NO. TS-820