I 112

SIGNAL HEAD INDICATIONS

1. SIGNAL POLE LOC
ENGINEER IN FIEL
UNDERGROUND CL
2. SIGNAL HEADS SH
TO OBTAIN PROPE
3. ALL LOOP DETECT

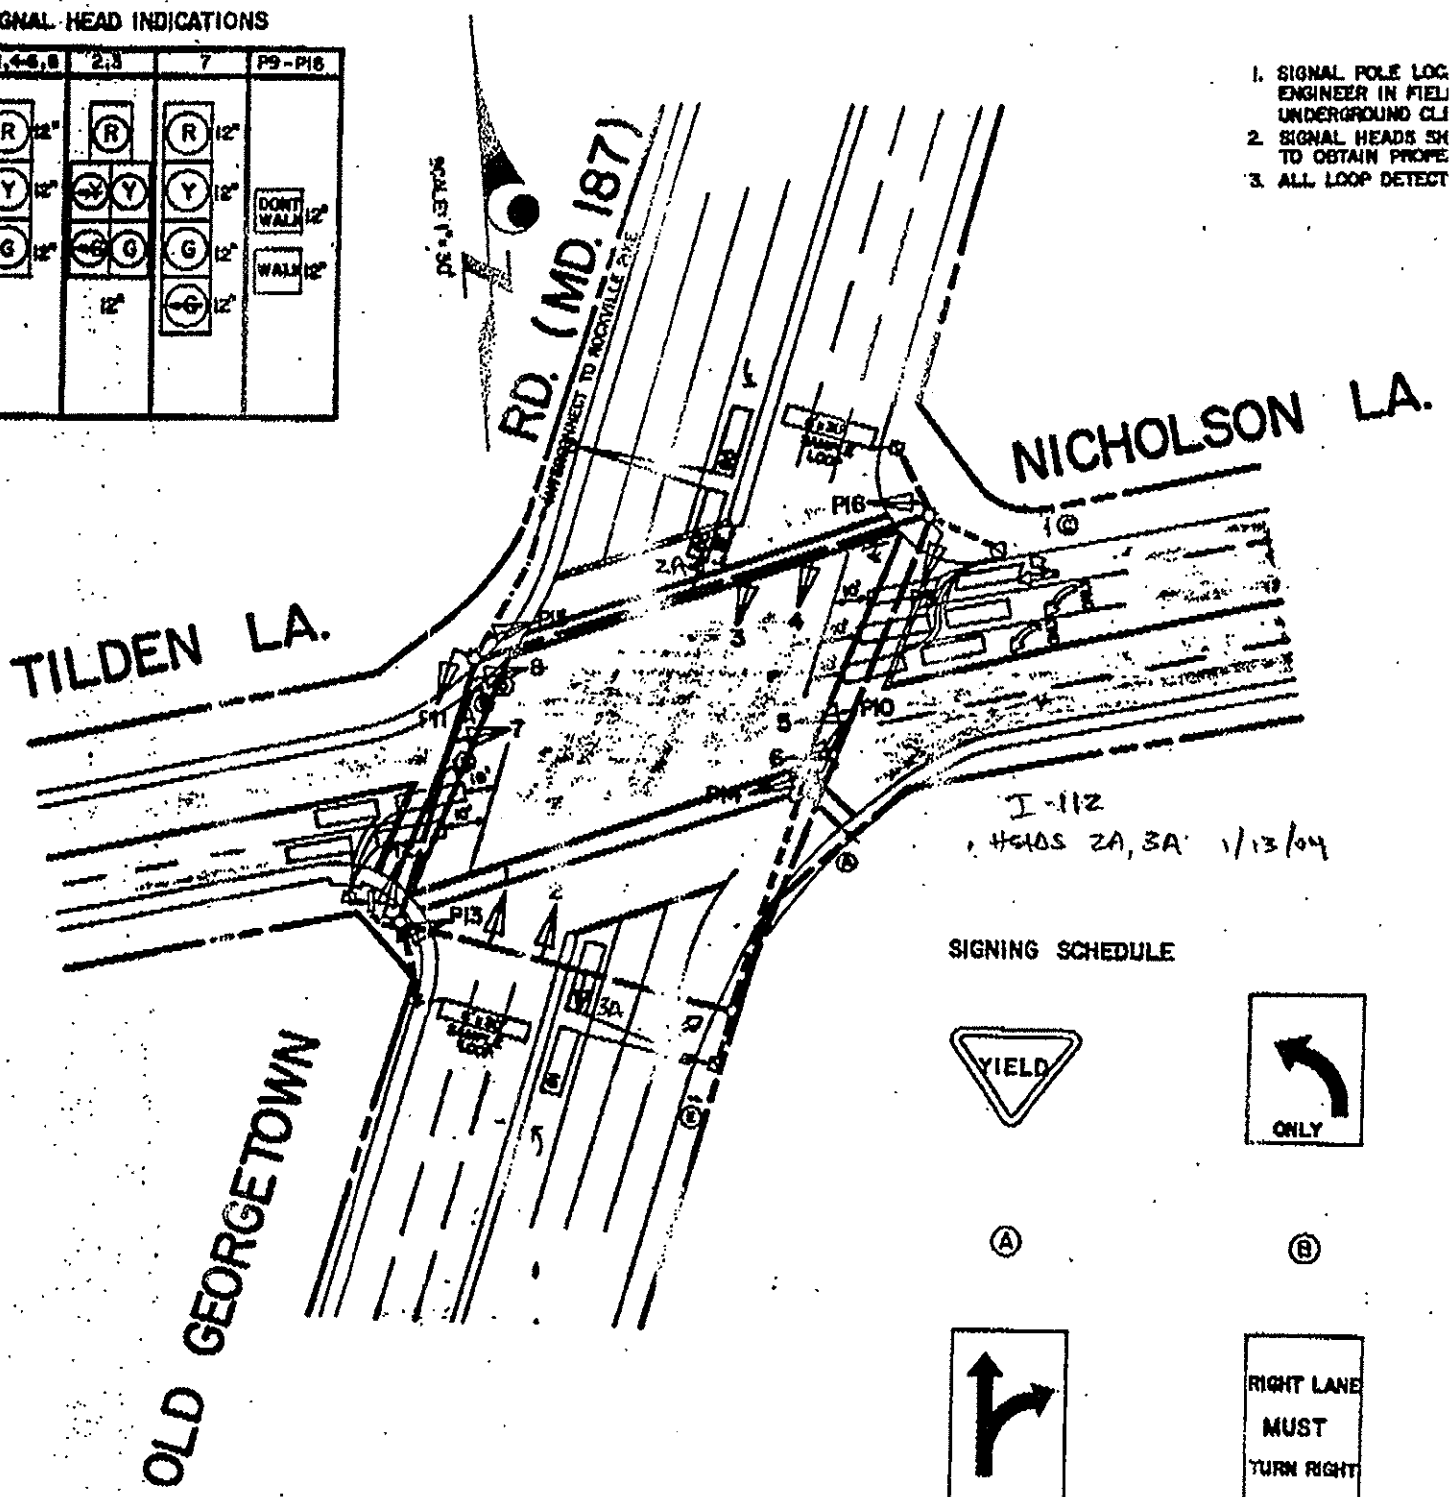

NO.	REVISION	BY	APPD	DATE
1	ADDED S.B. LEFT TURN E/P #9	W.W.C.		

DESIGNED BY P.C.B.	DATE 5-8-80	DEP
DRAWN BY T.E.L.	DATE 5-23-80	DIV
CHECKED BY	DATE	MO
DRAWING NO. E-80-070		

APPROVED BY Karl Aramau 6/2/80
CHIEF, TRAFFIC OPERATIONS SECTION

APPROVED BY Donald C. Walker 6/6/80
CHIEF, DIVISION OF TRAFFIC ENGINEERING

NIC