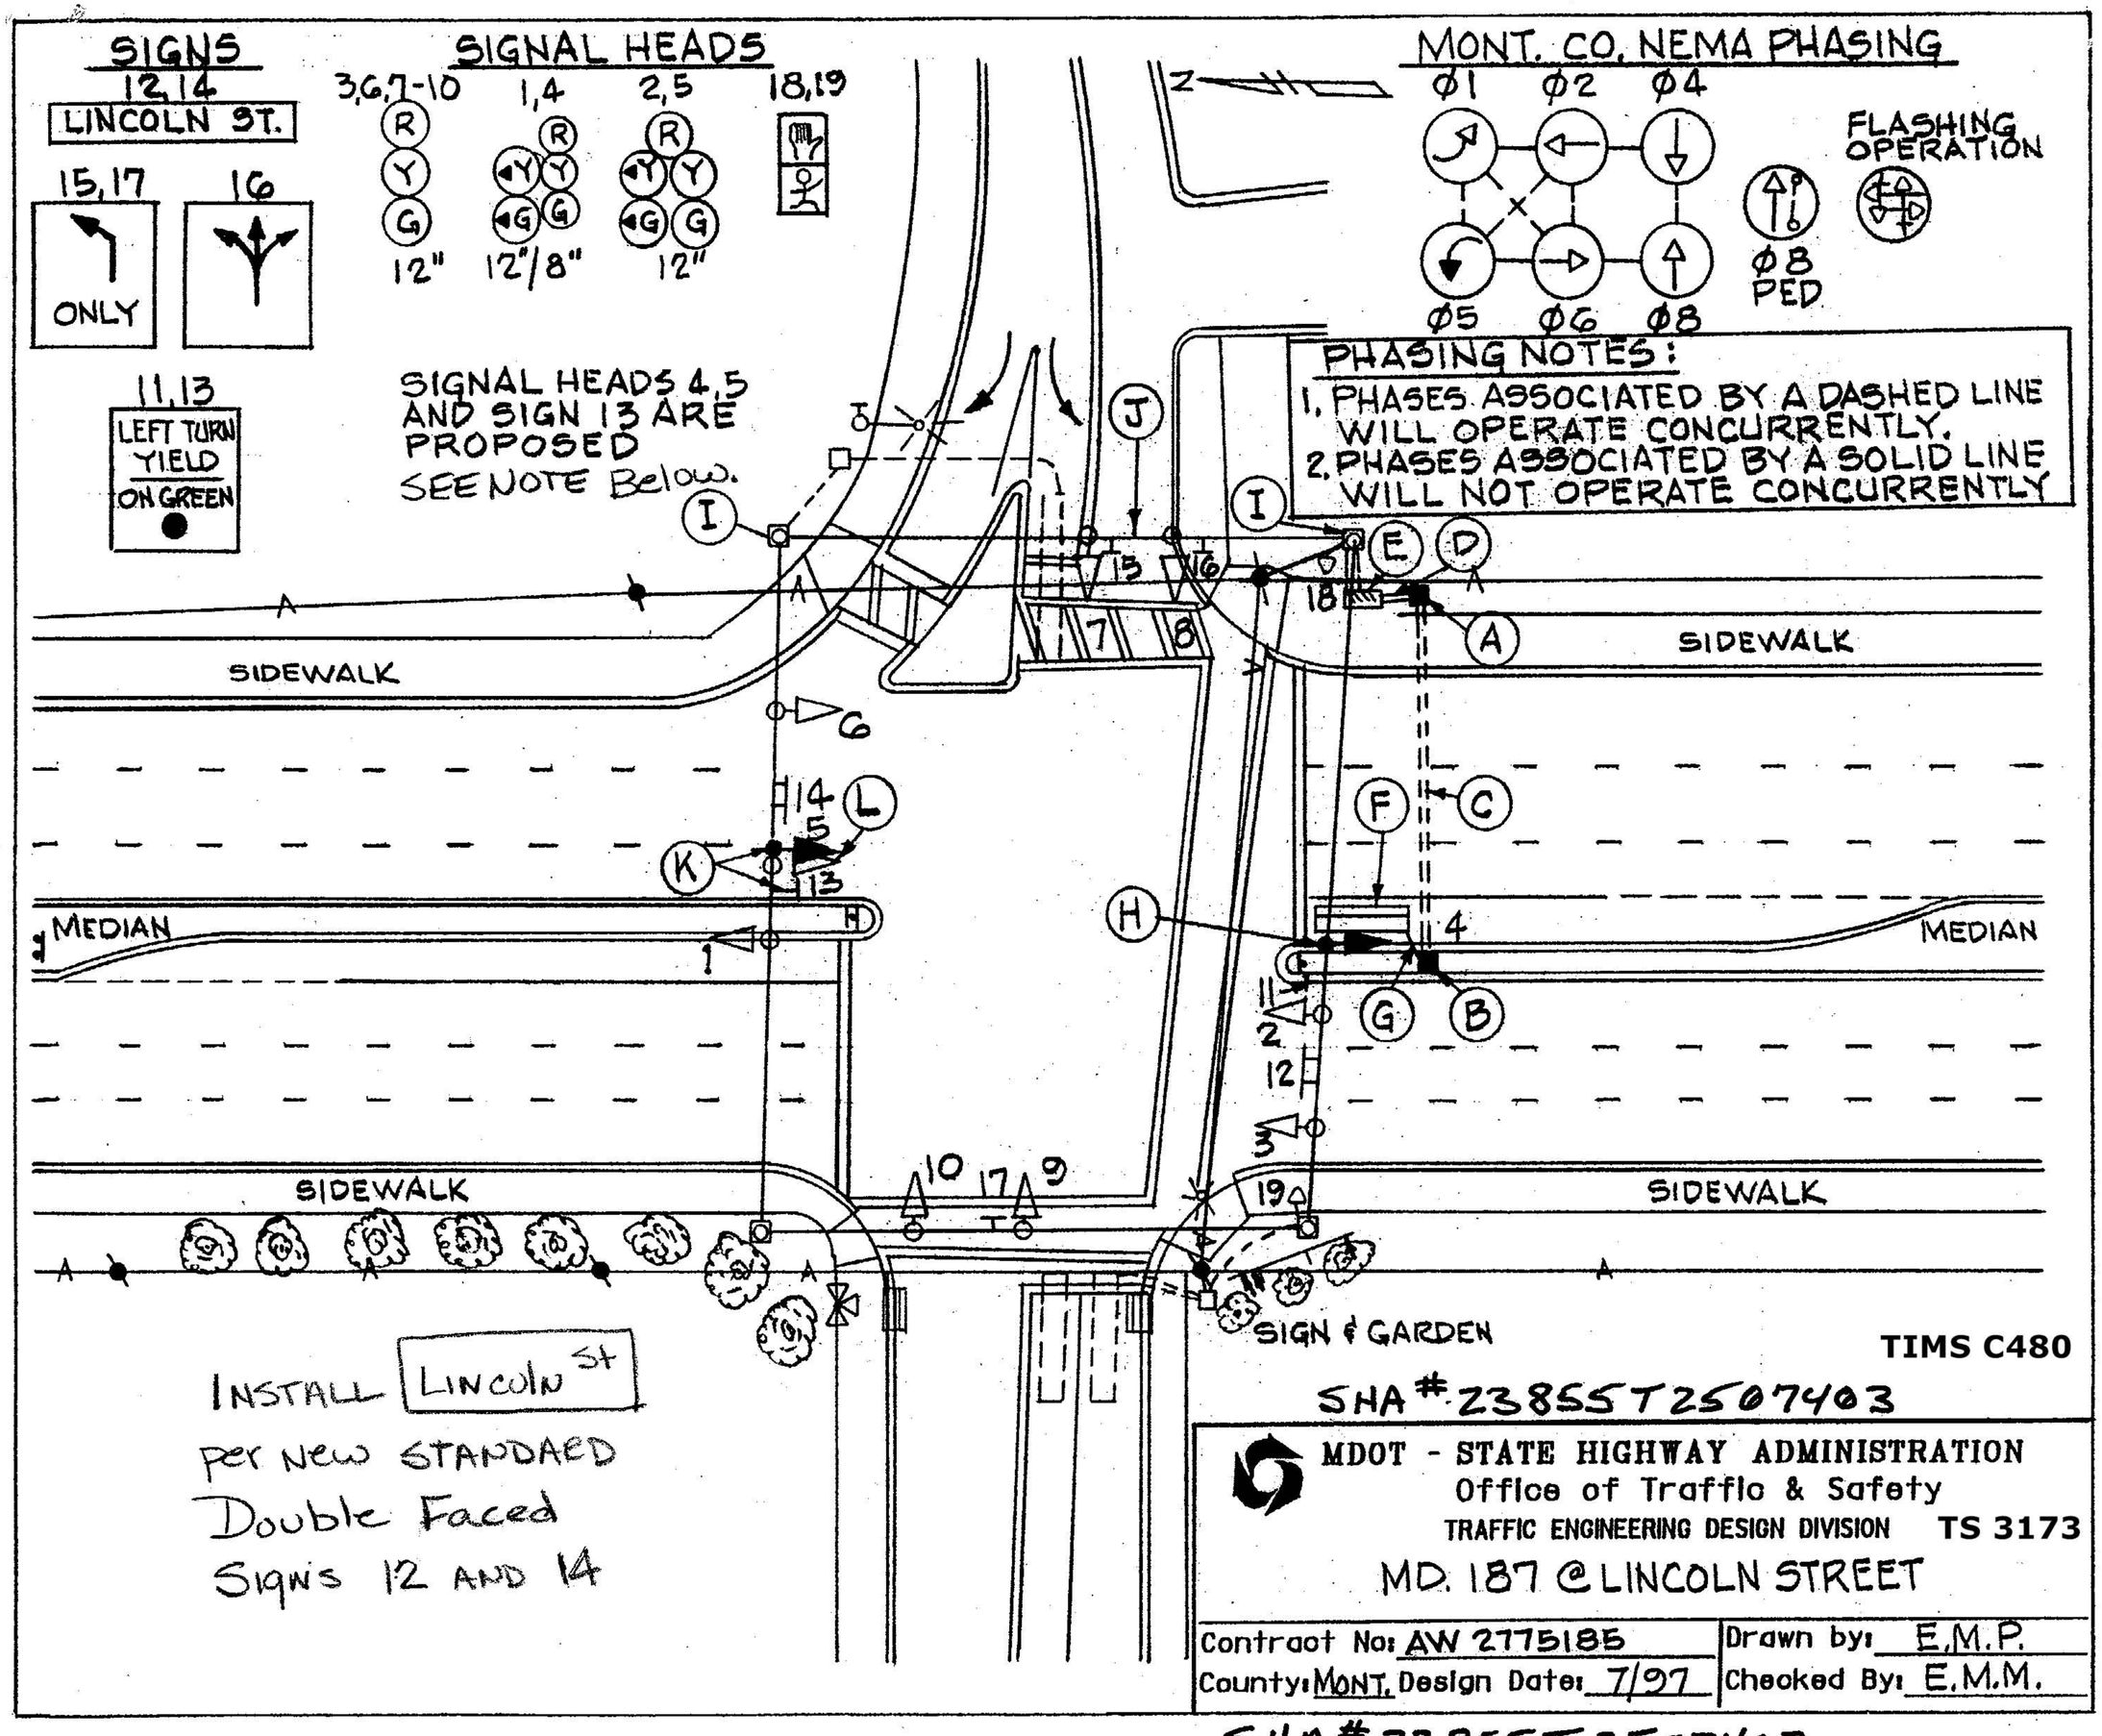

SHA # 23855T2507403