F H W A REGION NO.	STATE	FED. AID PROJ. NO.	SHEET NO.	TOTAL SHEETS
3	MD			

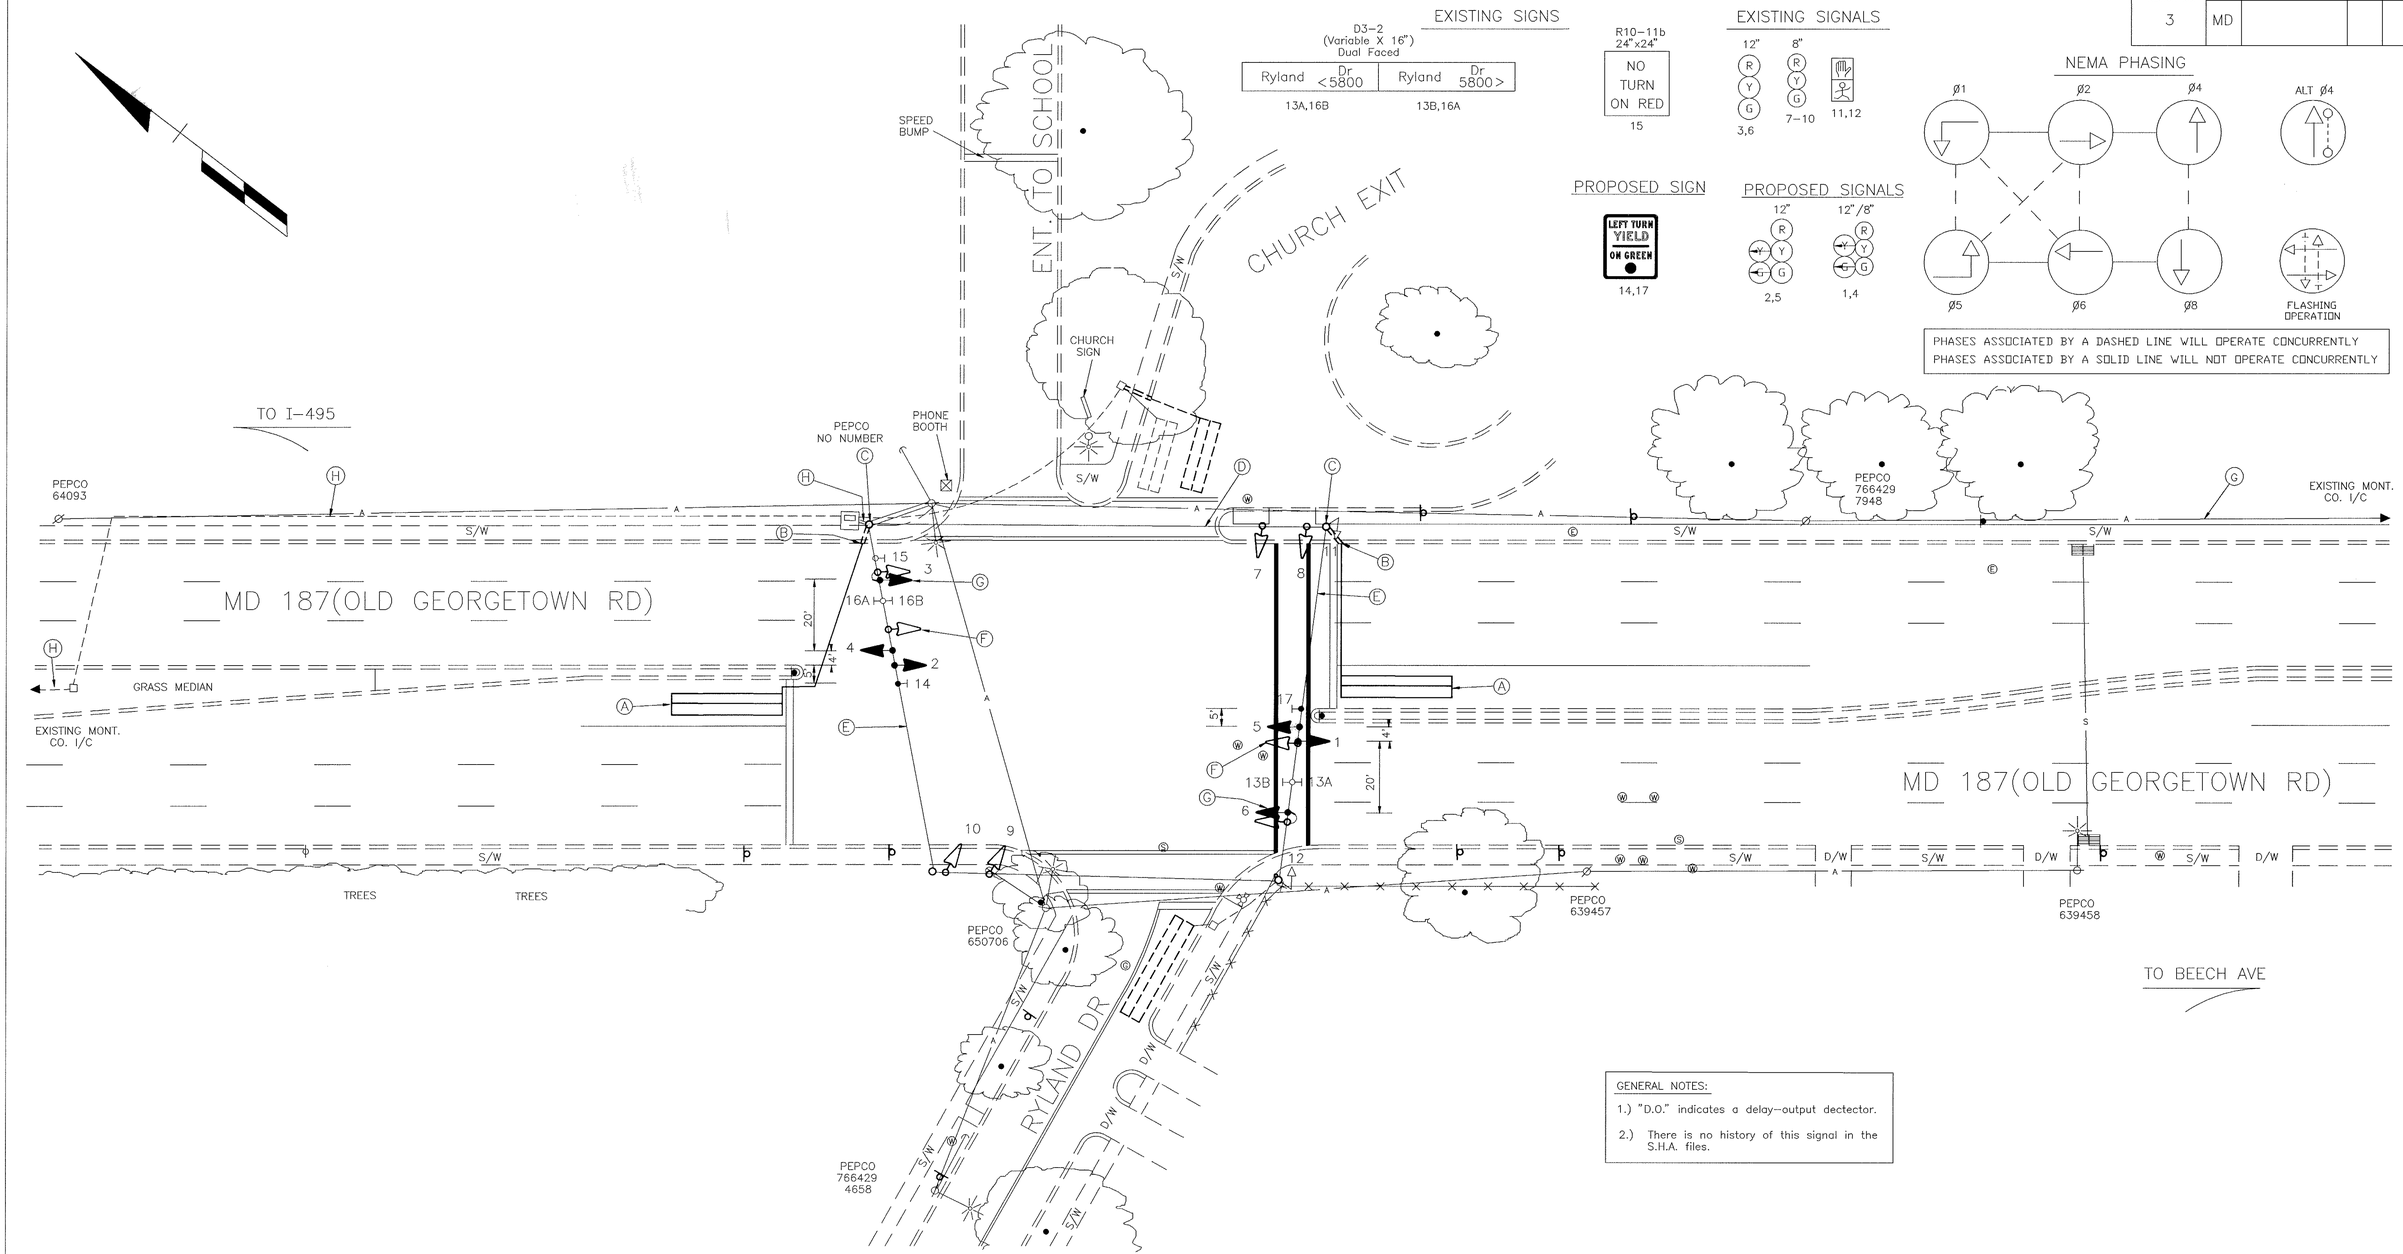

GENERAL NOTES:

1.) "D.O." indicates a delay-output dectector.

2.) There is no history of this signal in the S.H.A. files.

LEGEND OF UNDERGROUND AND OVERHEAD UTILITIES

AERIAL CABLE	A — A — A
ELECTRIC	E — E — E
TELEPHONE	T — T — T
GAS	G — G — G
SEWER	S — S — S
WATER	W — W — W
CABLE TV	TV — TV — TV

2028D.DWG

DGI CONSULTING ENGINEERS COLUMBIA, MARYLAND

REVISIONS

B 12-18-95 ADD E/P FOR EB/WB MD 187

DMP/DCI 12-19

A 2-25-91 REDRAW / ASBUILD AND REPLACE DEFECTIVE LOOPS

S.H.A. NO. M-650-501-377

RRZ/STS

APPROVALS

CHIEF, DESIGN SECTION

ASST. DISTRICT ENGINEER, TRAFFIC

CHIEF, TRAFFIC ENGINEERING DIVISION

DEPUTY CHIEF ENGINEER, TRAFFIC

MDOT – STATE HIGHWAY ADMINISTRATION

Office of Traffic

TRAFFIC ENGINEERING DIVISION

DRAWN BY: W J NIES
DES. BY: R R ZACHERL
CHK. BY:

MD 187 (OLD GEORGETOWN RD) AND RYLAND DR

LOG MILE-15018702.44

COUNTY MONTGOMERY

DATE: 10-11-90
SCALE: 1"=20'

F.A.P. NO.
S.H.A. NO. M-650-501-377

TS/STD. NO. TS-3141B

SHEET NO. ___ OF ___