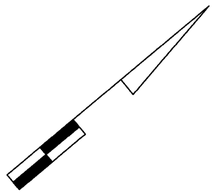

NOTE: MD 189 IS ASSUMED TO RUN IN A NORTH/SOUTH DIRECTION.

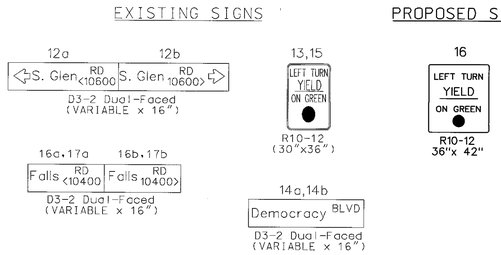

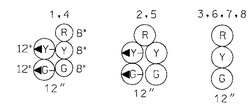

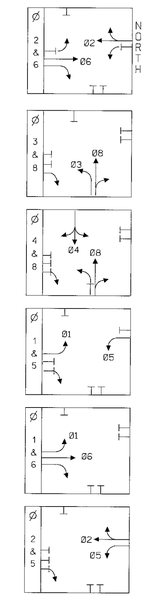

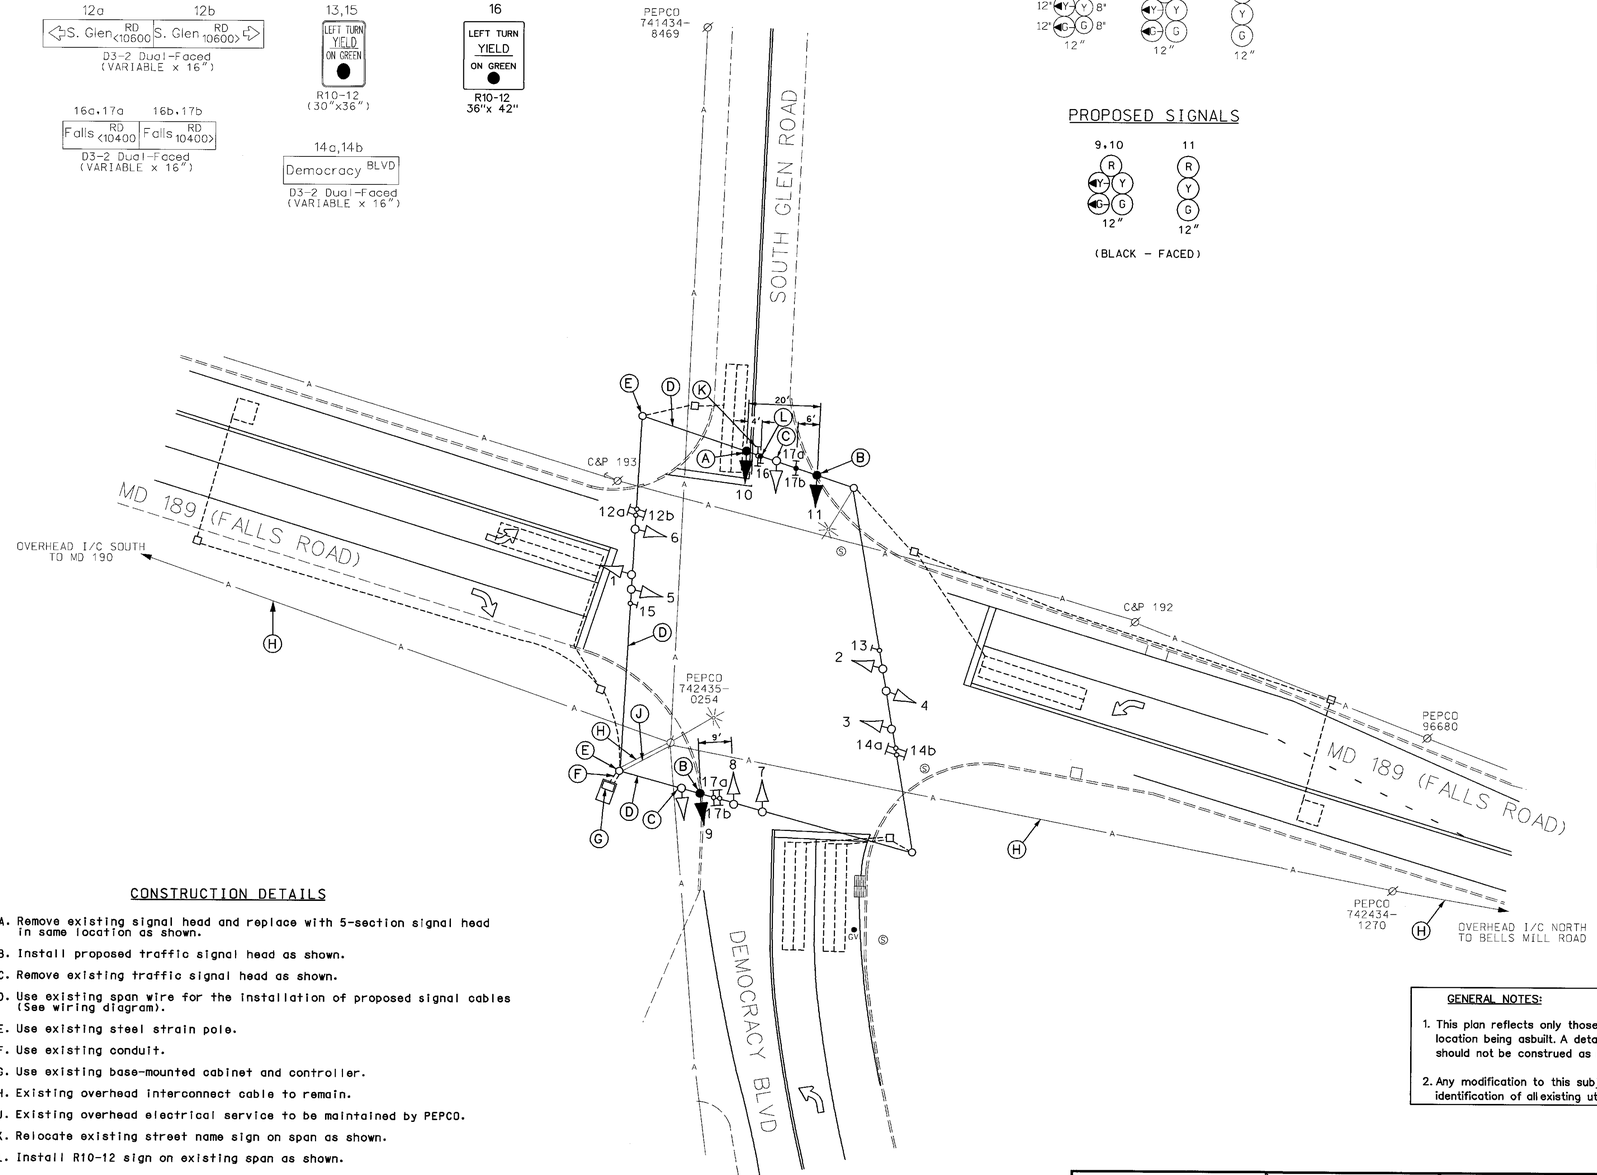

CONSTRUCTION DETAILS

A. Remove existing signal head and replace with 5-section signal head in same location as shown.

B. Install proposed traffic signal head as shown.

C. Remove existing traffic signal head as shown.

D. Use existing span wire for the installation of proposed signal cables (See wiring diagram).

E. Use existing steel strain pole.

F. Use existing conduit.

G. Use existing base-mounted cabinet and controller.

H. Existing overhead interconnect cable to remain.

J. Existing overhead electrical service to be maintained by PEPCO.

K. Relocate existing street name sign on span as shown.

L. Install R10-12 sign on existing span as shown.

GENERAL NOTES:

1. This plan reflects only those utilities that were apparent at the time of this location being asbuilt. A detailed review was not undertaken and this plan should not be construed as representing all utilities in the area.

2. Any modification to this subject signal should be preceeded by a thorough identification of all existing utilities.

LEGEND OF UNDERGROUND AND OVERHEAD UTILITIES

AERIAL CABLE	A
ELECTRIC	E
TELEPHONE	T
GAS	G
SEWER	S
WATER	W
CABLE TV	TV

REVISION "C" ASBUILT

STREET TRAFFIC STUDIES, LTD.
400 Crain Hwy. NW.
Glen Burnie, MD 21061
Ph (410) 590-5500
Fax (410) 590-6637

4130.dgn

REVISIONS	APPROVALS
© 5-14-02 INSTALLATION OF LEADING WB EXCLUSIVE/PERMISSIVE LT PHASING SHA NO.: BW996M82	TEAM LEADER, TRAFFIC ENGINEERING DESIGN DIVISION
RRZ	ASST. CHIEF, TRAFFIC ENGINEERING DESIGN DIVISION
B 2-4-99 ASBUILT SHA NO: MD5715176	CHIEF, TRAFFIC ENGINEERING DESIGN DIVISION
RRZ	
A 7-96 RE-CUT LOOPS DUE TO RESURFACING PROJECT SHA NO: MD5715176	DIRECTOR, TRAFFIC & SAFETY
TMZ	

ORIGINAL ON FILE

MARYLAND DOT - STATE HIGHWAY ADMINISTRATION
Office of Traffic & Safety
TRAFFIC ENGINEERING DESIGN DIVISION

MD 189 (FALLS RD) AT DEMOCRACY BLVD / SOUTH GLEN RD

DRAWN BY: TMZ	F.A.P. NO.		TS NO. 3878C	SHEET NO. 1 OF 2
CHECKED BY:	S.H.A. NO.			
SCALE: 1"= 20'	COUNTY: MONTGOMERY		T.I.M.S. NO. F039	
DATE: 7-96	LOG MILE: 15018902.66			

m:\signaldesign\4130\4130.dgn Jul. 03, 2002 03:25:05