F H W A REGION NO.	STATE	FED. AID PROJ. NO.	SHEET NO.	TOTAL SHEETS
3	MD		9	9

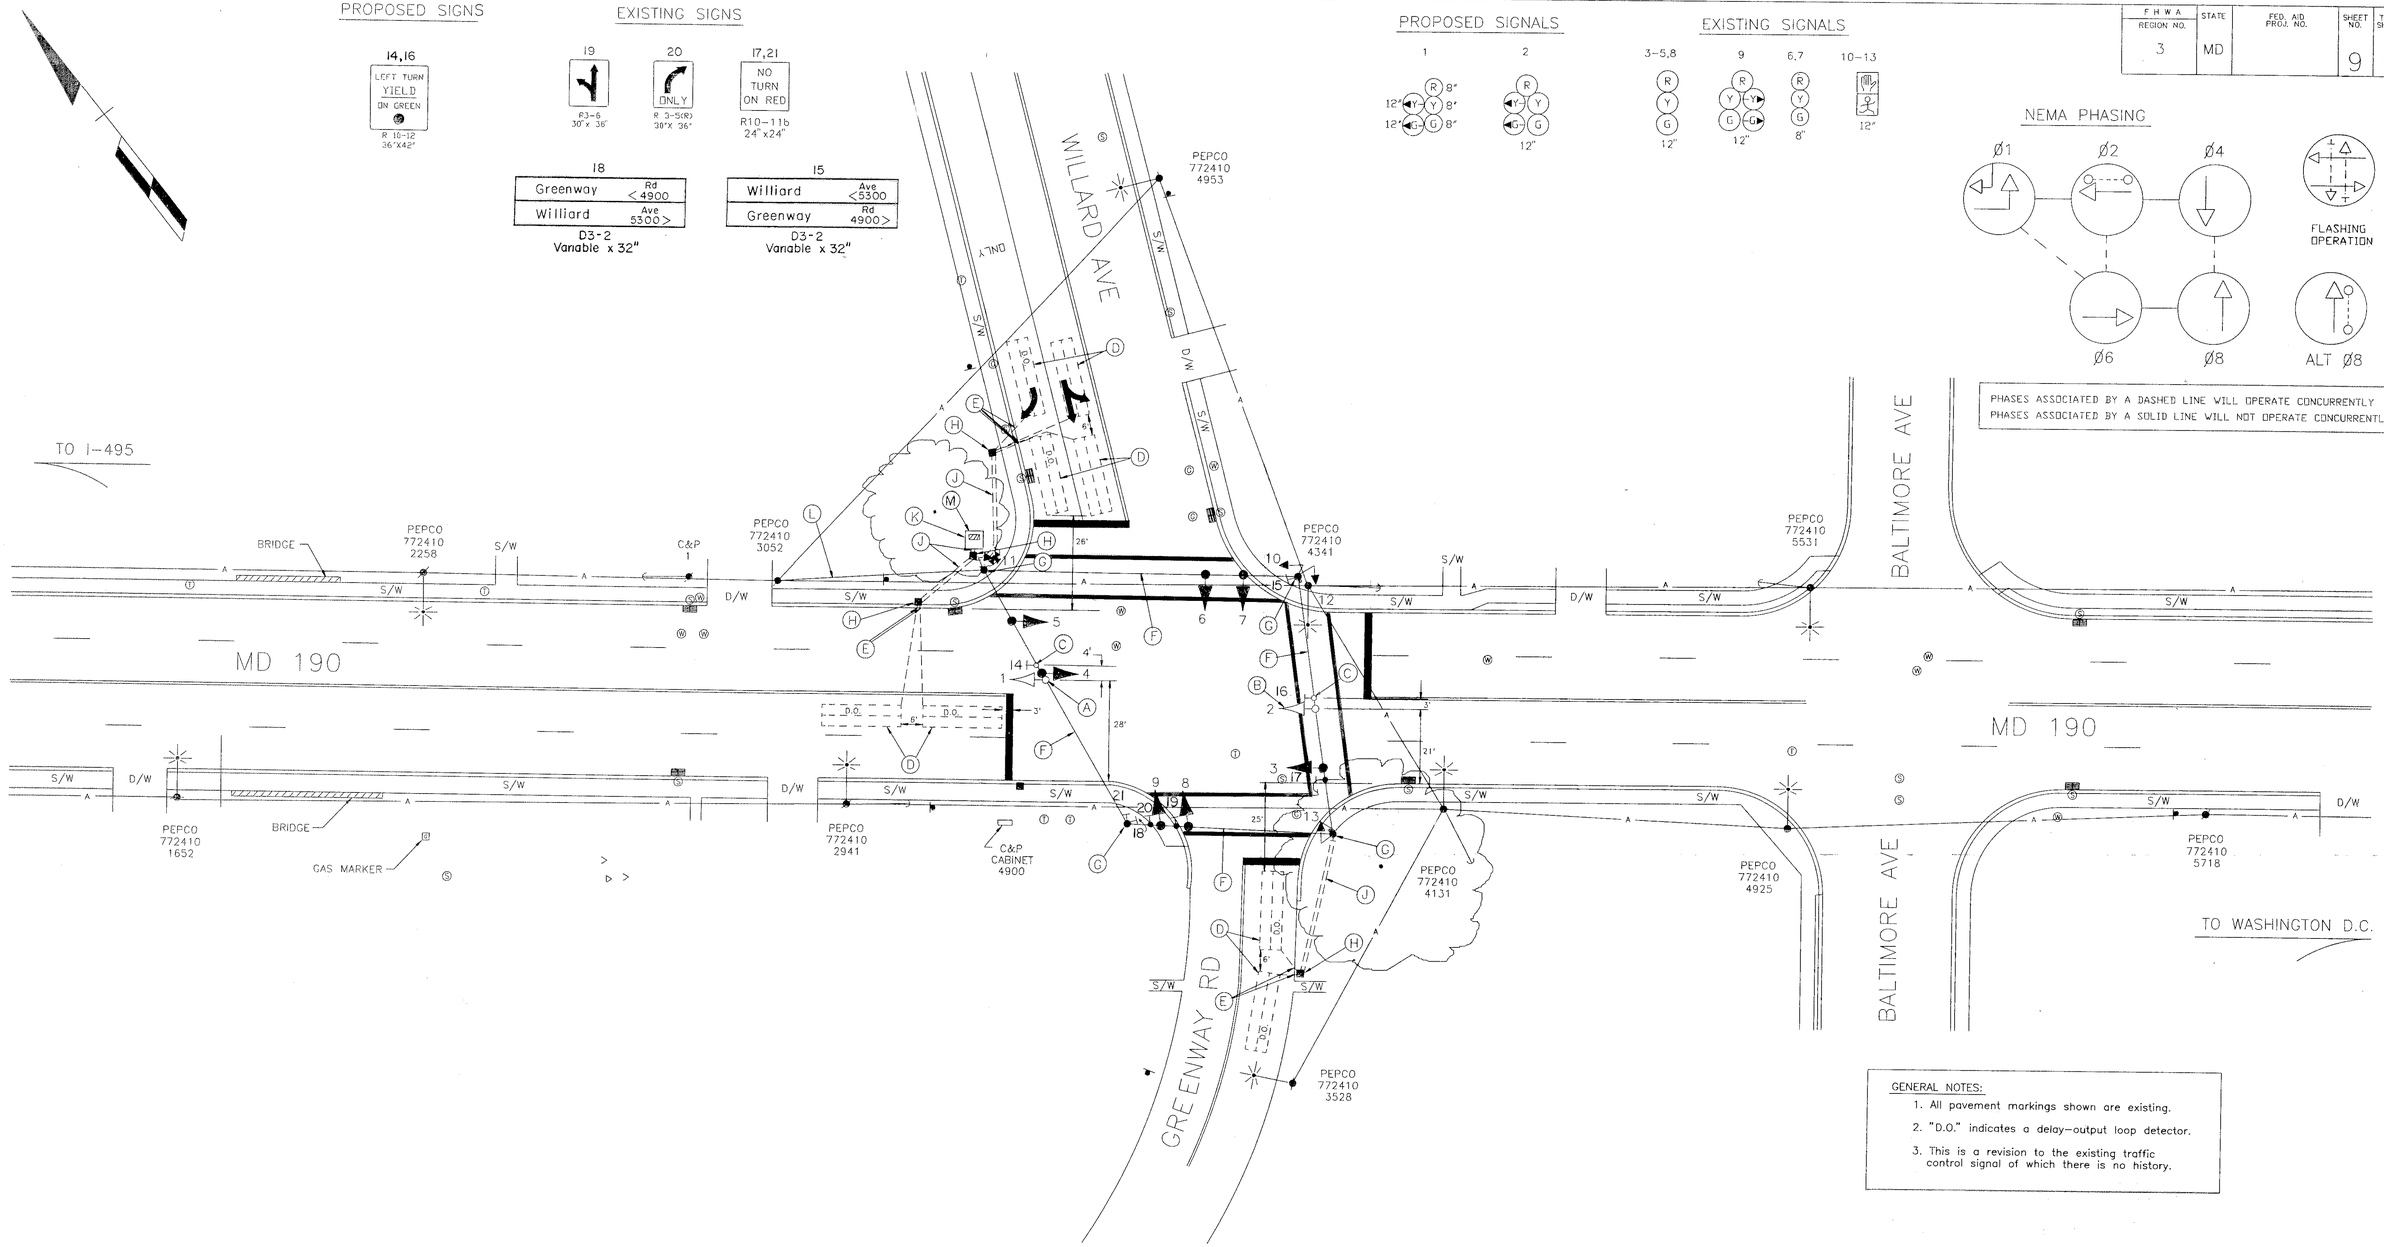

GENERAL NOTES:

1. All pavement markings shown are existing.
2. "D.O." indicates a delay-output loop detector.
3. This is a revision to the existing traffic control signal of which there is no history.

LEGEND OF UNDERGROUND AND OVERHEAD UTILITIES

AERIAL CABLE	A	A	A
ELECTRIC	E	E	E
TELEPHONE	T	T	T
GAS	G	G	G
SEWER	S	S	S
WATER	W	W	W
CABLE TV	TV	TV	TV

STREET TRAFFIC STUDIES, LTD.
Gateway International
1302 Concourse Drive, Suite 104
Linthicum, Maryland 21090
(301) 859-3553

REVISIONS

(A) 6-12-91 ADD SIGNAL HEADS, SIGNS, LOOPS, AND ASBUILD
S.H.A. NO. - M-651-501-377
R.R.Z.

APPROVALS

CHIEF, DESIGN SECTION
ASST. DISTRICT ENGINEER, TRAFFIC
CHIEF, TRAFFIC ENGINEERING DIVISION
DEPUTY CHIEF ENGINEER, TRAFFIC

ORIGINAL ON FILE

MDOT – STATE HIGHWAY ADMINISTRATION

Office of Traffic

TRAFFIC ENGINEERING DIVISION

LOG MILE NO: 15019015.57

DRAWN BY: W J NIES (FOR STS)
DES. BY: R R ZACHERL (FOR STS)
CHK. BY:

MD 190 AND GREENWAY RD./WILLARD AVE.
COUNTY MONTGOMERY

DATE: 6-12-91
SCALE: 1"=20'
F.A.P. NO.
S.H.A. NO.
TS/STD. NO. 3181A
SHEET NO. 9 OF 9

Folder # 37 15019015.57