△ VOID

F H WA REGION NO	STATE	FED. AID PROJ. NO	SHEET NO.	TOTAL SHEETS
3	MD.		5	15

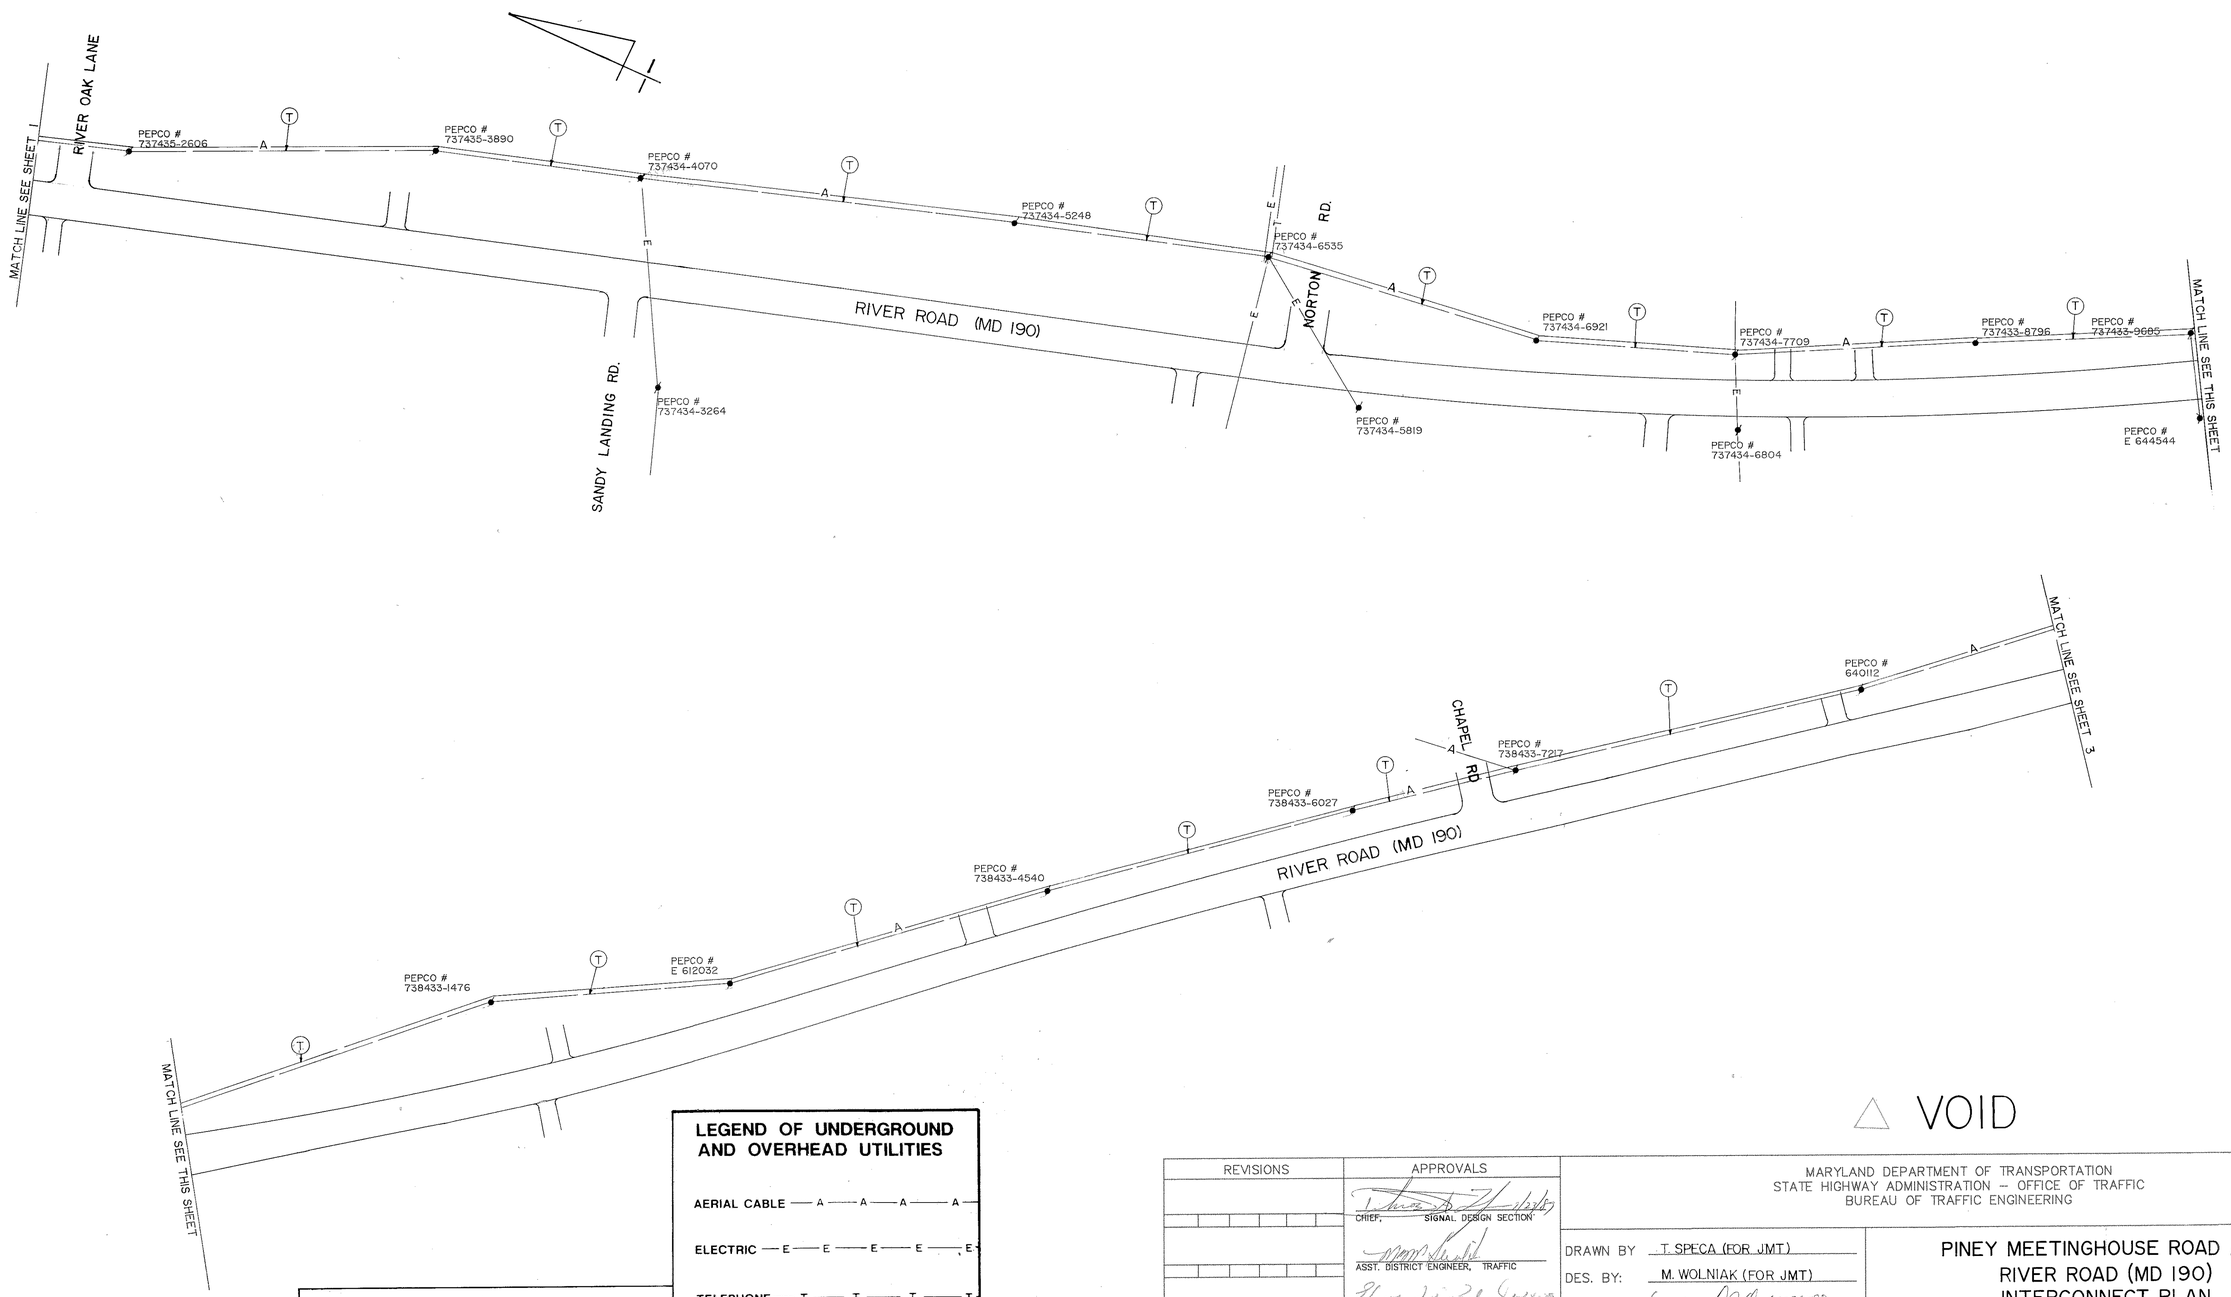

△ VOID

LEGEND OF UNDERGROUND AND OVERHEAD UTILITIES

AERIAL CABLE — A — A — A — A —

ELECTRIC — E — E — E — E — E —

TELEPHONE — T — T — T — T —

JOHNSON, MIRMIRAN & THOMPSON, P.A.
810 GLENEAGLES CT.
BALTIMORE, MARYLAND

REVISIONS	APPROVALS
△ REVISION A 6/22/89 REDLINE REVISIONS	CHIEF, SIGNAL DESIGN SECTION
MCE/TMS	ASST. DISTRICT ENGINEER, TRAFFIC
	CHIEF, BUREAU OF TRAFFIC ENGINEERING
	DEPUTY CHIEF ENGINEER, OFFICE OF TRAFFIC 1-27-88

MARYLAND DEPARTMENT OF TRANSPORTATION
STATE HIGHWAY ADMINISTRATION – OFFICE OF TRAFFIC
BUREAU OF TRAFFIC ENGINEERING

DRAWN BY: T. SPECA (FOR JMT)
DES. BY: M. WOLNIAK (FOR JMT)
CHK. BY: 1-24-87

PINEY MEETINGHOUSE ROAD AT RIVER ROAD (MD 190) INTERCONNECT PLAN

COUNTY: MONTGOMERY

DATE: 8/25/88
SCALE: 1" = 50'
F.A.P. NO.
S.H.A. NO. M 626-509-385

TS/FILE NO. 2526 X-2

SHEET NO. 5 OF 15

15019006.48