△ VOID

F H WA REGION NO	STATE	FED. AID PROJ. NO	SHEET NO.	TOTAL SHEETS
3	MD.		6	15

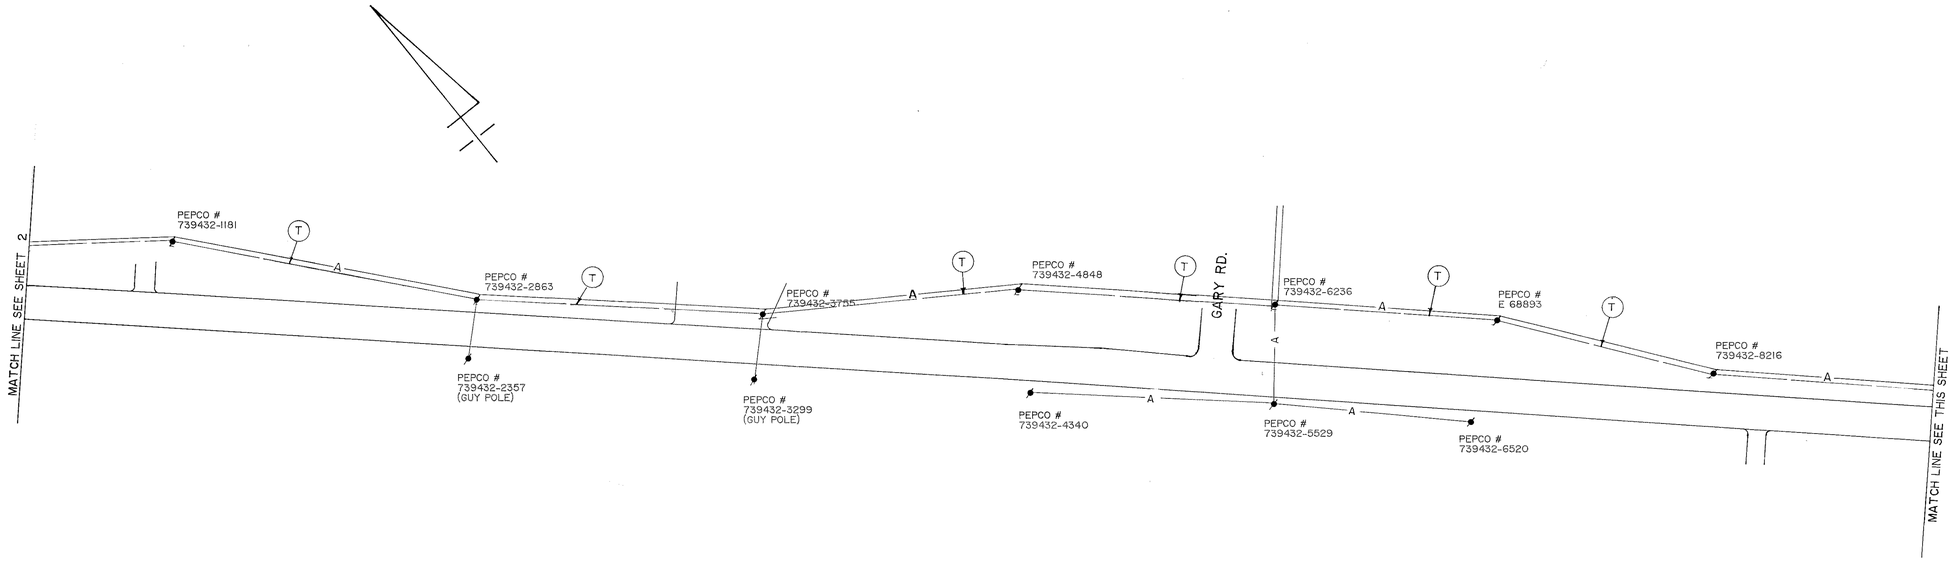

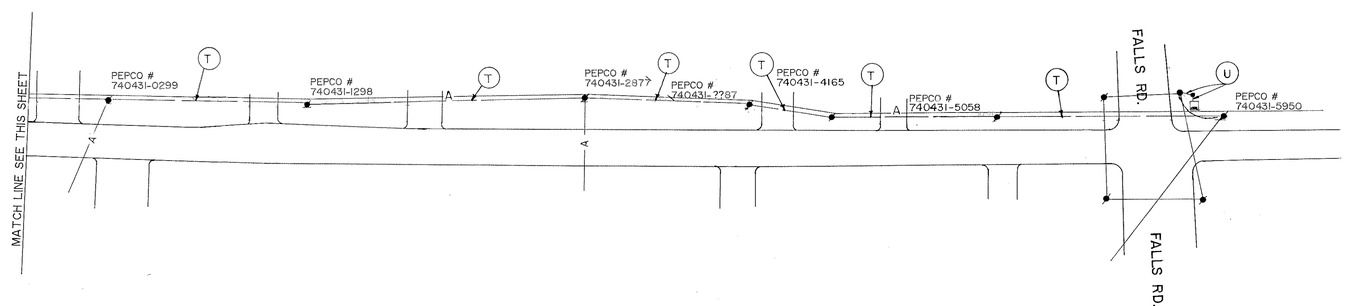

△ VOID

LEGEND OF UNDERGROUND AND OVERHEAD UTILITIES

AERIAL CABLE — A — A — A — A —

ELECTRIC — E — E — E — E — E —

TELEPHONE — T — T — T — T —

JOHNSON, MIRMIRAN & THOMPSON, P.A.
810 GLENEAGLES CT.
BALTIMORE, MARYLAND

REVISIONS	APPROVALS
	CHIEF, SIGNAL DESIGN SECTION 1-23-89
	ASST. DISTRICT ENGINEER, TRAFFIC
	CHIEF, BUREAU OF TRAFFIC ENGINEERING 1-24-89
△ REVISION A 6/22/89 REDLINE REVISIONS	DEPUTY CHIEF ENGINEER, OFFICE OF TRAFFIC 1-27-89
MCE/TMS	

MARYLAND DEPARTMENT OF TRANSPORTATION
STATE HIGHWAY ADMINISTRATION – OFFICE OF TRAFFIC
BUREAU OF TRAFFIC ENGINEERING

DRAWN BY T. SPECA (FOR JMT)
DES. BY: M. WOLNIAK (FOR JMT)
CHK. BY: 1-24-89

PINEY MEETINGHOUSE ROAD AT RIVER ROAD (MD 190) INTERCONNECT PLAN

COUNTY: MONTGOMERY

DATE: 8/25/88
SCALE: 1"=50'
F.A.P. NO.
S.H.A. NO. M626-509-385
TS/FILE NO. 2526 X-3
SHEET NO. 6 OF 15

15019006, 48