F H W A REGION NO.	STATE	FED. AID PROJ. NO.	SHEET NO.	TOTAL SHEETS
3	MD			

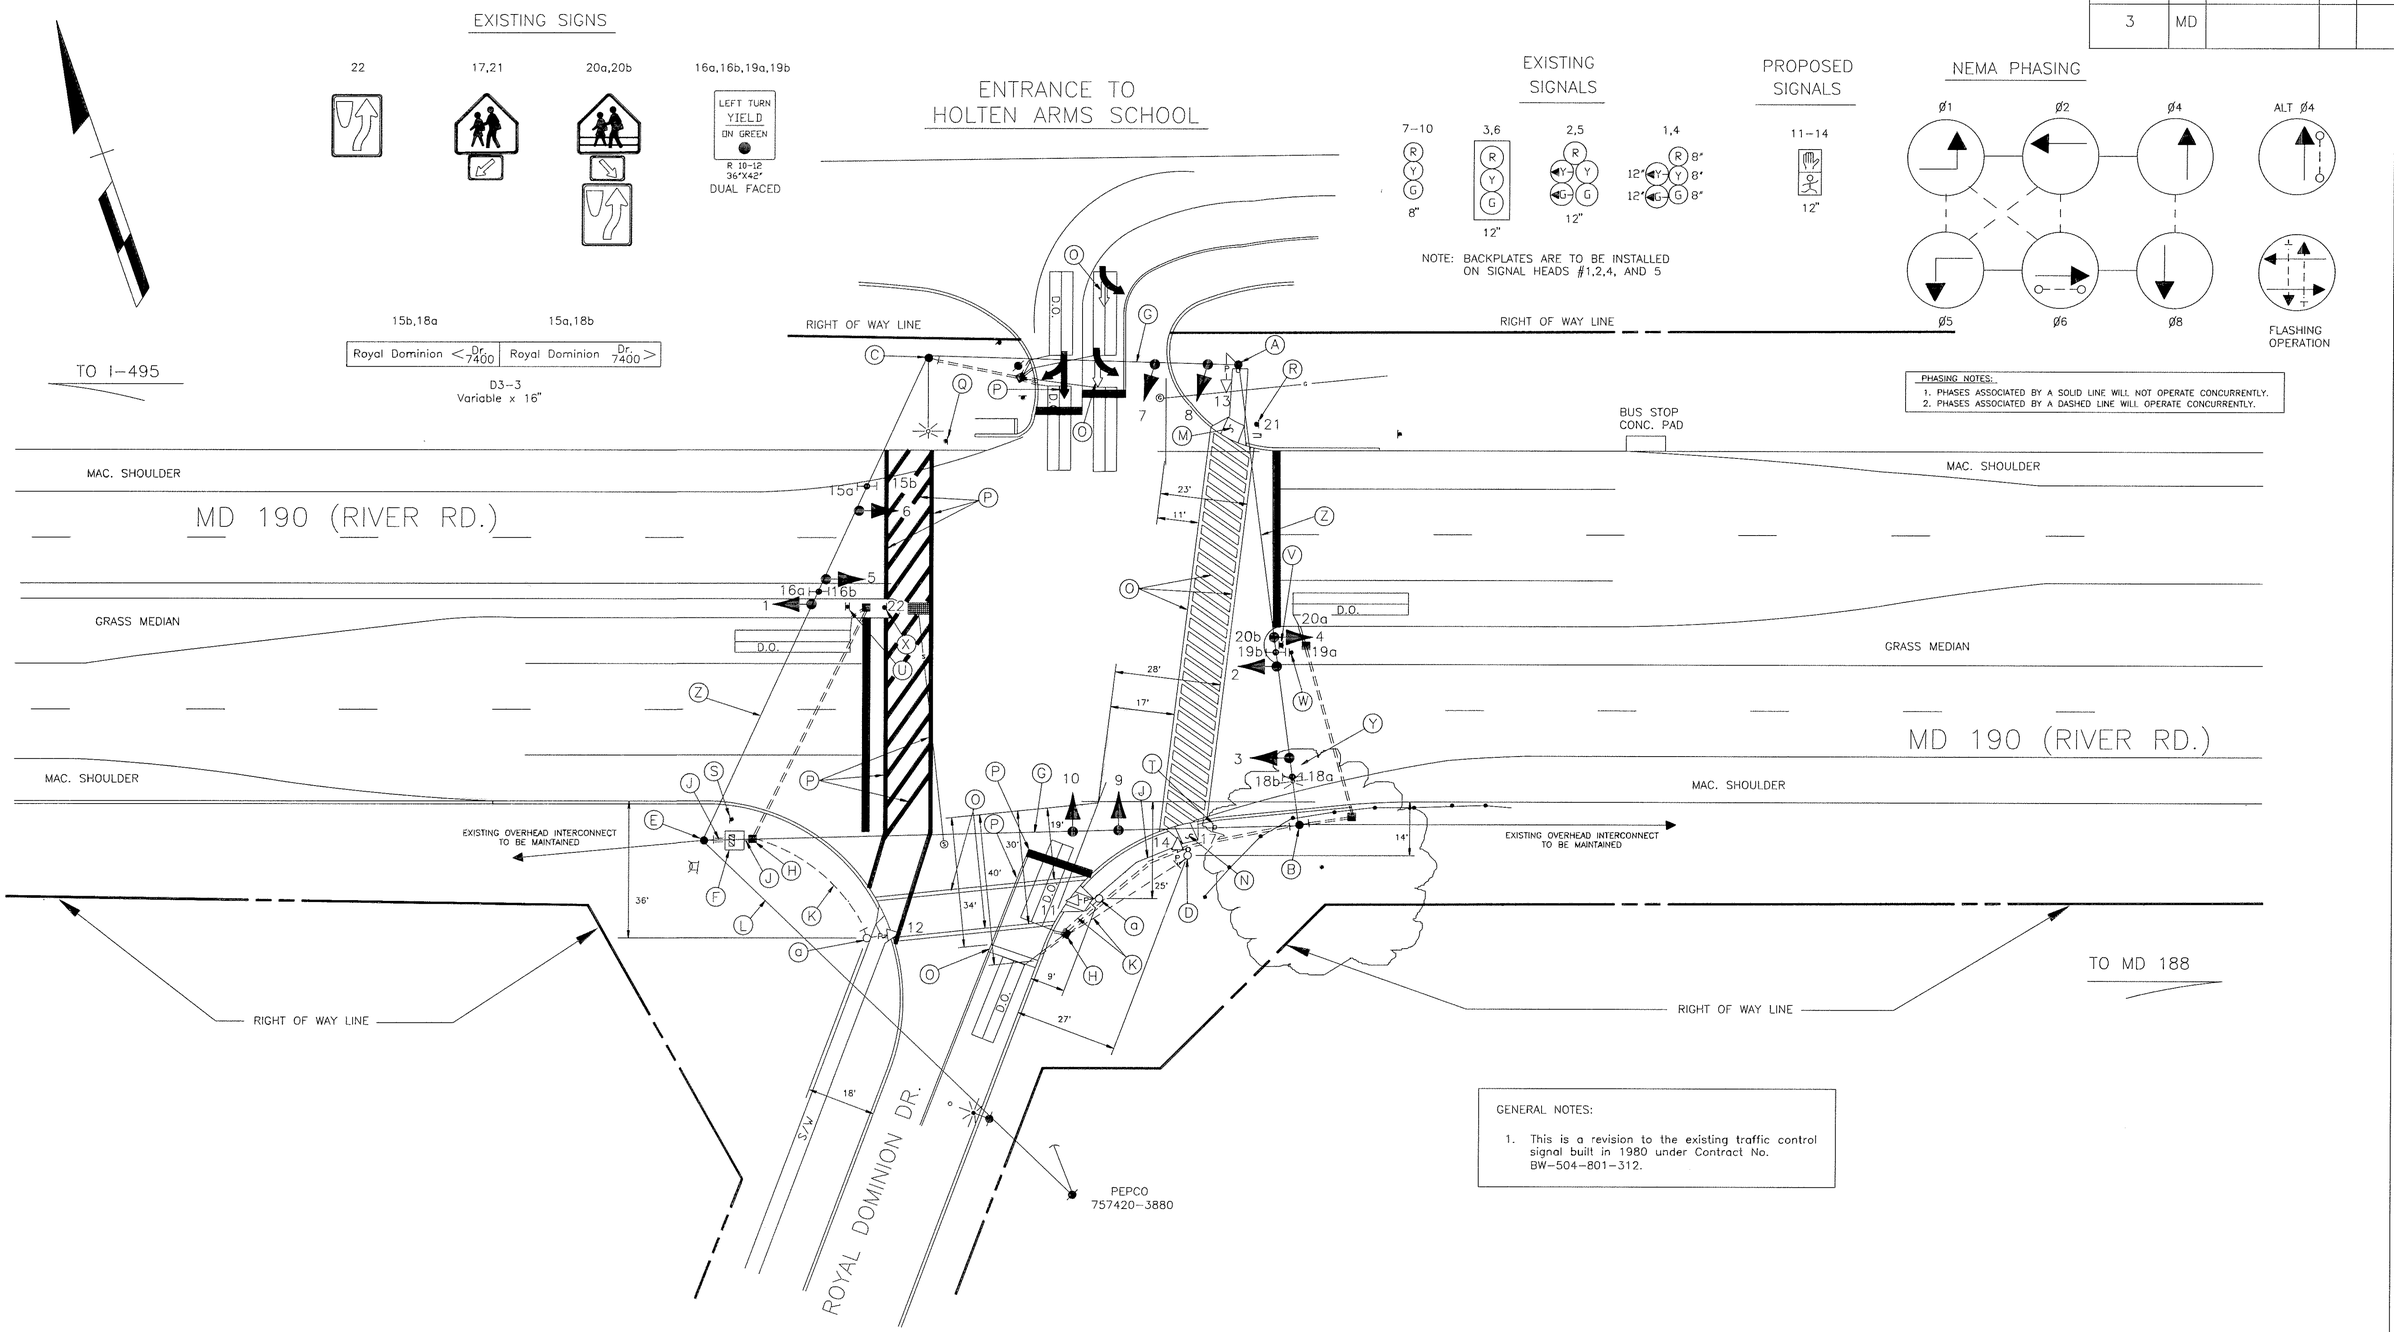

LEGEND OF UNDERGROUND AND OVERHEAD UTILITIES

AERIAL CABLE	A — A — A
ELECTRIC	E — E — E
TELEPHONE	T — T — T
GAS	G — G — G
SEWER	S — S — S
WATER	W — W — W
CABLE TV	TV — TV — TV

REVISION "B"

STREET TRAFFIC STUDIES, LTD.
Gateway International
1302 Concourse Drive, Suite 104
Linthicum, Maryland 21090
(410) 859-3553

2318

REVISIONS

(B) 1-27-93
ADD PED PHASES AND STREET LIGHTING, ASBUILT
SHA NO.:
RRZ
A 6-12-91
ADD SIGNAL HEADS AND SIGNS, ASBUILT
SHA NO.: M-651-501-377

APPROVALS

ORIGINAL ON FILE

CHIEF, SIGNAL DESIGN SECTION
ASST. DISTRICT ENGINEER, TRAFFIC
CHIEF, TRAFFIC ENGINEERING DESIGN DIVISION
DIRECTOR, OFFICE OF TRAFFIC AND SAFETY

MDOT – STATE HIGHWAY ADMINISTRATION

Office of Traffic and Safety

TRAFFIC ENGINEERING DESIGN DIVISION

DRAWN BY: J.W.G.
DES. BY:
CHK. BY:

MD 190 (RIVER RD.) AND ROYAL DOMINION DR.
SIGNAL NO. – 15019012.03
COUNTY MONTGOMERY

DATE: 5-14-80
SCALE: 1"=20'
F.A.P. NO.
S.H.A. NO. BW-504-801-312

TS/STD. NO. 1773B

SHEET NO. 1 OF 1