F H W A REGION NO.	STATE	FED. AID PROJ. NO.	SHEET NO.	TOTAL SHEETS
3	MD		4	9

PROPOSED SIGNS

12b,13a		12a,13b	
Whittier	Blvd. <6600	Winston	Dr. <6200
Winston	Dr. 6200>	Whittier	Blvd. 6600>

D3-2
Variable x 32"

EXISTING SIGNS

15 — ONLY — R 3-5(L) 36"X 36"

14 — NO TURN ON RED — R10-6R 30"X36"

16 — R3-6R 30"X36"

EXISTING SIGNALS

1-4, 8,9 — R Y G — 12"

5-7 — R Y G — 8"

10,11 — 12"

NEMA PHASING

PHASING NOTES:
PHASES ASSOCIATED BY A DASHED LINE WILL OPERATE CONCURRENTLY
PHASES ASSOCIATED BY A SOLID LINE WILL NOT OPERATE CONCURRENTLY

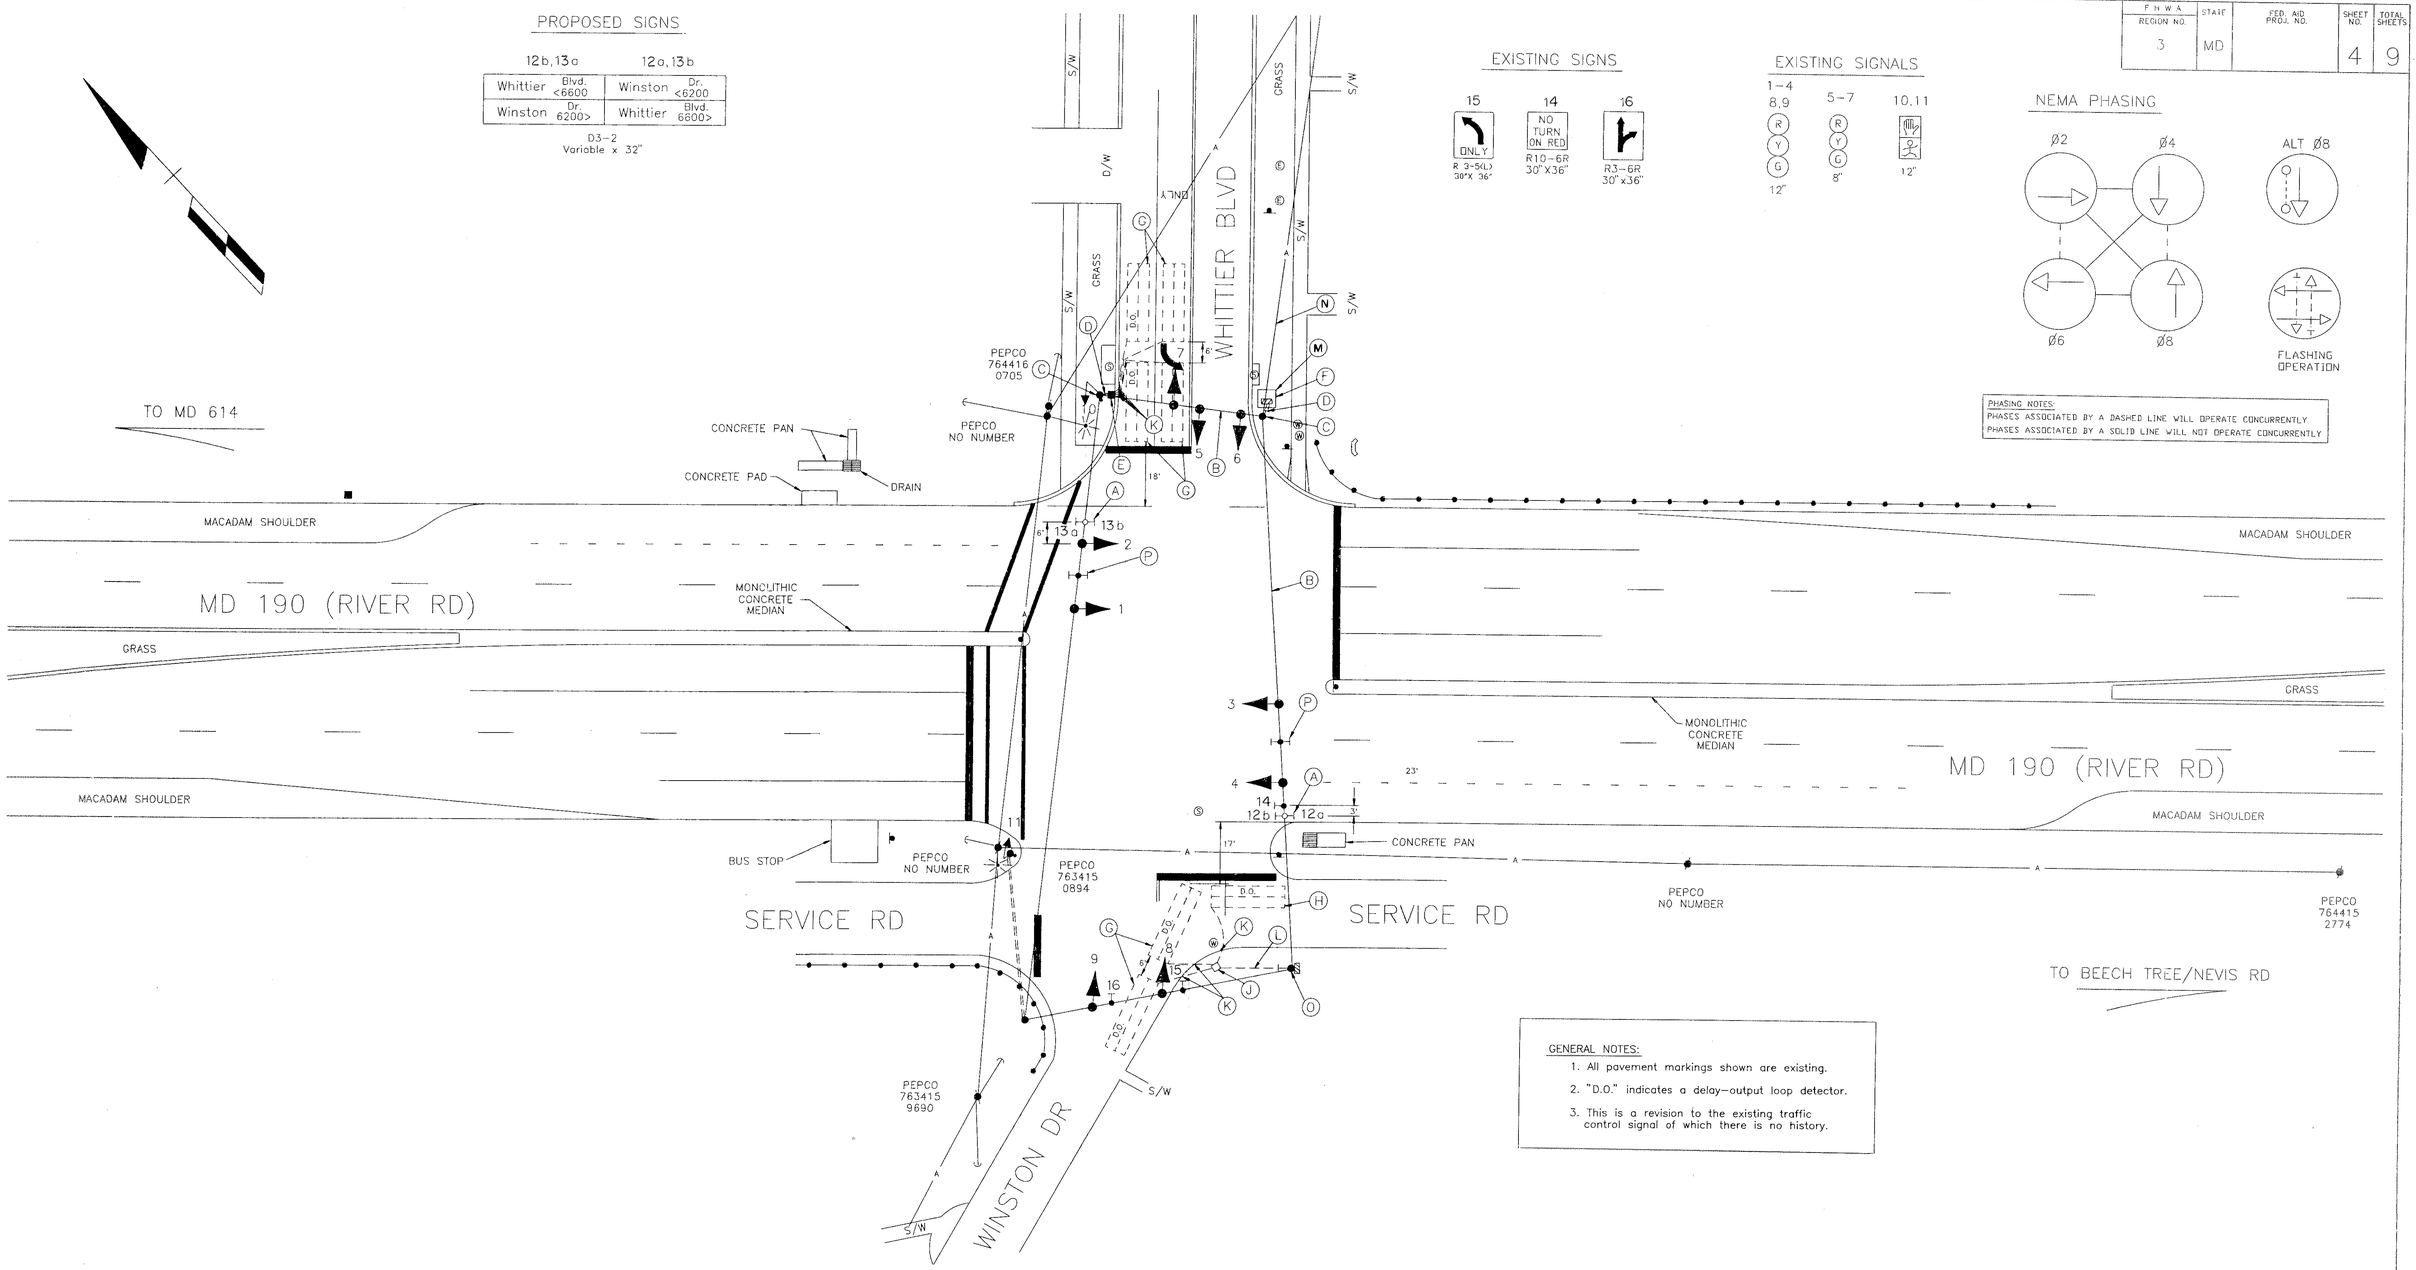

GENERAL NOTES:
1. All pavement markings shown are existing.
2. "D.O." indicates a delay-output loop detector.
3. This is a revision to the existing traffic control signal of which there is no history.

LEGEND OF UNDERGROUND AND OVERHEAD UTILITIES

AERIAL CABLE	A — A — A
ELECTRIC	E — E — E
TELEPHONE	T — T — T
GAS	G — G — G
SEWER	S — S — S
WATER	W — W — W
CABLE TV	TV — TV — TV

STREET TRAFFIC STUDIES, LTD.
Gateway International
1302 Concourse Drive, Suite 104
Linthicum, Maryland 21090
(301) 859-3553
WINSTON

REVISIONS
(A) 6-12-91
ADD SIGNS, LOOPS, AND ASBUILD
S.H.A. NO. M-651-501-377
R.R.Z.

APPROVALS
ORIGINAL ON FILE
CHIEF, DESIGN SECTION
ASST. DISTRICT ENGINEER, TRAFFIC
CHIEF, TRAFFIC ENGINEERING DIVISION
DEPUTY CHIEF ENGINEER, TRAFFIC

MDOT – STATE HIGHWAY ADMINISTRATION
Office of Traffic
TRAFFIC ENGINEERING DIVISION

LOG MILE NO: 15019013.62

DRAWN BY: W J NIES (FOR STS)
DES. BY: R R ZACHERL (FOR STS)
CHK. BY:

MD 190 AND WHITTIER BLVD/WINSTON DR
COUNTY MONTGOMERY

DATE: 6-12-91
SCALE: 1"=20'
F.A.P. NO.
S.H.A. NO.
TS/STD. NO. 3176A
SHEET NO. 4 OF 9

F#22 15019013.62