| F H W A REGION NO. | STATE | FED. AID PROJ. NO. | SHEET NO. | TOTAL SHEETS |
|---|---|---|---|---|
| 3 | MD | | 6 | 9 |

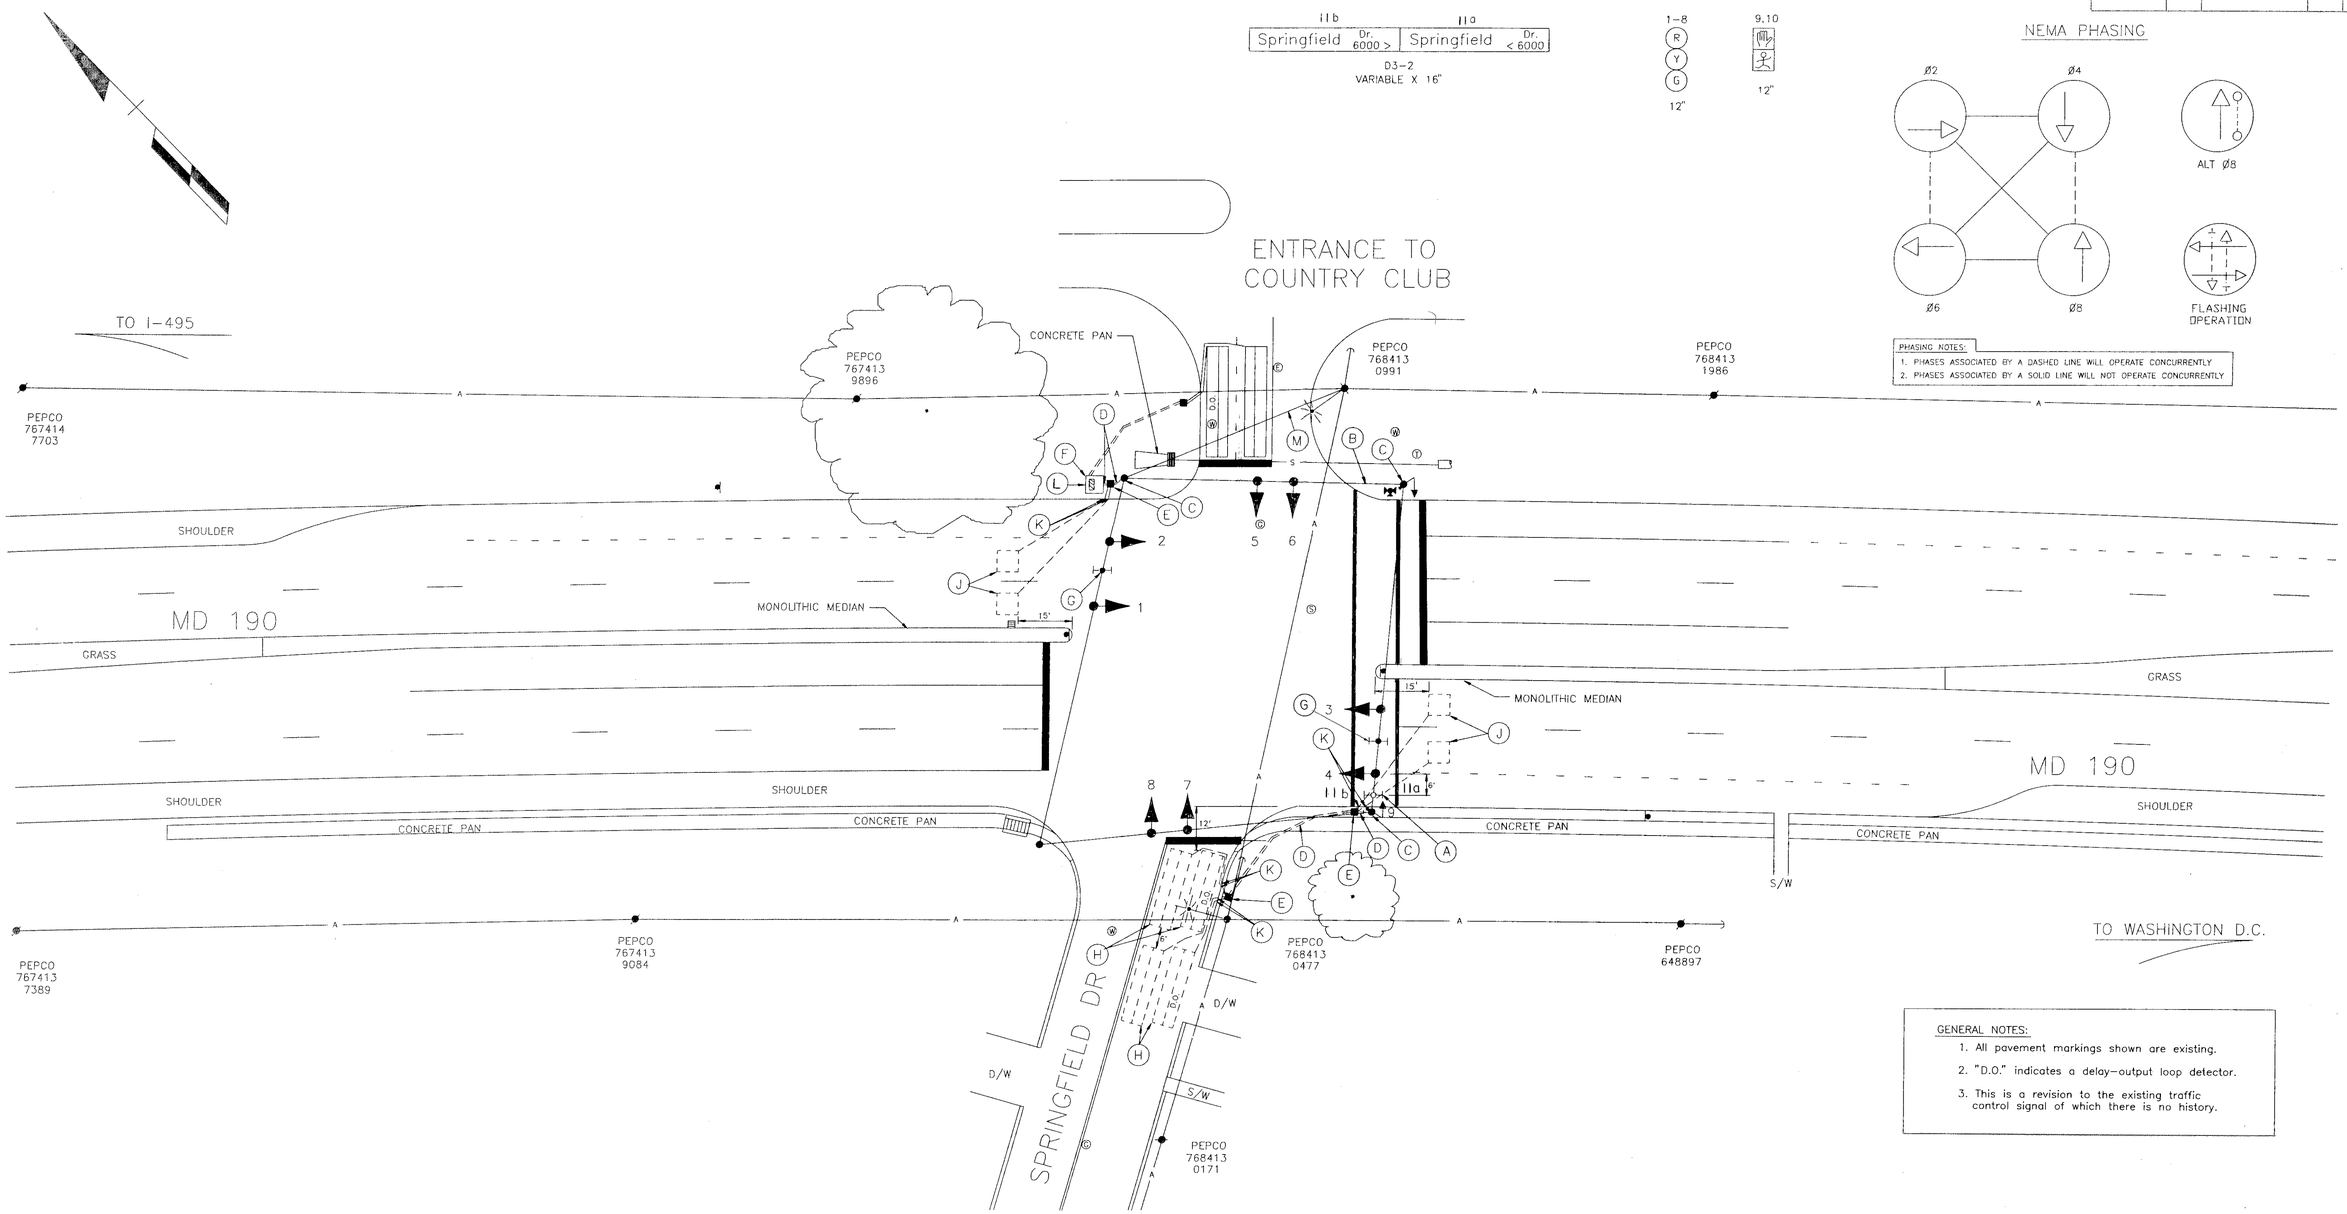


GENERAL NOTES:

1. All pavement markings shown are existing.
2. "D.O." indicates a delay-output loop detector.
3. This is a revision to the existing traffic control signal of which there is no history.

LEGEND OF UNDERGROUND AND OVERHEAD UTILITIES

| | | | |
|---|---|---|---|
| AERIAL CABLE | A | A | A |
| ELECTRIC | E | E | E |
| TELEPHONE | T | T | T |
| GAS | G | G | G |
| SEWER | S | S | S |
| WATER | W | W | W |
| CABLE TV | TV | TV | TV |

STREET TRAFFIC STUDIES, LTD.
Gateway International
1302 Concourse Drive, Suite 104
Linthicum, Maryland 21090
(301) 859-3553
SPRING

REVISIONS

(A) 6-12-91 ADD SIGNS, LOOPS, AND ASBUILD
S.H.A. NO. M-651-501-377
R.R.Z. | | | | TR 9/2

APPROVALS

CHIEF, DESIGN SECTION
ASST. DISTRICT ENGINEER, TRAFFIC
CHIEF, TRAFFIC ENGINEERING DIVISION
DEPUTY CHIEF ENGINEER, TRAFFIC

ORIGINAL ON FILE

# MDOT – STATE HIGHWAY ADMINISTRATION
*Office of Traffic*
TRAFFIC ENGINEERING DIVISION

LOG MILE NO.: 15019014.51

DRAWN BY: W.J. NIES (FOR S.T.S. LTD.)
DES. BY: R.R. ZACHERL (FOR S.T.S. LTD.)
CHK. BY:

MD 190 AND SPRINGFIELD DR
COUNTY MONTGOMERY

DATE: 6-12-91
SCALE: 1"=20'
F.A.P. NO.
S.H.A. NO.

TS/STD. NO. 3177A
SHEET NO. 6 OF 9

F# 37 15019014.51