K&E 19 1153 6-81 MC 2647•

| F.H.W.A. REGION NO. | STATE | FED. AID PROJ. NO. | SHEET NO. | TOTAL SHEETS |
|---|---|---|---|---|
| 3 | MD. | | | |

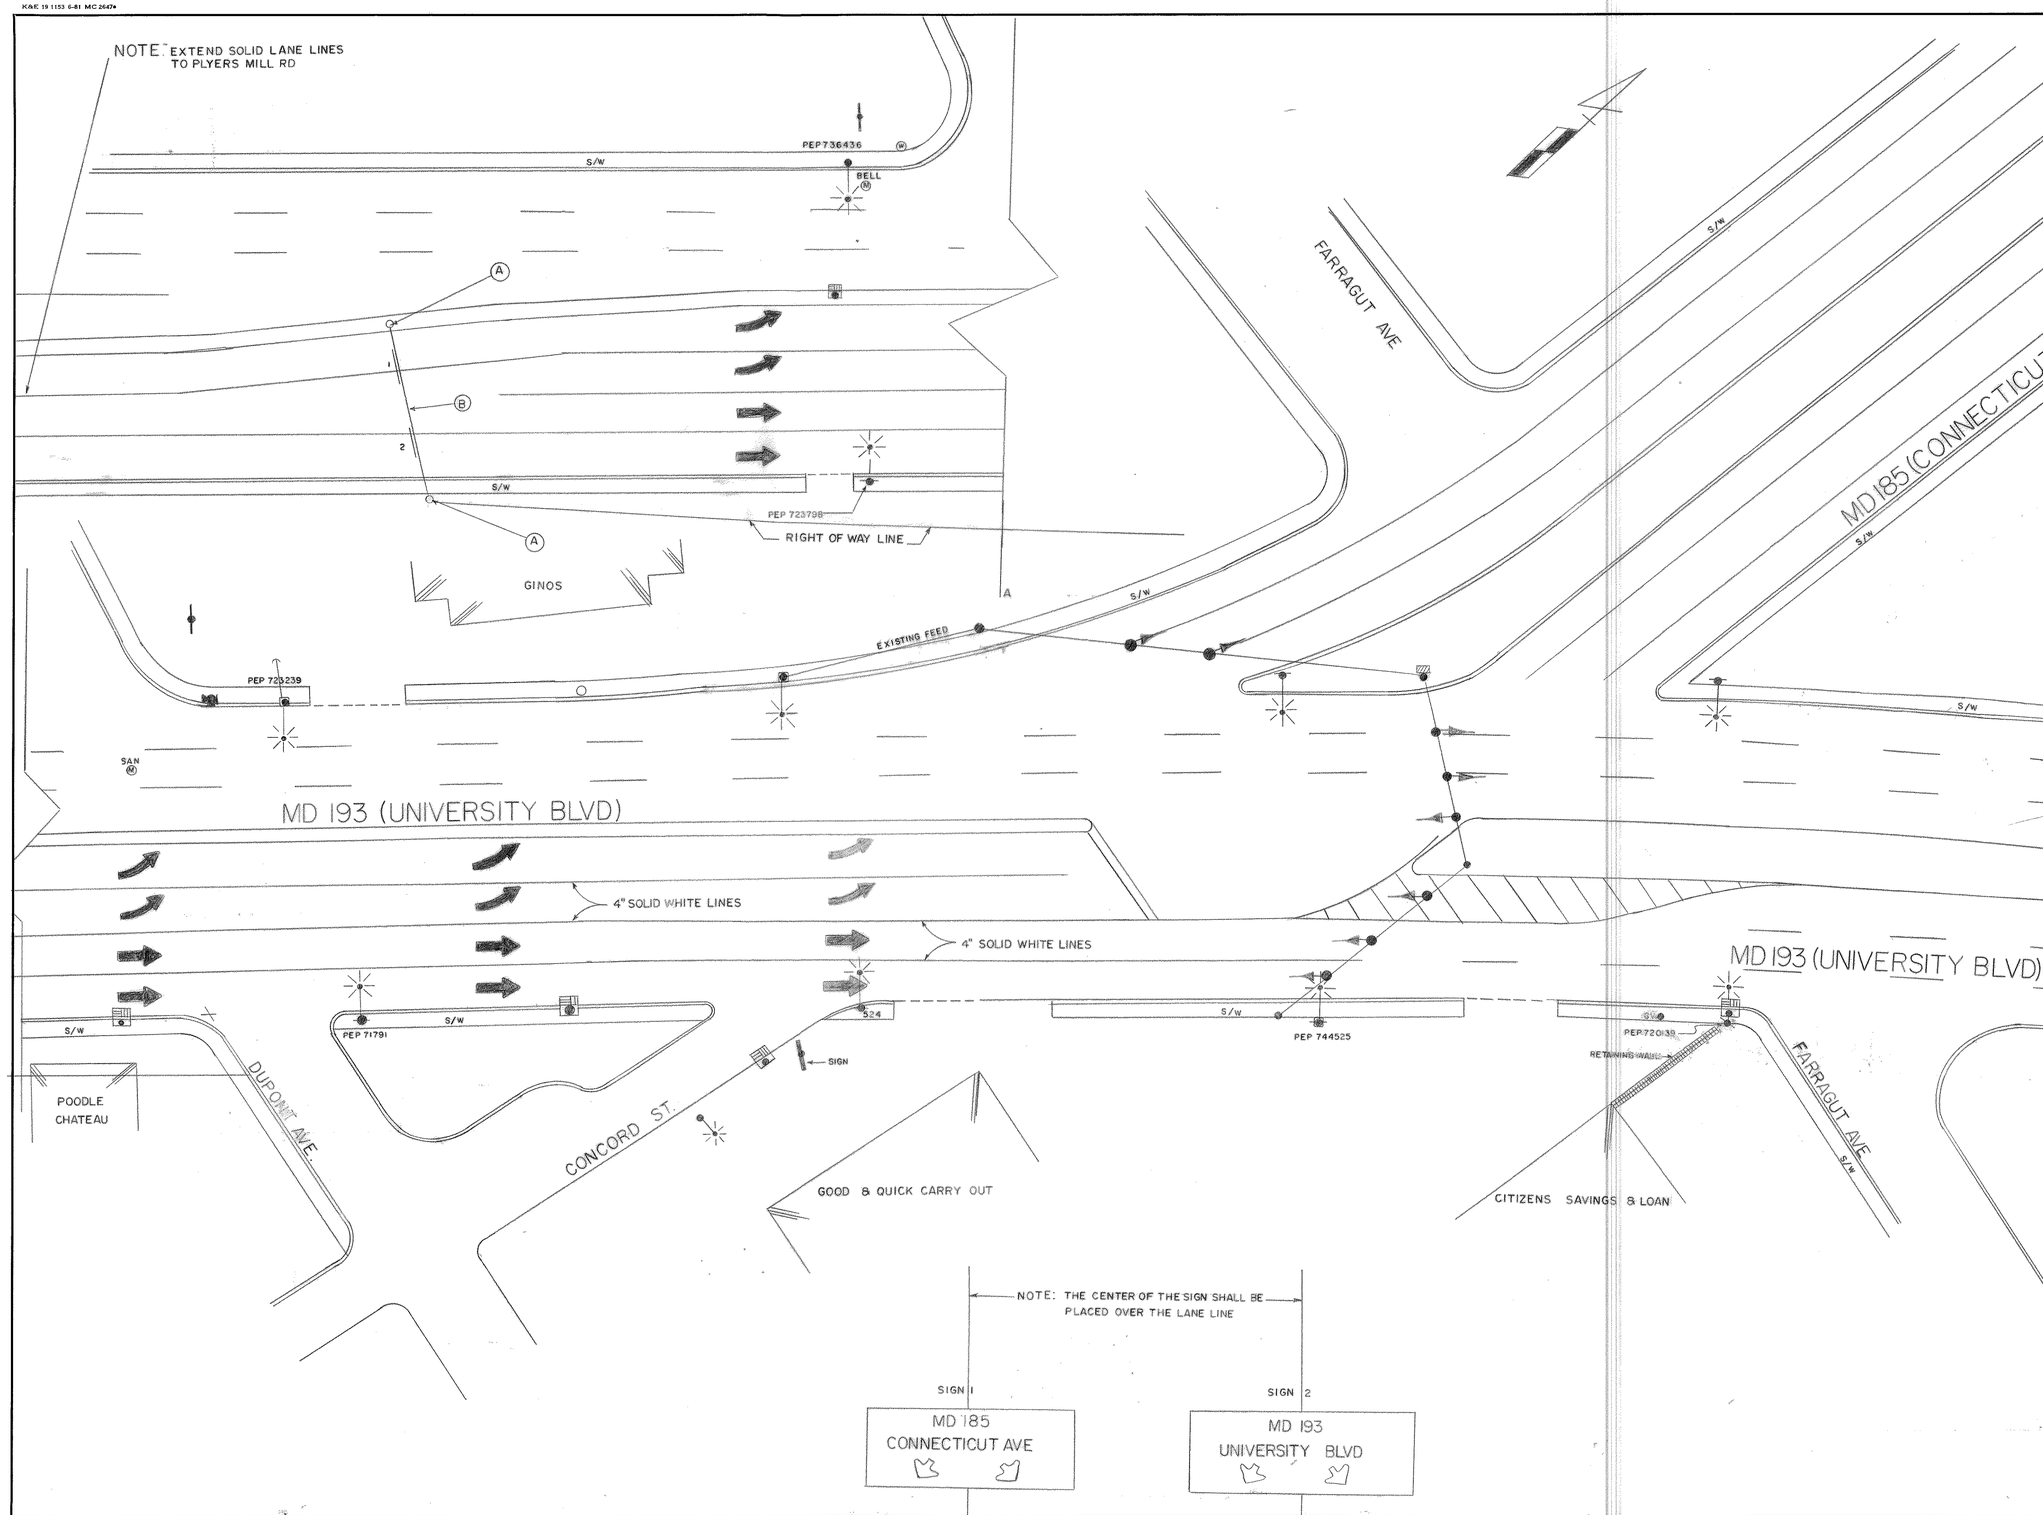


APPROVAL: CHIEF SIGNAL DESIGN SECTION

JOHN FORREST 1/8/73
APPROVAL: REGIONAL TRAFFIC ENGINEER

APPROVAL: CHIEF-BUREAU TRAFFIC ENGINEERING

THOMAS HICKS 2/22/73
APPROVAL: ASS'T. CHIEF ENGINEER TRAFFIC

| | |
|---|---|
| B | 7/20/83 RE-DRAWN |
| JEP | |
| A | 7/16/73 ASBUILT |
| DD | HR / WF |

REVISIONS

STATE OF MARYLAND
DEPARTMENT OF TRANSPORTATION
STATE HIGHWAY ADMINISTRATION

TRAFFIC DIVISION BUREAU OF TRAFFIC ENGINEERING

# MD 193 & MD 185

SCALE 1"=20' DATE 11/13/72 CONTRACT NO. AW-892-006-075

DRAWN BY: J. GORDON COUNTY: MONGOMERY

DESIGNED BY: SIGNAL NO.:

CHECKED BY: W F FITCH

DRAWING NO. TS-785B