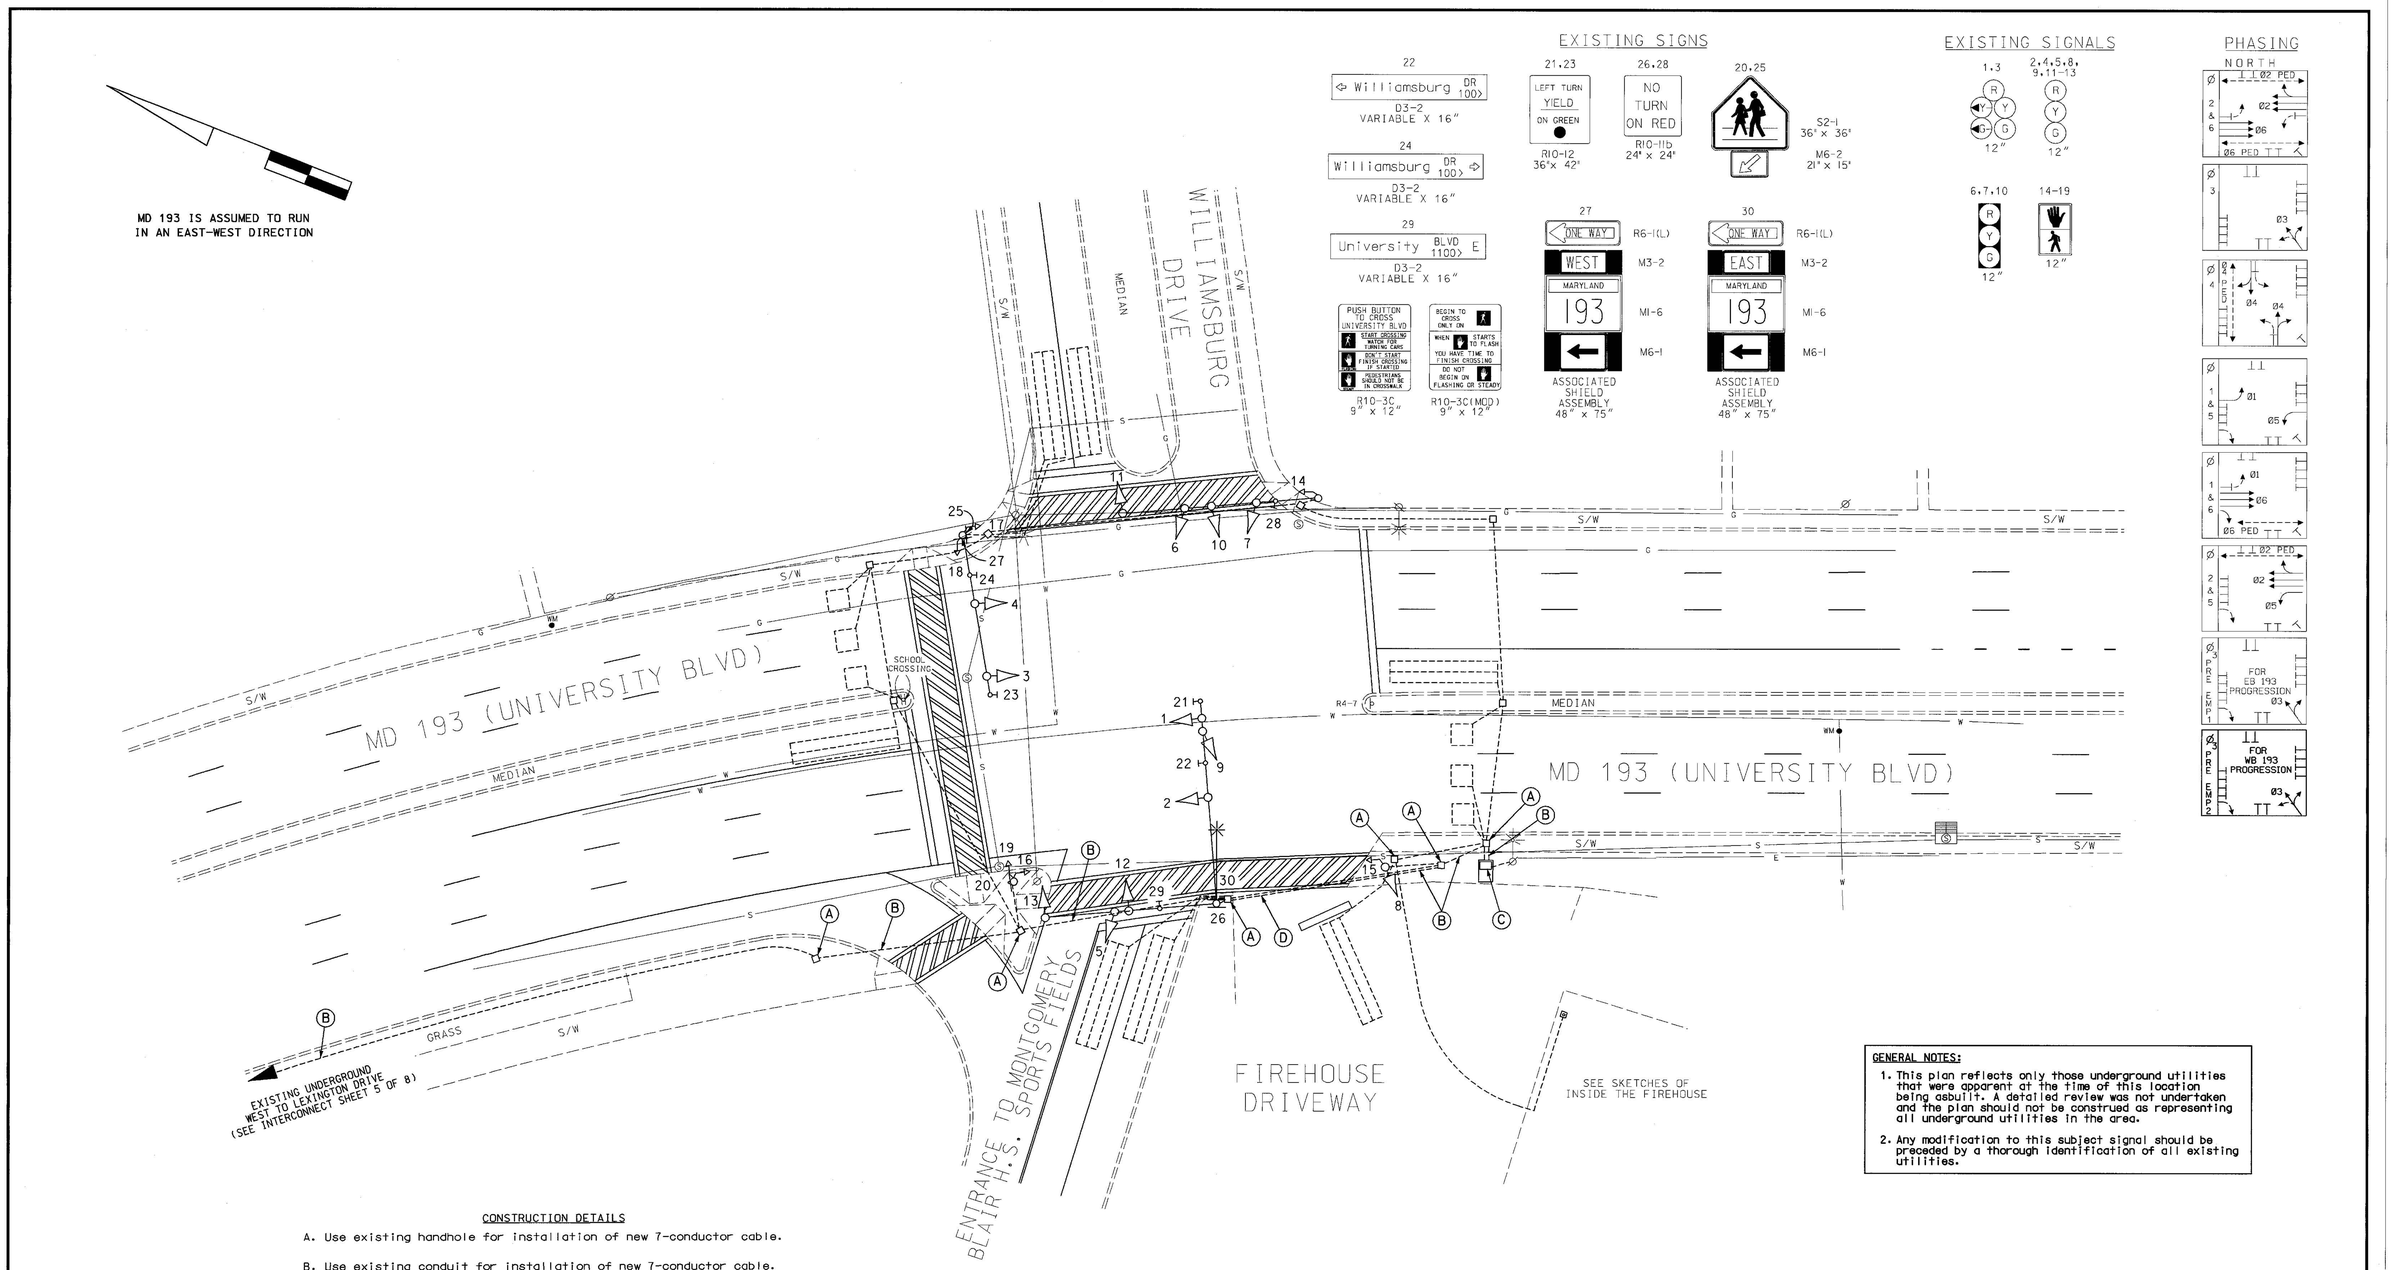

GENERAL NOTES:

1. This plan reflects only those underground utilities that were apparent at the time of this location being asbuilt. A detailed review was not undertaken and the plan should not be construed as representing all underground utilities in the area.
2. Any modification to this subject signal should be preceded by a thorough identification of all existing utilities.

CONSTRUCTION DETAILS

A. Use existing handhole for installation of new 7-conductor cable.

B. Use existing conduit for installation of new 7-conductor cable.

C. Use existing base mounted cabinet for installation of new 7-conductor cable.

D. Install 3" polyvinyl chloride electrical conduit (Scheudle 80) (slotted) for installation of new 7 conductor cable.

GEOMETRIC LEGEND

PROPOSED
EXISTING

LEGEND OF UNDERGROUND AND OVERHEAD UTILITIES

AERIAL CABLE	A	A
ELECTRIC	E	E
TELEPHONE	T	T
GAS	G	G
SEWER	S	S
WATER	W	W
CABLE TV	TV	TV

REVISION "B"

STREET TRAFFIC STUDIES, LTD.
400 Crain Hwy.,N.W.
Glen Burnie,MD 21061
Ph (410) 590-5500
Fax (410) 590-6637

4261a.dgn TASK-66

REVISIONS	APPROVALS
B 3-19-03 PROVIDE PRE-EMPTION PHASE ALONG WB MD 193 SHA NO.: AT2885185	TEAM LEADER, TRAFFIC ENGINEERING DESIGN DIVISION
RRZ	ASST. CHIEF, TRAFFIC ENGINEERING DESIGN DIVISION
A ASBUILT SHA NO.: M 425-502-370	CHIEF, TRAFFIC ENGINEERING DESIGN DIVISION
RAVI	DIRECTOR, TRAFFIC & SAFETY

ORIGINAL ON FILE

MARYLAND DOT - STATE HIGHWAY ADMINISTRATION
Office of Traffic & Safety
TRAFFIC ENGINEERING DESIGN DIVISION
MD 193 (UNIVERSITY BLVD) AND WILLIAMSBURG DR / SILVER SPRING F.H. DWY

DRAWN BY:	ZAJ	F.A.P. NO.		TS 3560 B ~~3534 B~~	SHEET NO.
CHECKED BY:		S.H.A. NO.	M 425 502 370		
SCALE:	1"= 20'	COUNTY:	MONTGOMERY	T.I.M.S. NO.	1 OF 8
DATE:	10-95	LOG MILE:	15019304.71	F405	

x:\signaldesign\4261\4261a.dgn Mar. 24, 2003 14:56:48