DRILL HOLES

BORDER REV. DATE: June 1, 2004

MD 193 IS CONSIDERED TO RUN IN AN EAST-WEST DIRECTION

EQUIPMENT LIST

B. EQUIPMENT TO BE FURNISHED AND INSTALLED BY THE CONTRACTOR

CAT NO.	DESCRIPTION	QUANTITY
805050 ~~800000~~	3" ~~4"~~ PVC WEATHERHEAD	1 EA
822002	12-PAIR INTERCONNECT CABLE (UNDERGROUND)	90 LF
833060 ~~833062~~	3" ~~4"~~ PVC (SCHEDULE 80) RISER	35 LF
800000	Disconnect, pullback and reroute 12 pair interconnect cable.	200 LF

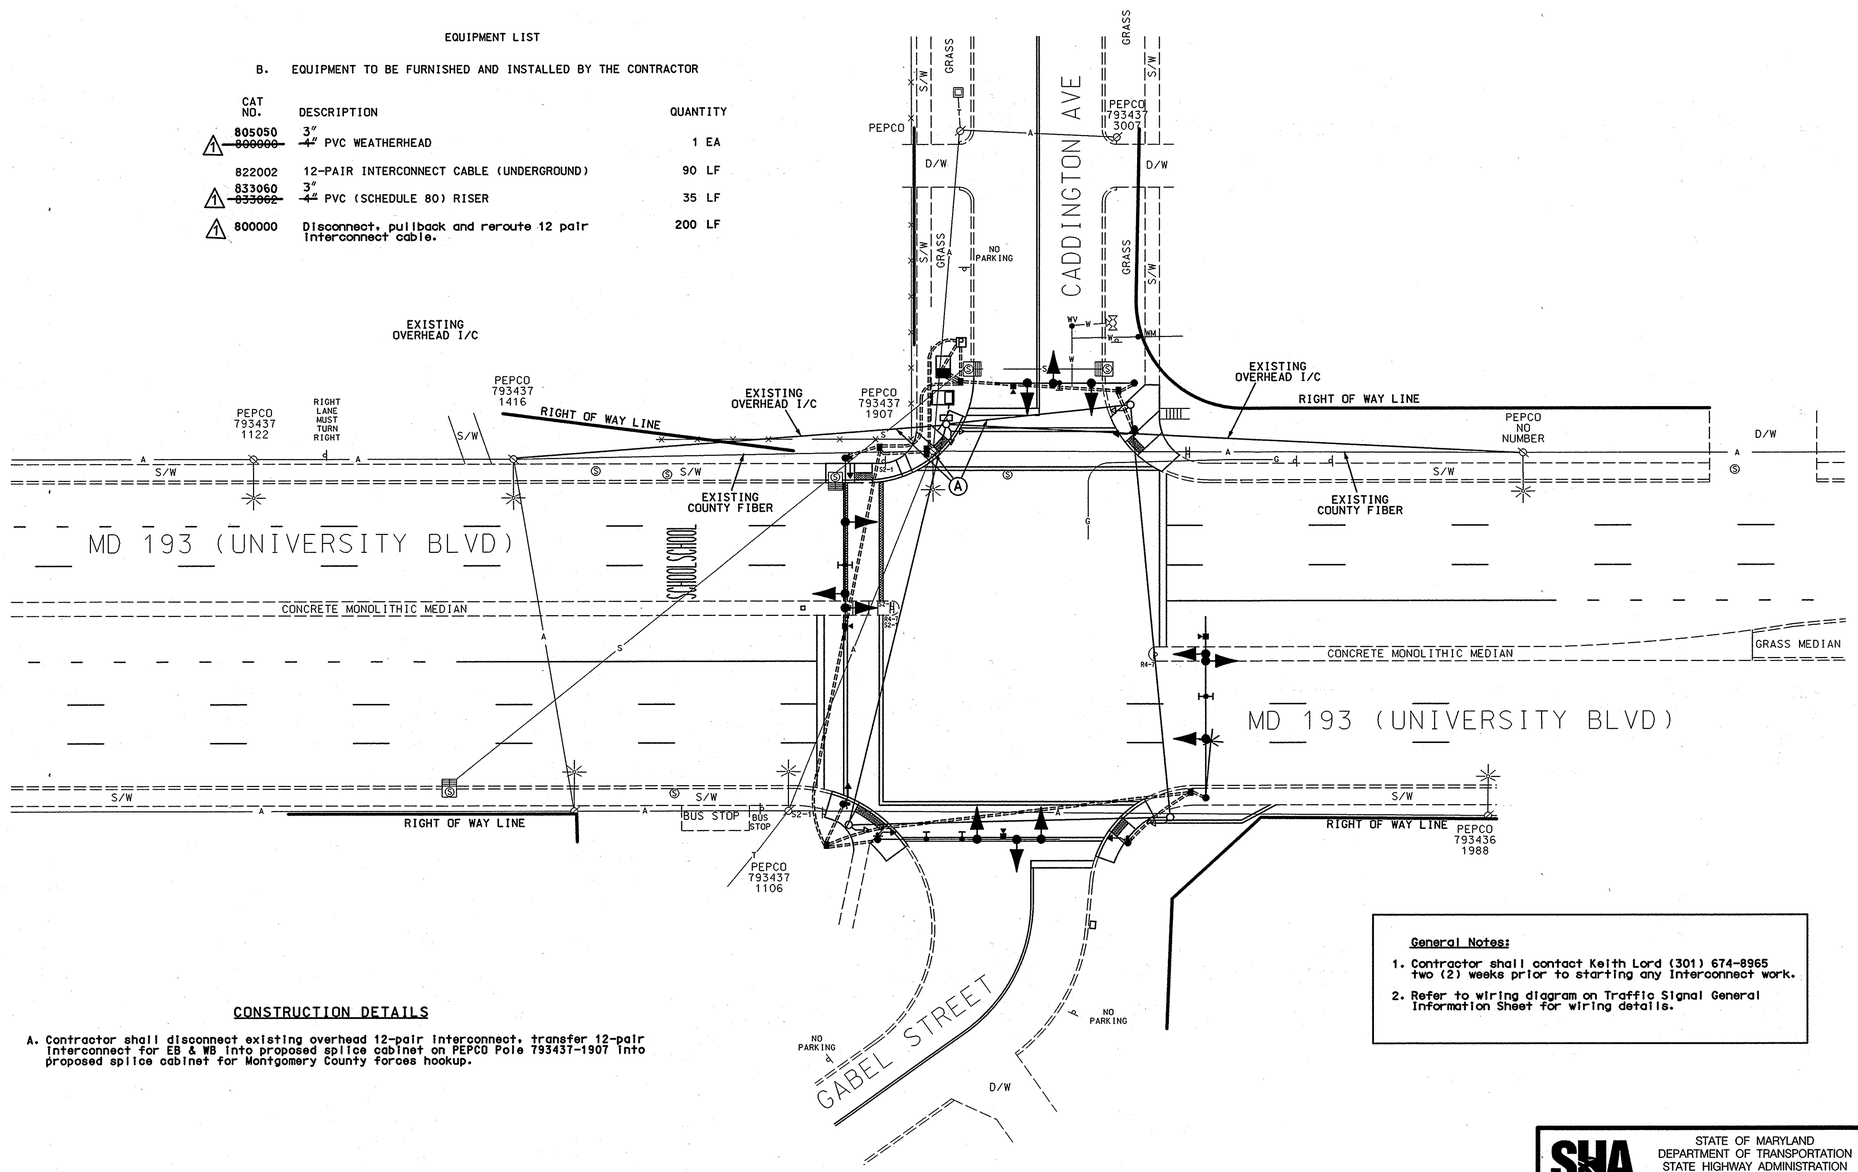

General Notes:

1. Contractor shall contact Keith Lord (301) 674-8965 two (2) weeks prior to starting any interconnect work.
2. Refer to wiring diagram on Traffic Signal General Information Sheet for wiring details.

CONSTRUCTION DETAILS

A. Contractor shall disconnect existing overhead 12-pair interconnect, transfer 12-pair interconnect for EB & WB into proposed splice cabinet on PEPCO Pole 793437-1907 into proposed splice cabinet for Montgomery County forces hookup.

GEOMETRIC LEGEND

PROPOSED
EXISTING

LEGEND OF UNDERGROUND AND OVERHEAD UTILITIES

AERIAL CABLE	—A—A—	
ELECTRIC	—E—E—	
TELEPHONE	—T—T—	
GAS	—G—G—	
SEWER	—S—S—	
WATER	—W—W—	
CABLE TV	—TV—TV—	

1 ADDENDUM 1: DATE: 10-16-07

REVISION "B"

STREET TRAFFIC STUDIES, LTD.
400 Crain Hwy. NW.
Glen Burnie, MD 21061
Ph (410) 590-5500
Fax (410) 590-5537

5197blc.dgn T-63

APPROVALS
TEAM LEADER
ASST. DIV. CHIEF
DIVISION CHIEF
OFFICE DIRECTOR

REVISIONS
B 6-18-07 RECONSTRUCT EXISTING TRAFFIC SIGNAL WITH APS & CPS SHA NO. 1402825185 JWA
A 12-7-06 INSTALL APS AND CPS ON NORTH, SOUTH AND WEST LEGS SHA NO. 1AT9255185 JWA

PLOTTED: $DATETIME$
FILE: $FILE$

STATE OF MARYLAND
DEPARTMENT OF TRANSPORTATION
STATE HIGHWAY ADMINISTRATION

MD 193 (UNIVERSITY BLVD)
AND
GABEL STREET / CADDINGTON AVENUE
SILVER SPRING, MD.

INTERCONNECT PLAN

SCALE 1"= 20' DATE _____ CONTRACT NO. _____

DESIGNED BY SHA COUNTY MONTGOMERY
DRAWN BY SHA LOGMILE 15019303.19
CHECKED BY SHA TIMS NO. I105
F.A.P. NO. AC-STPG-000A(241)E TOD NO. _____

TS NO. | DRAWING NO. 3 OF 4 | SHEET NO. 36 OF 42

$USER$ 10/18/2007 10:25:54 AM