F H WA REGION NO	STATE	FED. AID PROJ. NO	SHEET NO.	TOTAL SHEETS
3	MD.			

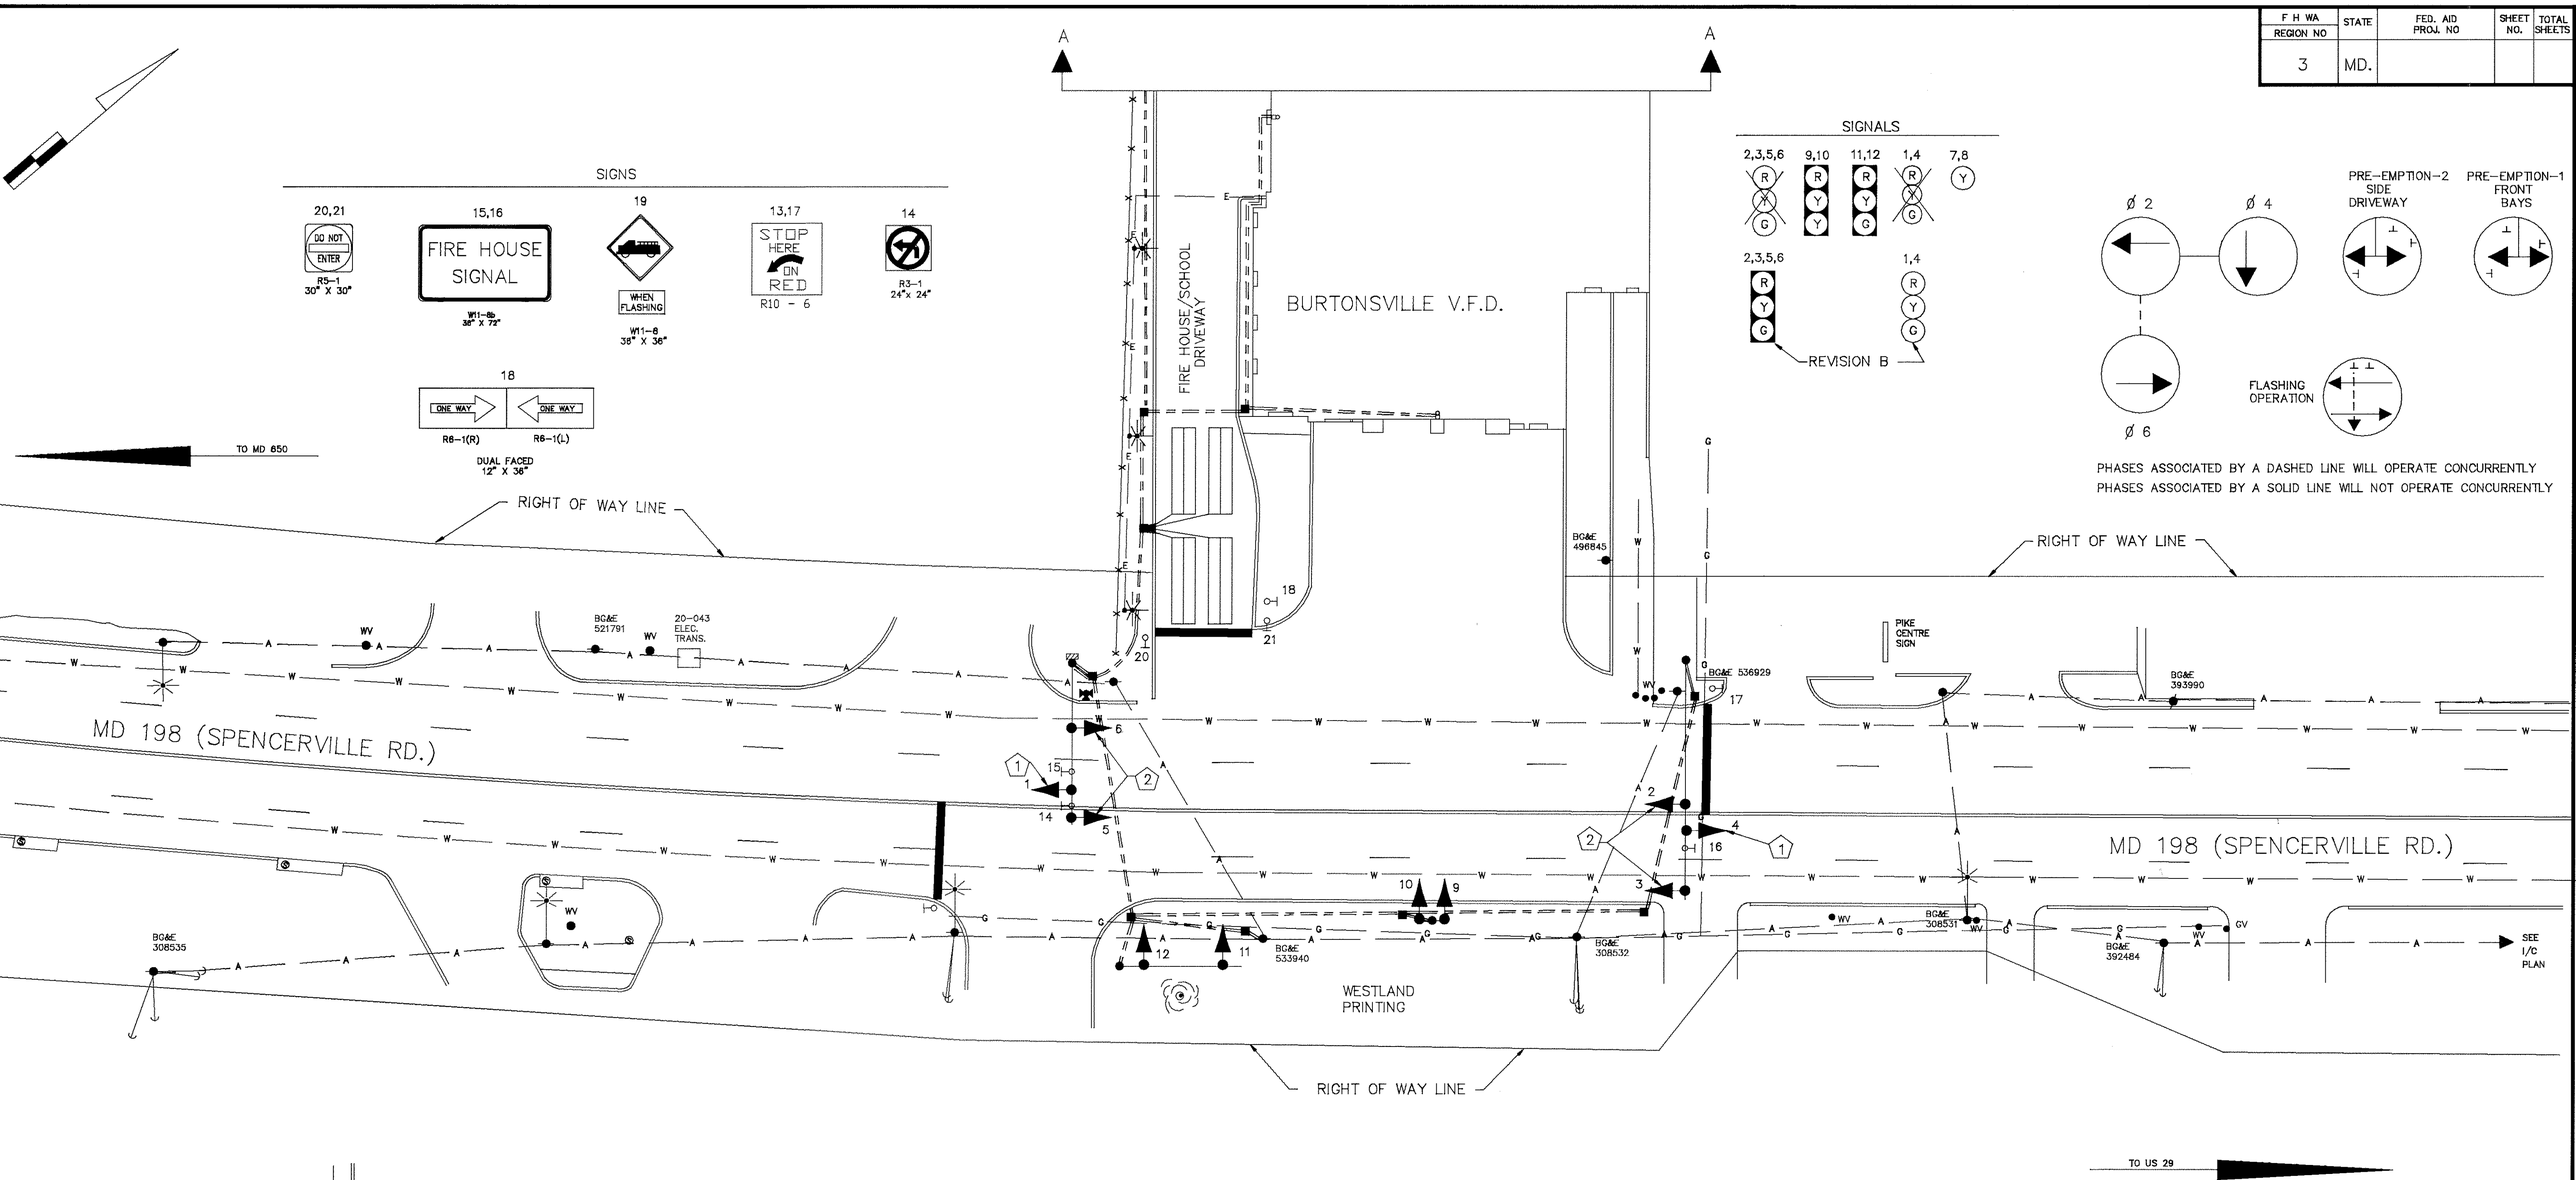

UTILITY LEGEND

—G—G—	GAS MAIN
—W—W—	WATER MAIN
—S—S—	SEWER MAIN
—E—E—	ELECTRIC CABLES
—A—A—	AERIAL CABLES

REVISIONS	APPROVALS
3/91 ASBUILT B CHANGE NEAR SIDE SIGNALS TO 12" AND MAIN LINE TO OPTICALLY PRO-GRAMMED. 8-21-90 A REVISED TO FULL COLOR SIGNAL WITH I/C. RRZ	CHIEF, SIGNAL DESIGN SECTION ASST. DISTRICT ENGINEER, TRAFFIC CHIEF, TRAFFIC ENGINEERING DIVISION DEPUTY CHIEF ENGINEER, OFFICE OF TRAFFIC

MARYLAND DEPARTMENT OF TRANSPORTATION
STATE HIGHWAY ADMINISTRATION – OFFICE OF TRAFFIC
TRAFFIC ENGINEERING DIVISION

DRAWN BY BRUCE THOMPSON (STS)
DES. BY: R.R.ZACHERL (STS)
CHK. BY: D.DODA

MD 198 and BURTONSVILLE V.F.D./
BURTONSVILLE ELEMENTARY SCHOOL EXIT

15019803.38 COUNTY: MONTGOMERY

DATE: REDRAWN 2-26-91 F.A.P. NO.
SCALE: 1"=20' S.H.A. NO.

TS/FILE NO. 3037 B

SHEET NO. ___ OF ___

15019803.38