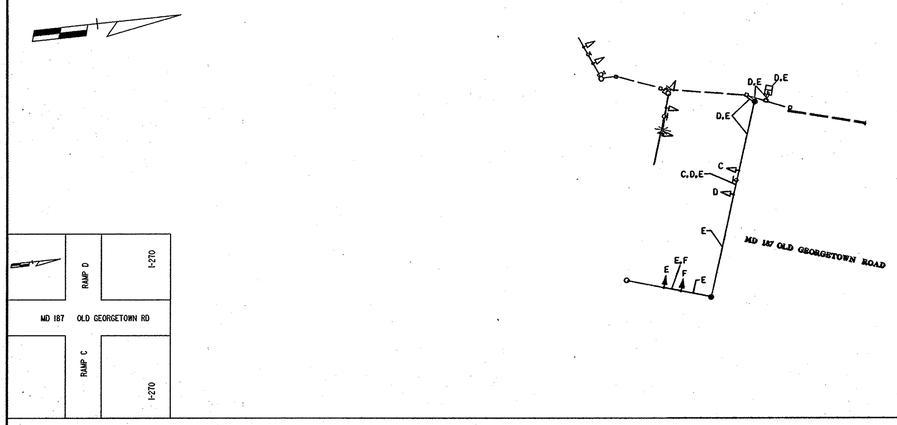

WIRING LEGEND:

C,D,E,F — 5 CONDUCTOR ELECTRICAL CABLE (NO.14 A.W.G.)
+ — 3/4" x 10' GROUND ROD

EQUIPMENT LIST 'A'

A. EQUIPMENT TO BE SUPPLIED BY THE SHA.

QUANTITY	UNIT	SPECIFICATION SECTION	DESCRIPTION
7	SF	813	FLAT SHEET ALUMINUM SIGNS CONSISTING OF: - 1 EACH R3-2 (30" X 30")-SPAN WIRE MOUNT

5

EQUIPMENT LIST 'B'

B. EQUIPMENT TO BE FURNISHED AND/OR INSTALLED BY THE CONTRACTOR.

QUANTITY	UNIT	DESCRIPTION
65	LF	24 INCH WHITE REMOVABLE PREFORMED PAVEMENT MARKING TAPE
7	SF	INSTALL OVERHEAD SIGN
510	LF	FURNISH AND INSTALL ELECTRICAL CABLE- 5 CONDUCTOR (NO 14 AWG)
1	LS	RELOCATE TEMPORARY WOOD POLE
2	EA	RELOCATE EXISTING SIGNAL HEAD
6	EA	FURNISH AND INSTALL 12 INCH VEHICULAR TRAFFIC SIGNAL HEAD SECTION
80	LF	FURNISH AND INSTALL 3/8 INCH STEEL SPAN WIRE
20	LF	FURNISH AND INSTALL 3 INCH SCHEDULE 80 RIGID PVC CONDUIT - TRENCHED

PHASE CHART

	1	2	3	4	5	6	7	8	9
PHASE 2 & 6	G	G	G	R	R	R	R	G	R
2 & 6 CHANGE	Y	Y	Y	R	R	R	R	Y	R
PHASE 4	R	R	R	G	G	G	G	R	G
4 CHANGE	R	R	R	Y	Y	Y	Y	R	Y
FLASHING OPERATION	FL/Y	FL/Y	FL/Y	FL/R	FL/R	FL/R	FL/R	FL/Y	FL/R

TS-12A

REVISION 'C'

KCI TECHNOLOGIES INC.
ENGINEERS AND PLANNERS
10 NORTH PARK DRIVE
HUNT VALLEY, MARYLAND
21030-1888
(410) 316-7800

REVISIONS

5 REDLINE REVISION NO. 5 NEW SHEET 9/4/2001

A ADDENDUM NO. 2 REPLACEMENT SHEET 11/30/00

C NEW MD 187 GEOMETRICS 10-00 SHA CONT. NO. MO8995172

B REVISED SIGNAL HEAD DISPLAY 10/14/76

APPROVALS

TEAM LEADER, TRAFFIC ENGINEERING DESIGN DIVISION
ORIGINAL
ASST. CHIEF TRAFFIC ENGINEERING DESIGN DIVISION
ON
CHIEF, TRAFFIC ENGINEERING DESIGN DIVISION
FILE
DIRECTOR, TRAFFIC & SAFETY

MARYLAND DOT - STATE HIGHWAY ADMINISTRATION
Office of Traffic & Safety
TRAFFIC ENGINEERING DESIGN DIVISION

I-270 INTERCHANGES AT ROCKLEDGE DRIVE AND MD 187
GENERAL INFORMATION SHEET (PHASE VI)
I-270 RAMP C/RAMP D AT MD 187 (OLD GEORGETOWN ROAD)

DRAWN BY: STEVE RENZI	F.A.P. NO.	TS NO. 1250C-GIX3	SHEET NO.
CHECKED BY: STEVE RENZI	S.H.A. NO.		
SCALE: NONE	COUNTY: MONTGOMERY	T.I.M.S. NO. D-311	263A OF 404
DATE: 12/27/74	LOG MILE: 15018703.73		

M:\1998\198078\TRAFFIC\

8/24/01 3:02:09 AM G:\PLOTTING\PS7\QCF\MYLAR_HP.qcf McSendy Pierre Division: Transportation m:\1998\0198078\TRAFFIC\SPMOT6B.prf