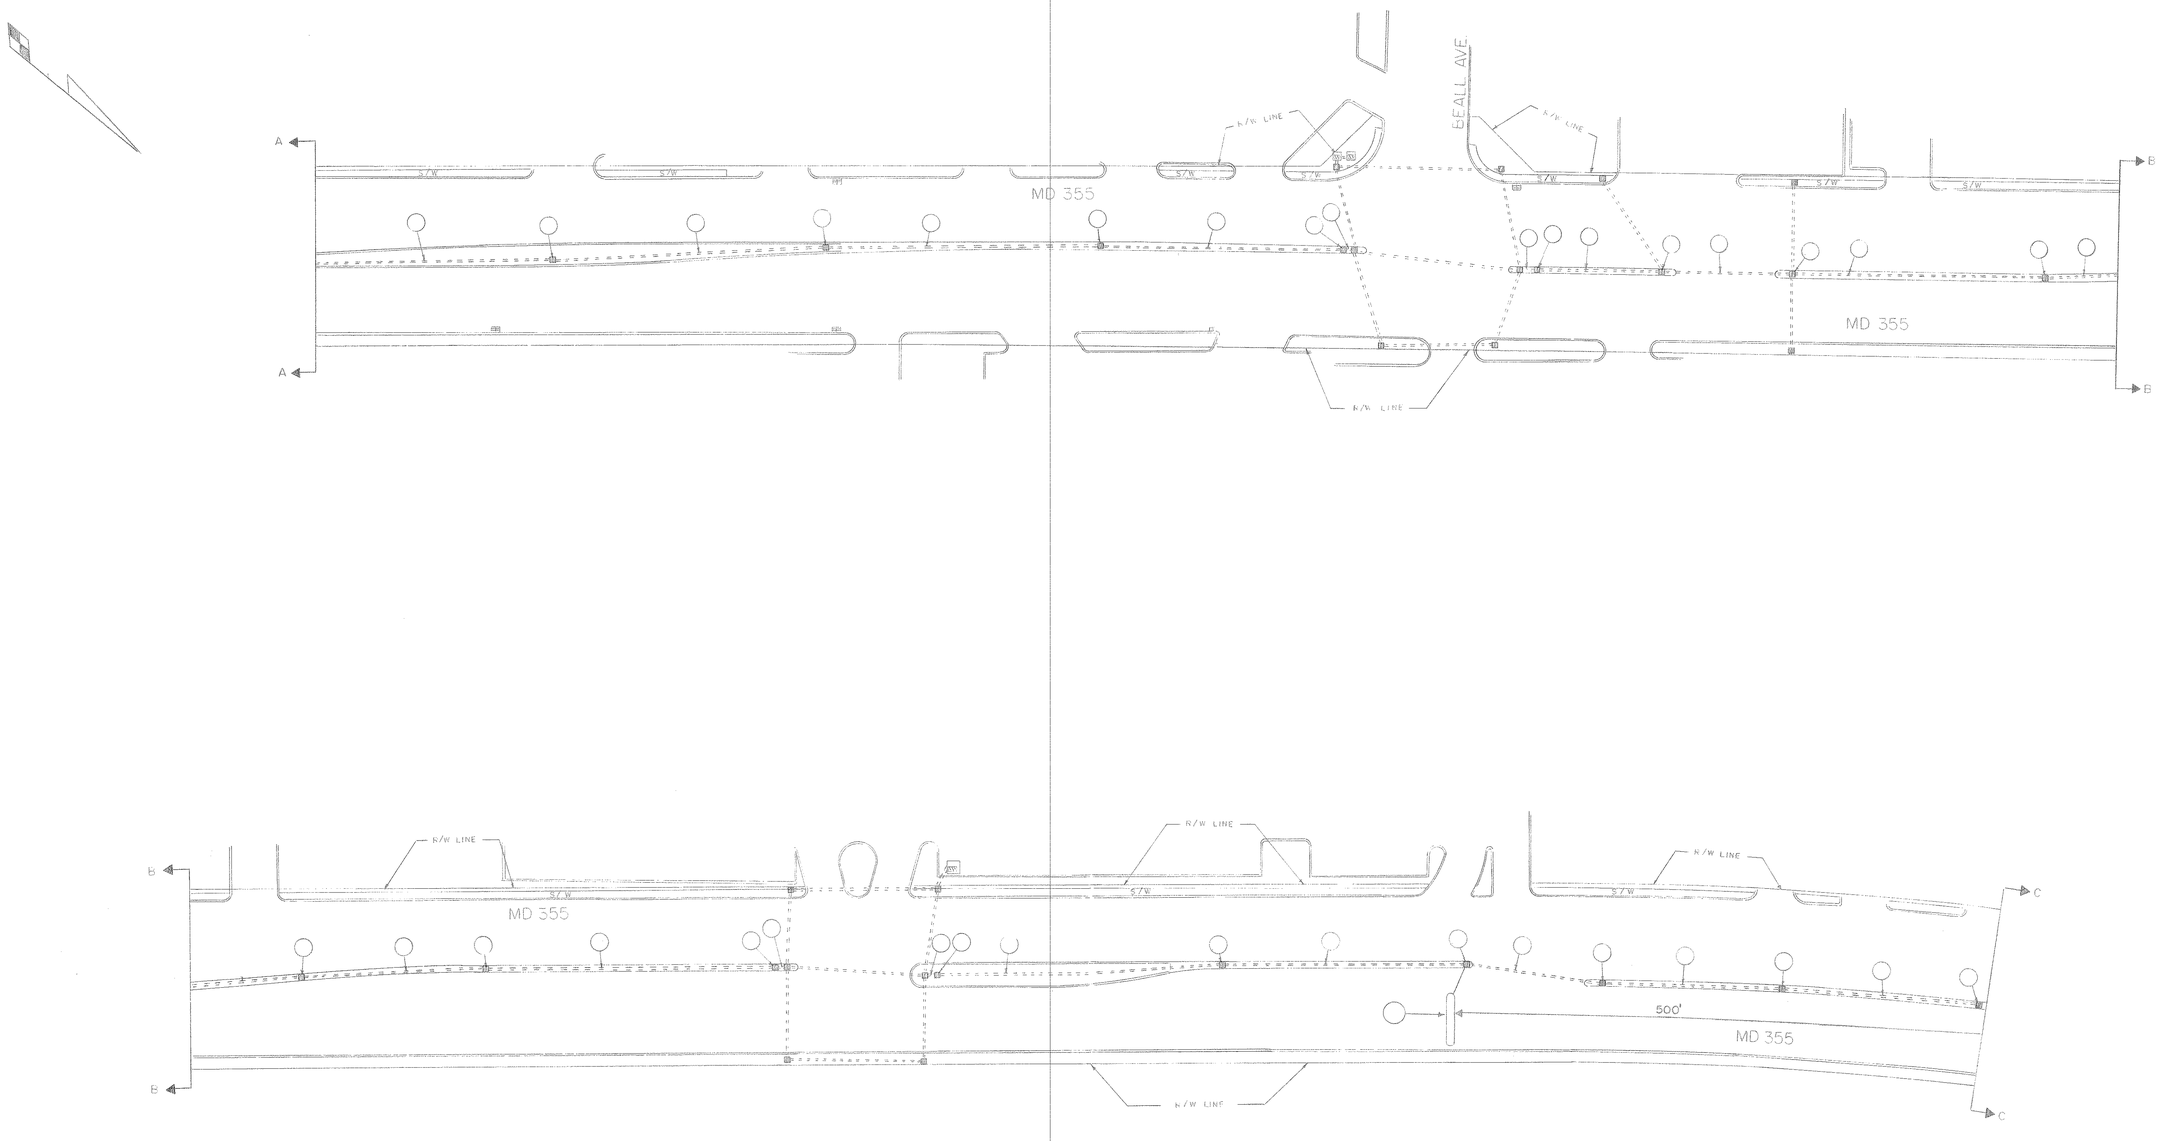

B	9/16/81
	ASBUILT, RELOCATED LOOPS
SR	
A	2-5-74
	REVISION SEE TS-792X.2
GC	

REVISIONS

APPROVAL: CHIEF - BUREAU OF TRAFFIC ENGINEERING

APPROVAL: ASS'T CHIEF ENGINEER TRAFFIC SAFETY

MARYLAND STATE ROADS COMMISSION
DIVISION OF TRAFFIC SAFETY
BUREAU OF TRAFFIC ENGINEERING

INTERCONNECT FOR MD 355

F.A.P. NO. T8004(6)

DATE 11/14/72
SCALE 1" = 40'
DRAWN BY: RICHARDSON
CONTRACT NO M920-376
COUNTY MONTGOMERY
CHECKED BY: William J. Fitch

DRAWING NO. TS 792 X1