F H WA REGION NO	STATE	FED. AID PROJ. NO	SHEET NO.	TOTAL SHEETS
3	MD.			

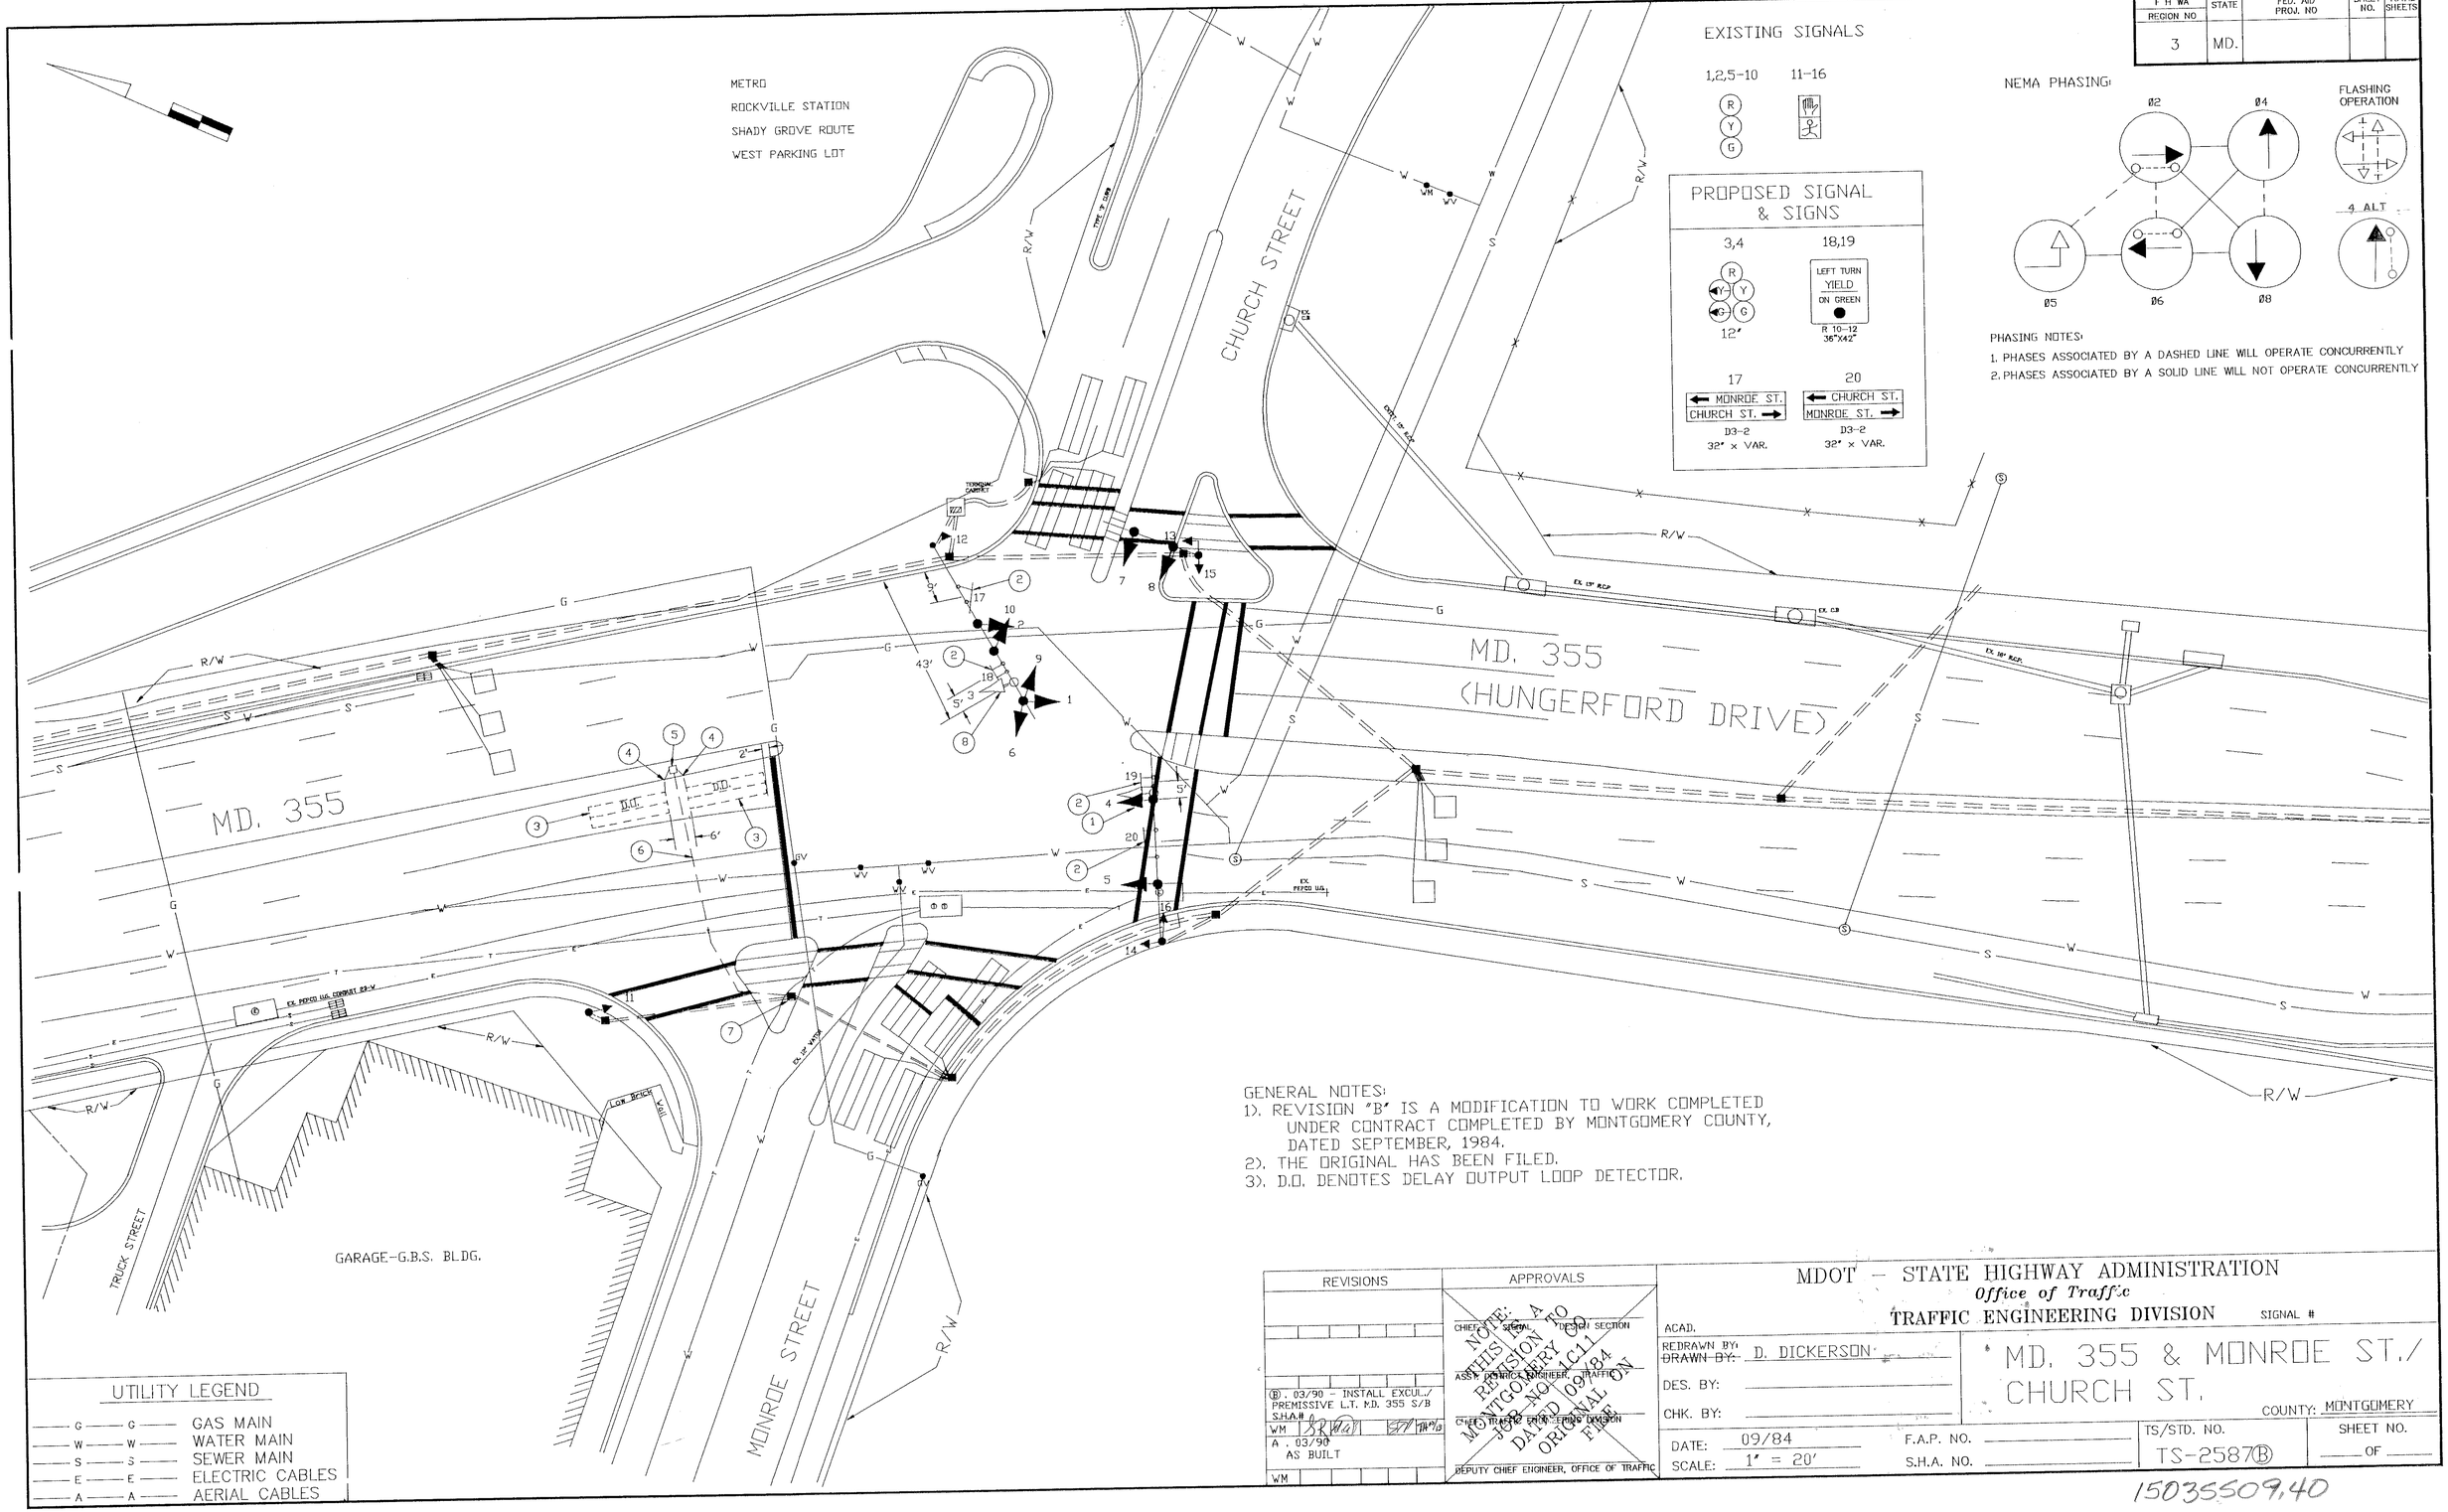

EXISTING SIGNALS

1,2,5-10 11-16

PROPOSED SIGNAL & SIGNS

3,4 18,19

12"

LEFT TURN YIELD ON GREEN

R 10-12 36"X42"

17 20

MONROE ST. CHURCH ST. D3-2 32" x VAR.

CHURCH ST. MONROE ST. D3-2 32" x VAR.

NEMA PHASING:

Ø2 Ø4 Ø5 Ø6 Ø8

FLASHING OPERATION

4 ALT

PHASING NOTES:

1. PHASES ASSOCIATED BY A DASHED LINE WILL OPERATE CONCURRENTLY
2. PHASES ASSOCIATED BY A SOLID LINE WILL NOT OPERATE CONCURRENTLY

GENERAL NOTES:

1). REVISION "B" IS A MODIFICATION TO WORK COMPLETED UNDER CONTRACT COMPLETED BY MONTGOMERY COUNTY, DATED SEPTEMBER, 1984.
2). THE ORIGINAL HAS BEEN FILED.
3). D.O. DENOTES DELAY OUTPUT LOOP DETECTOR.

UTILITY LEGEND

G	GAS MAIN
W	WATER MAIN
S	SEWER MAIN
E	ELECTRIC CABLES
A	AERIAL CABLES

REVISIONS

(B). 03/90 - INSTALL EXCUL./ PREMISSIVE L.T. MD. 355 S/B S.H.A.# WM

A. 03/90 AS BUILT WM

APPROVALS

CHIEF, SIGNAL DESIGN SECTION

ASST. DISTRICT ENGINEER, TRAFFIC

CHIEF, TRAFFIC ENGINEERING DIVISION

DEPUTY CHIEF ENGINEER, OFFICE OF TRAFFIC

NOTE: THIS IS A REVISION TO MONTGOMERY CO. JOB NO. 1C11 DATED 09/84 ORIGINAL ON FILE

MDOT - STATE HIGHWAY ADMINISTRATION
Office of Traffic
TRAFFIC ENGINEERING DIVISION

SIGNAL #

ACAD.

REDRAWN BY: ~~DRAWN BY:~~ D. DICKERSON

DES. BY:

CHK. BY:

MD. 355 & MONROE ST./ CHURCH ST.

COUNTY: MONTGOMERY

DATE: 09/84

SCALE: 1" = 20'

F.A.P. NO.

S.H.A. NO.

TS/STD. NO. TS-2587(B)

SHEET NO. ___ OF ___

15035509.40