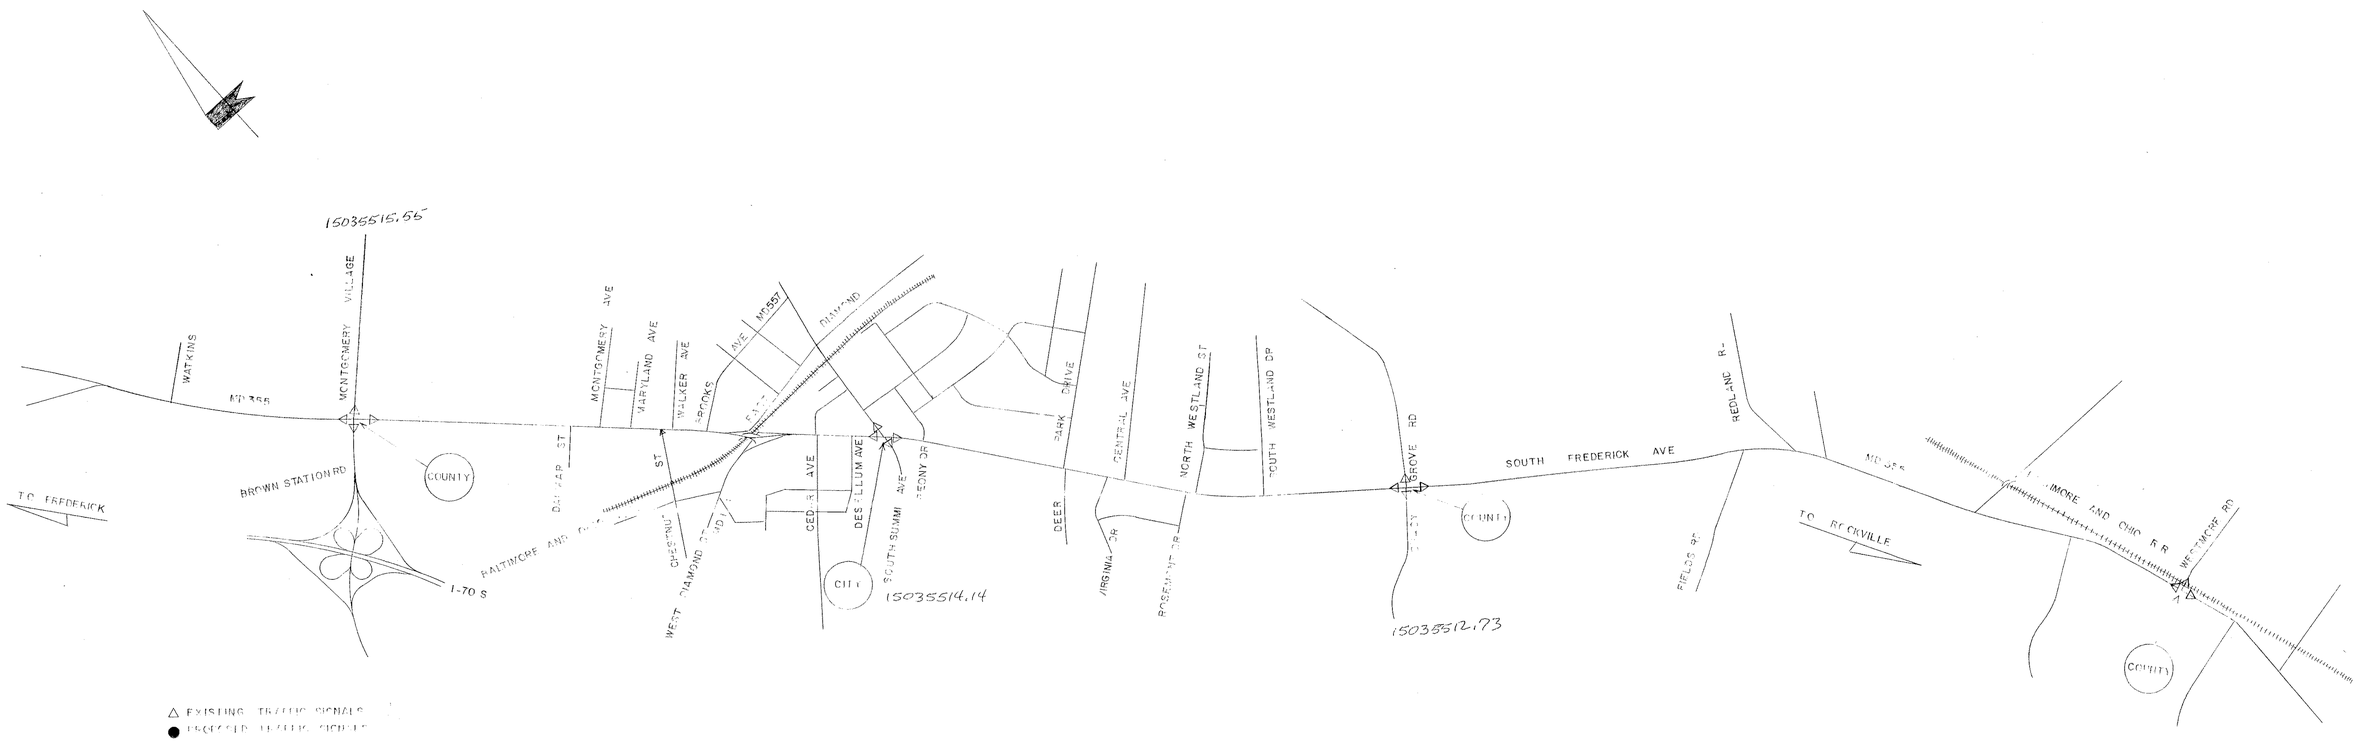

REVISIONS

MARYLAND STATE ROADS COMMISSION
BUREAU OF TRAFFIC ENGINEERING

MD 355 IN GAITHERSBURG

COUNTY MONTGOMERY
DRAWN BY TOWNSEND
SCALE 1" 1000'
DATE 1969

DRAWING NO TS 35

SHADY GROVE RD 1503551 2.73 MONTGOMERY VILLAGE 1503551 5.55
SOUTH SUMMIT AVE 1503551 4.14

MD 355 FROM SHADY GROVE RD
to MONTGOMERY VILLAGE RD

1503551 2.73