F H WA REGION NO	STATE	FED. AID PROJ. NO	SHEET NO.	TOTAL SHEETS
3	MD.			

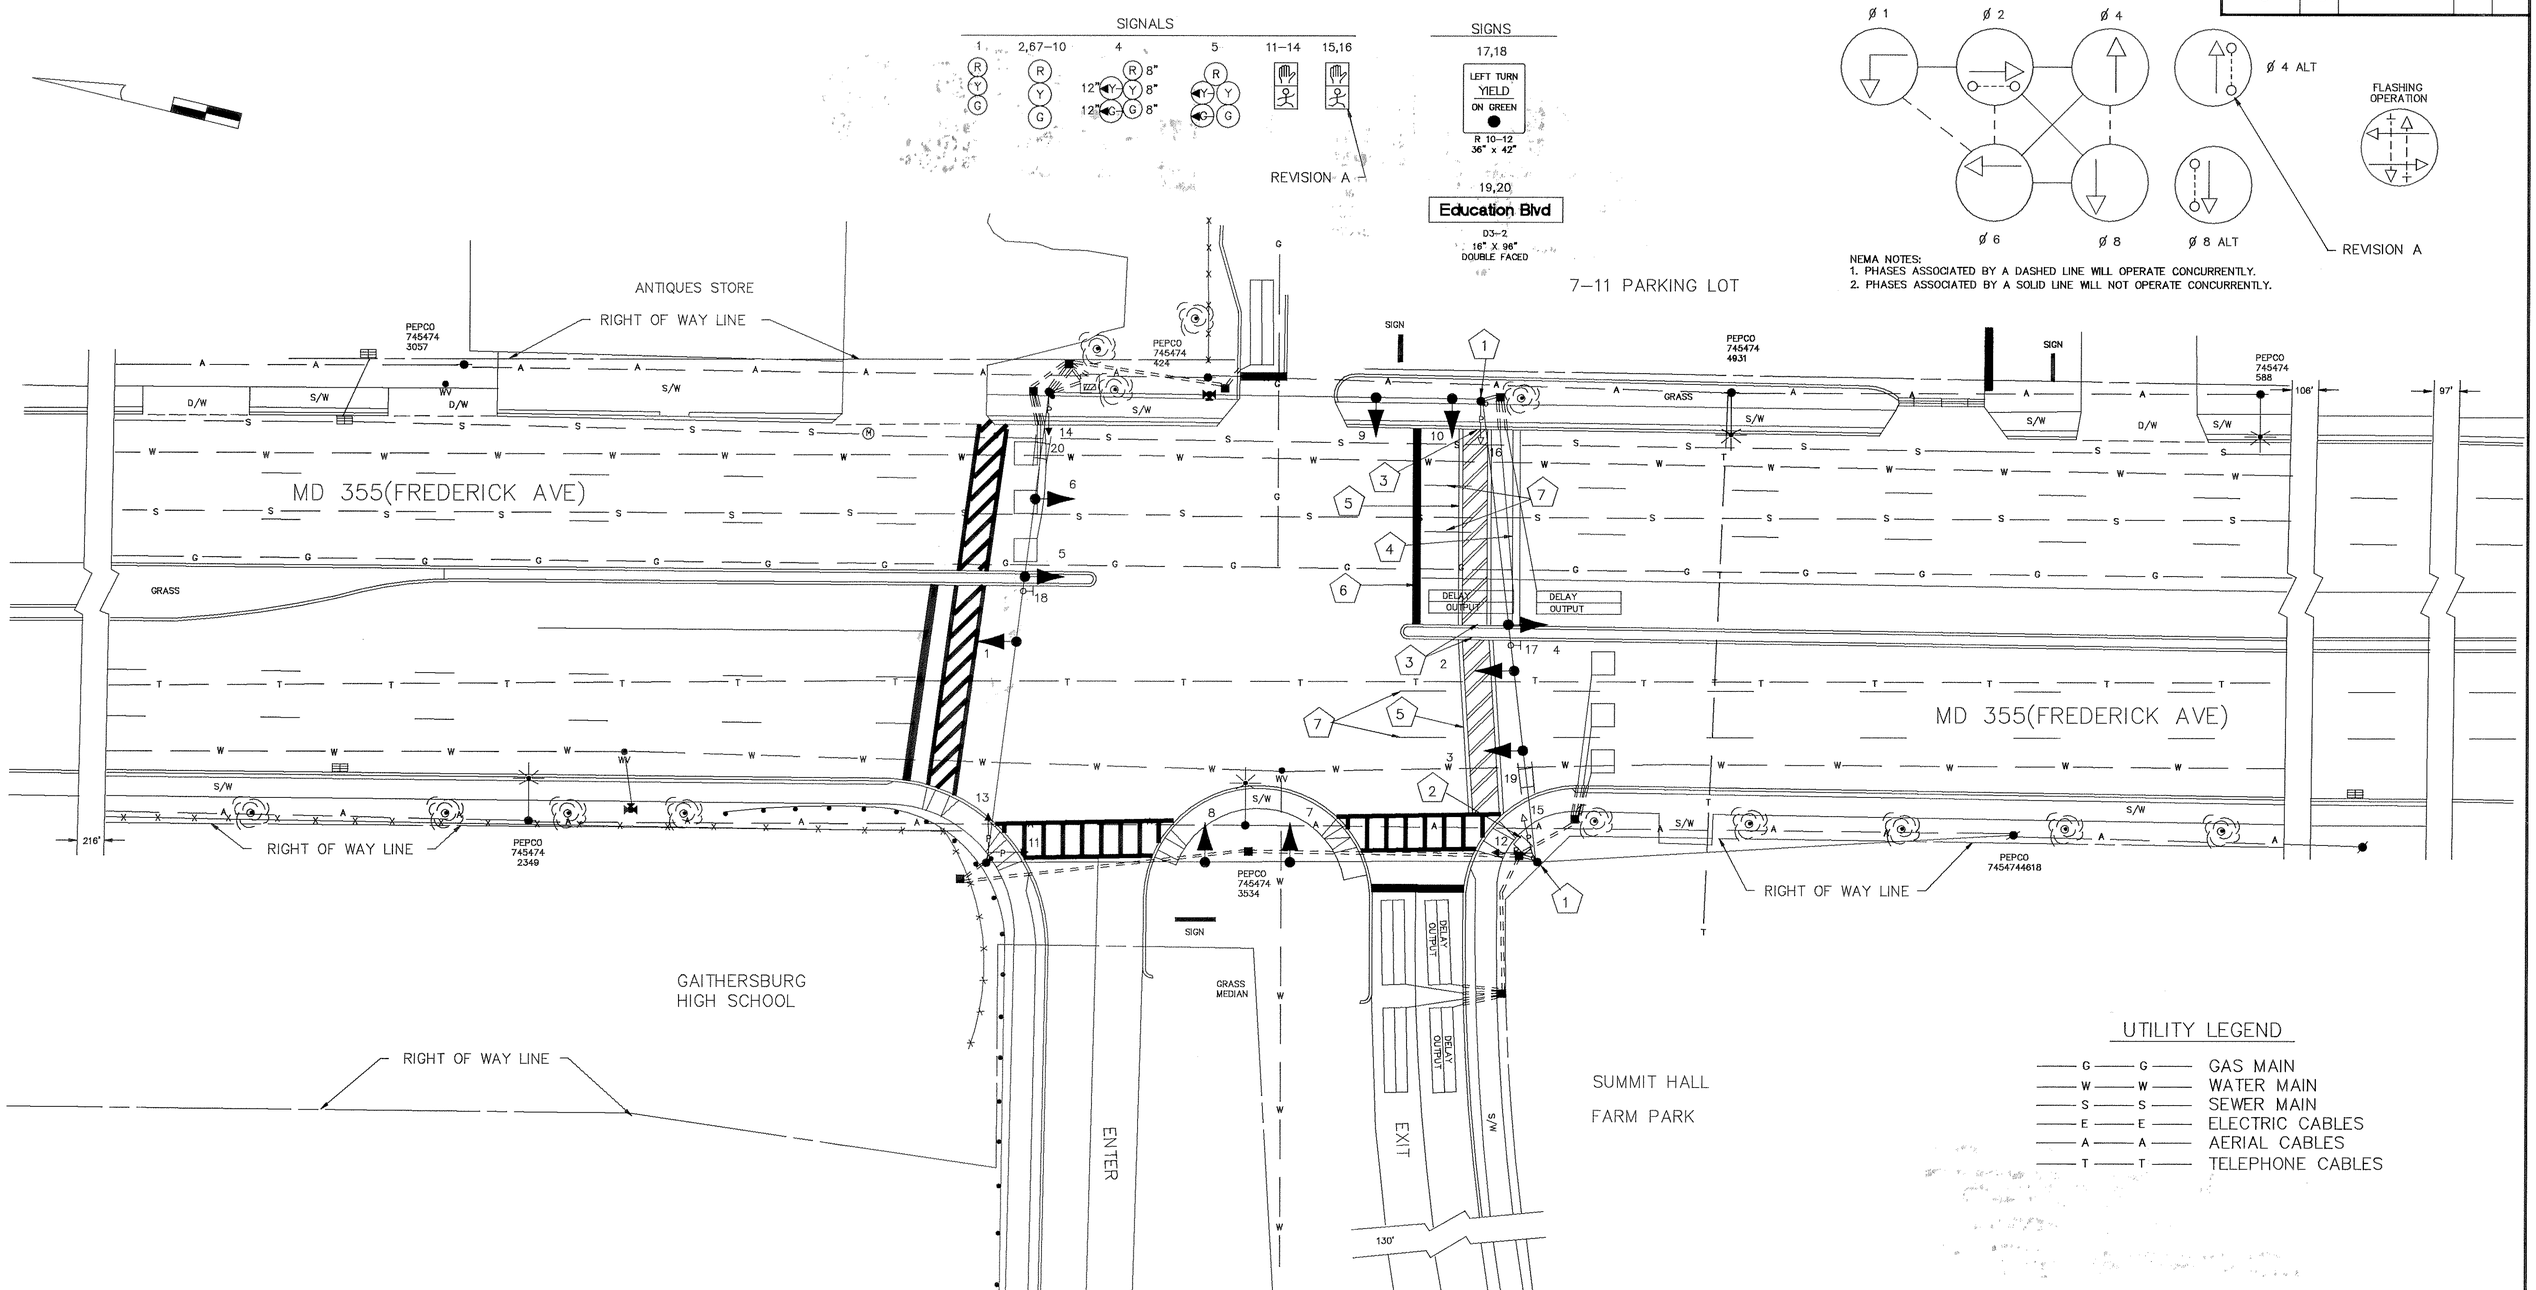

REVISIONS	APPROVALS
(A) ASBUILT 4/94 ADD PEDESTRIAN MOVEMENT TO PHASE 4, QT-5+3-92	DIMITRIOS A. ZAFIRIS 2-7-89 CHIEF, SIGNAL DESIGN SECTION
	BARRY R. KINCAID 2-7-89 ASST. DISTRICT ENGINEER, TRAFFIC
	DIMITRIOS A. ZAFIRIS 2-7-89 CHIEF, TRAFFIC ENGINEERING DESIGN DIVISION FOR:
	THOMAS HICKS 2-7-89 DIRECTOR, OFFICE OF TRAFFIC & SAFETY

THE ORIGINAL IS ON FILE

MDOT – STATE HIGHWAY ADMINISTRATION

Office of Traffic & Safety

TRAFFIC ENGINEERING DESIGN DIVISION

DRAWN BY: BRUCE THOMPSON WJN(STS)
DES. BY: R R ZACHERL(FOR STS)
CHK. BY: DLA D. DODA 2-7-89

MD 355 and EDUCATION BLVD

15035514.04

COUNTY: MONTGOMERY

DATE: REDRAWN 4-1-94
SCALE: 1"=20'

F.A.P. NO.
S.H.A. NO.

TS/STD. NO. 2542 A

SHEET NO. ___ OF ___

F#

15035514.04