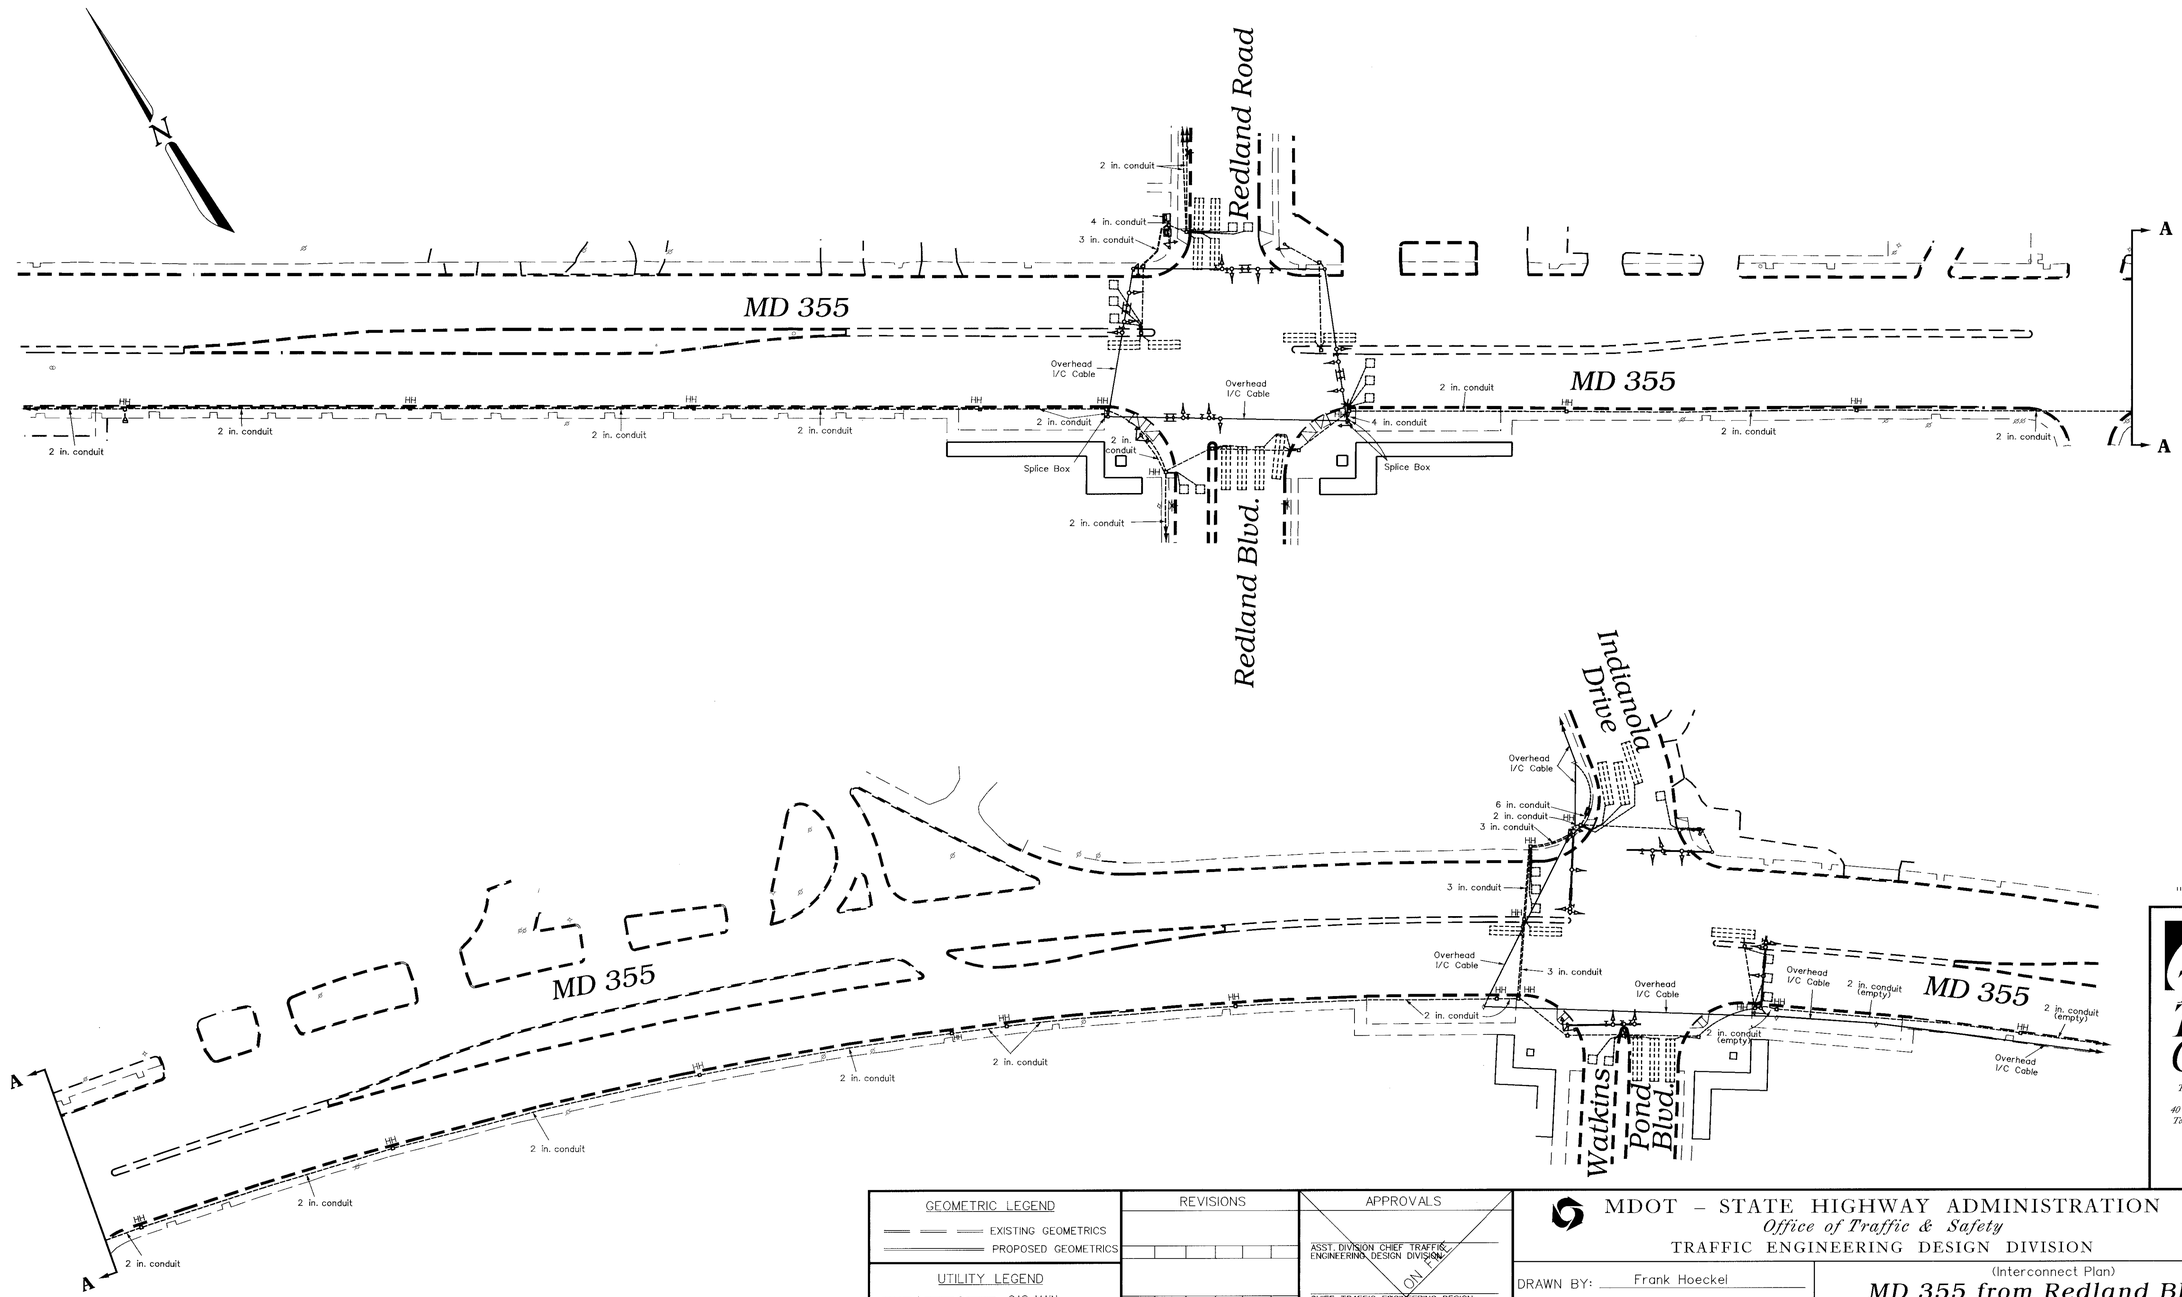

"ASBUILT"

The Traffic Group
The Traffic Group, Inc.
Suite 600
40 W. Chesapeake Avenue
Towson, Maryland 21204
410-583-8405
1-800-583-8411
Fax 410-321-8458
Job No. 960613
AB-IC_1A.DGN

GEOMETRIC LEGEND

EXISTING GEOMETRICS
PROPOSED GEOMETRICS

UTILITY LEGEND

G	GAS MAIN
W	WATER MAIN
S	SEWER MAIN
E	ELECTRIC CABLES
D	STORM DRAIN
A	AERIAL CABLES
T	TELEPHONE CABLES

REVISIONS

(B) AS-BUILT December 22, 1998
S.H.A. No.:BW979M82
FJH

APPROVALS

ASST. DIVISION CHIEF TRAFFIC ENGINEERING DESIGN DIVISION
CHIEF, TRAFFIC ENGINEERING DESIGN DIVISION
ASST. DISTRICT ENGINEER - TRAFFIC
DIRECTOR, OFFICE OF TRAFFIC & SAFETY
ORIGINAL ON FILE

MDOT – STATE HIGHWAY ADMINISTRATION
Office of Traffic & Safety
TRAFFIC ENGINEERING DESIGN DIVISION

DRAWN BY: Frank Hoeckel
DES. BY: John Dirndorfer
CHK. BY:

(Interconnect Plan)
MD 355 from Redland Blvd. to Watkins Pond Blvd.

COUNTY: MONTGOMERY

DATE: May 29, 1997
SCALE: 1" = 50'
F.A.P. NO. N/A
S.H.A. NO. BW979M82
TS/STD. NO. 3665-X1 B
SHEET NO. 1 of 1