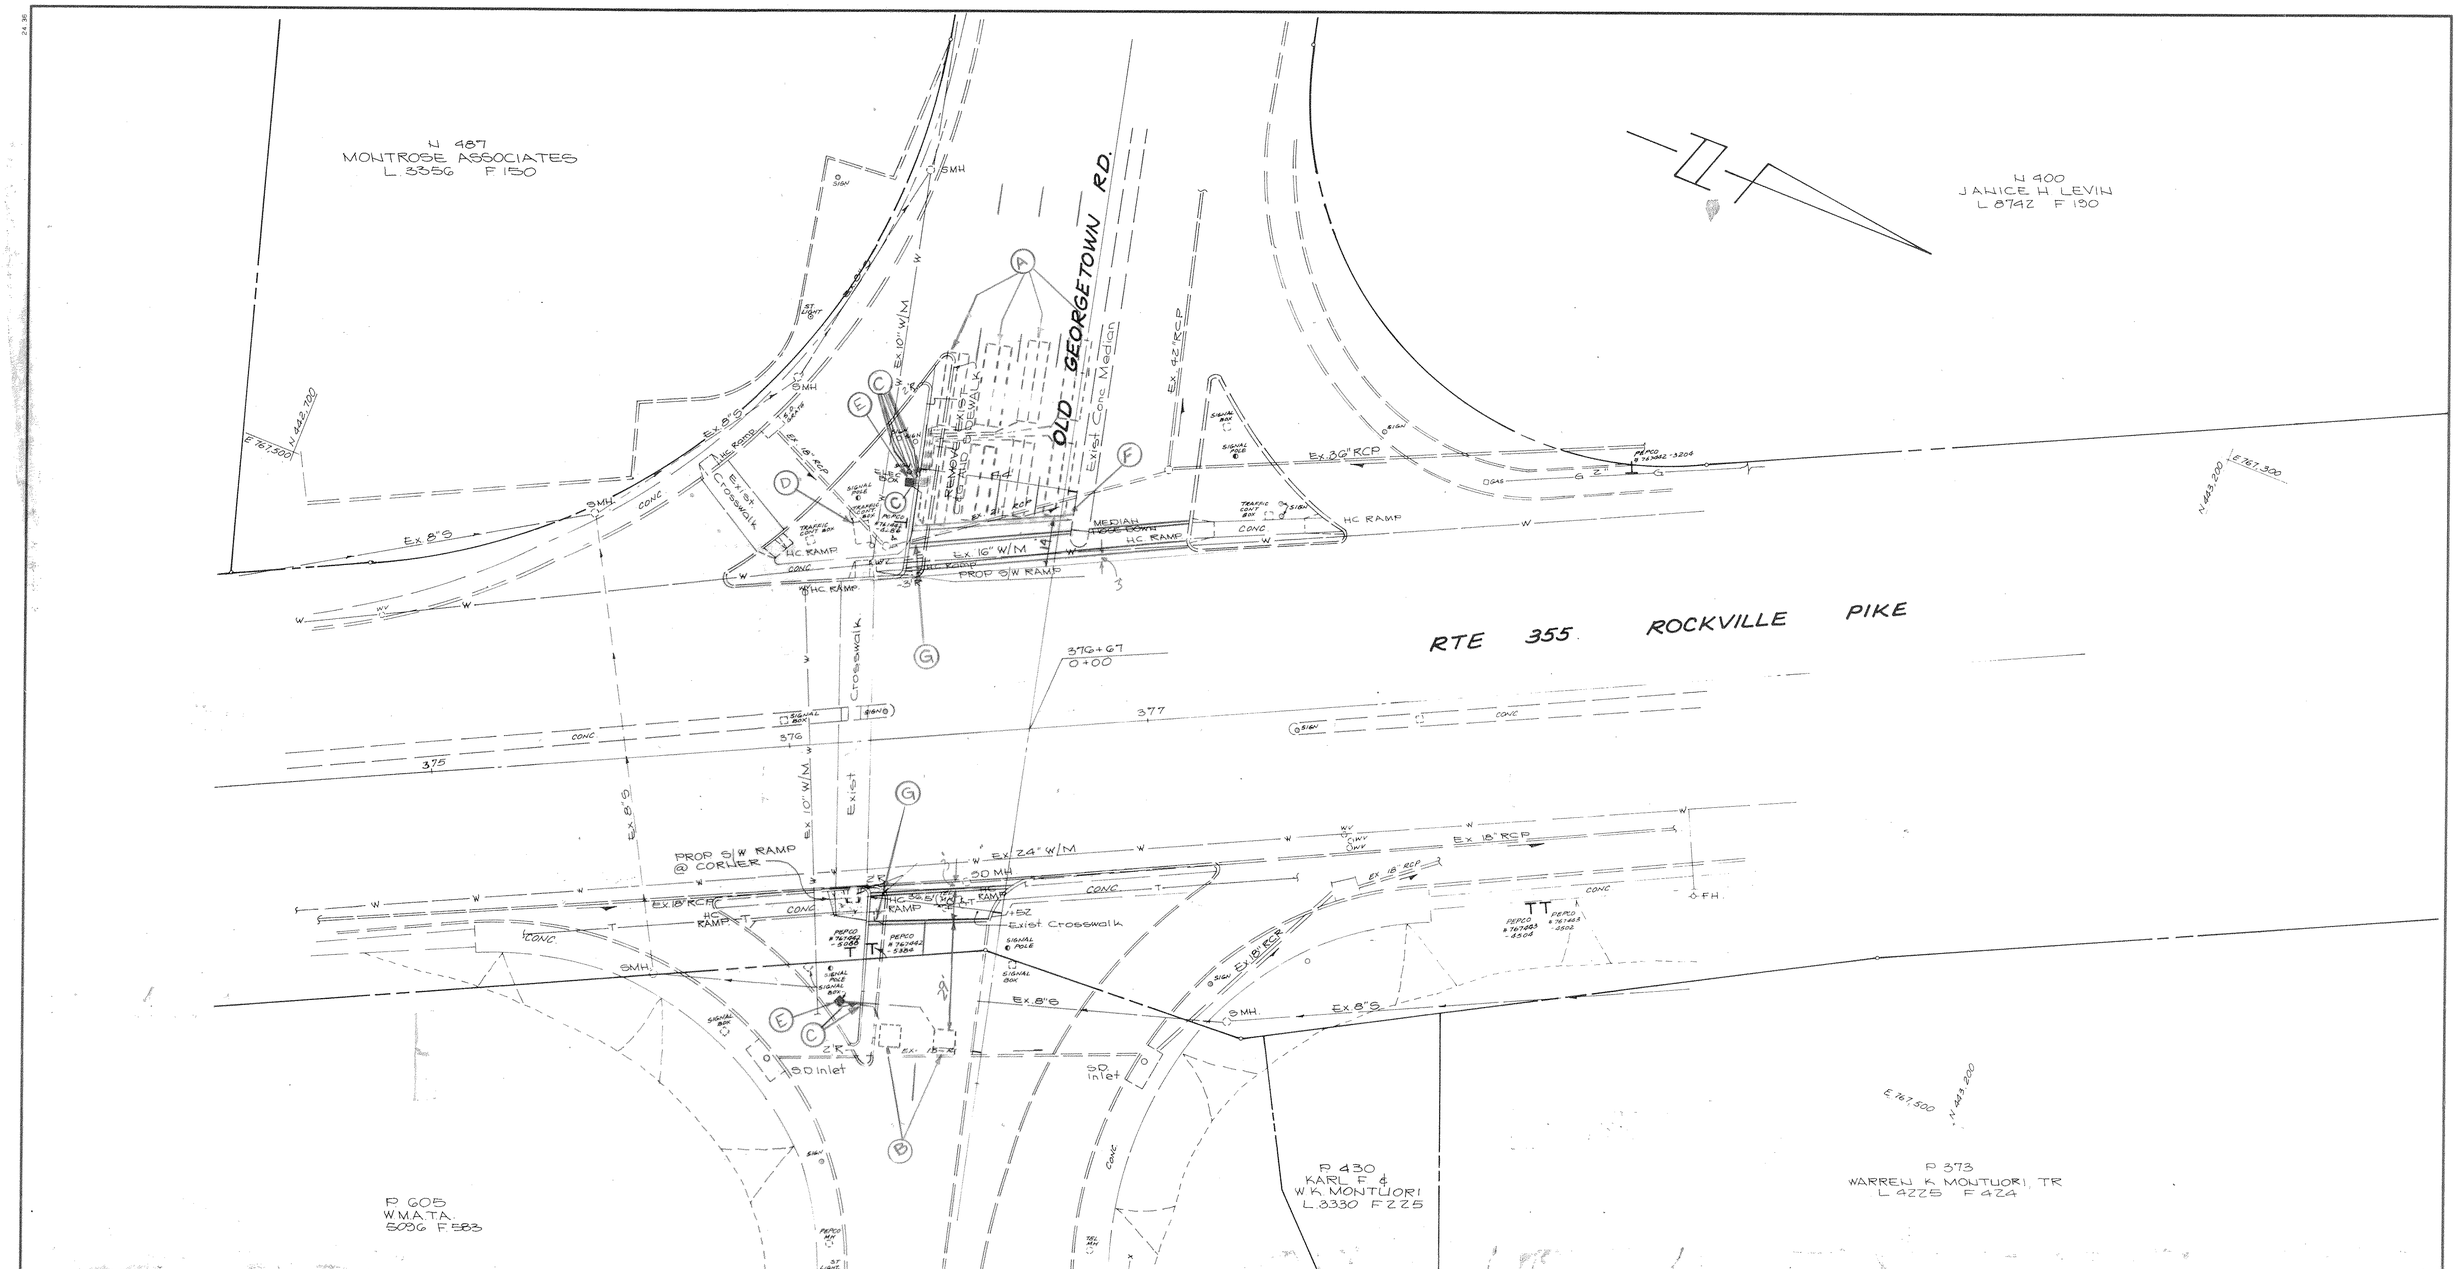

LEE CUNNINGHAM & ASSOCIATES, INC.

10015 OLD COLUMBIA ROAD, SUITE B-215, COLUMBIA, MD 21046
WASHINGTON (301) 596-7900 BALTIMORE (410) 290-5920
1-800-673-9096

REVISIONS
ADDITION OF EB LANE NEW DETECTORS JAN. 1992
W.J.C.

APPROVALS
CHIEF, DESIGN SECTION
ASST. DISTRICT ENGINEER, TRAFFIC
CHIEF, TRAFFIC ENGINEERING DIVISION
DEPUTY CHIEF ENGINEER, TRAFFIC

ORIGINAL ON FILE

MDOT – STATE HIGHWAY ADMINISTRATION

Office of Traffic & Safety

TRAFFIC ENGINEERING DESIGN DIVISION

DRAWN BY: MCDOT
DES. BY:
CHK. BY:

MD 355 (ROCKVILLE PIKE) AT OLD GEORGETOWN RD Md 187
COUNTY MONTGOMERY

DATE:
SCALE: 1" = 20'
F.A.P. NO.
S.H.A. NO. BW-480-802-312
TS/STD. NO. 32162
SHEET NO. 1 OF 1

LOIEDERMAN ASSOCIATES, INC.
CIVIL ENGINEERS LAND PLANNERS LAND SURVEYORS
15200 Shady Grove Road, Rockville, Maryland 20850, (301) 948-2750
4407 Forbes Boulevard, Lanham, Maryland 20706, (301) 794-7555

Designed	T.C.A.
Drafted	N.C.
Checked	J.W.D.
Proj. Eng.	J.W.D.
OFFICE	ROCKVILLE
DATE	

NO.	REVISIONS	BY	DATE
	NEW EB RAMP THROUGH ... NEW DETECTORS	W.J.C.	1/92

OFF SITE ROADWAY IMPROVEMENT PLAN
ROCKVILLE PIKE (RTE. 355)

WHITE FLINT NORTH II
ROCKVILLE 4th ELECTION DISTRICT
MONTGOMERY COUNTY, MARYLAND

SCALE 1" = 20'
SHEET 6 OF 20 SHEETS
JOB NO. 053-04