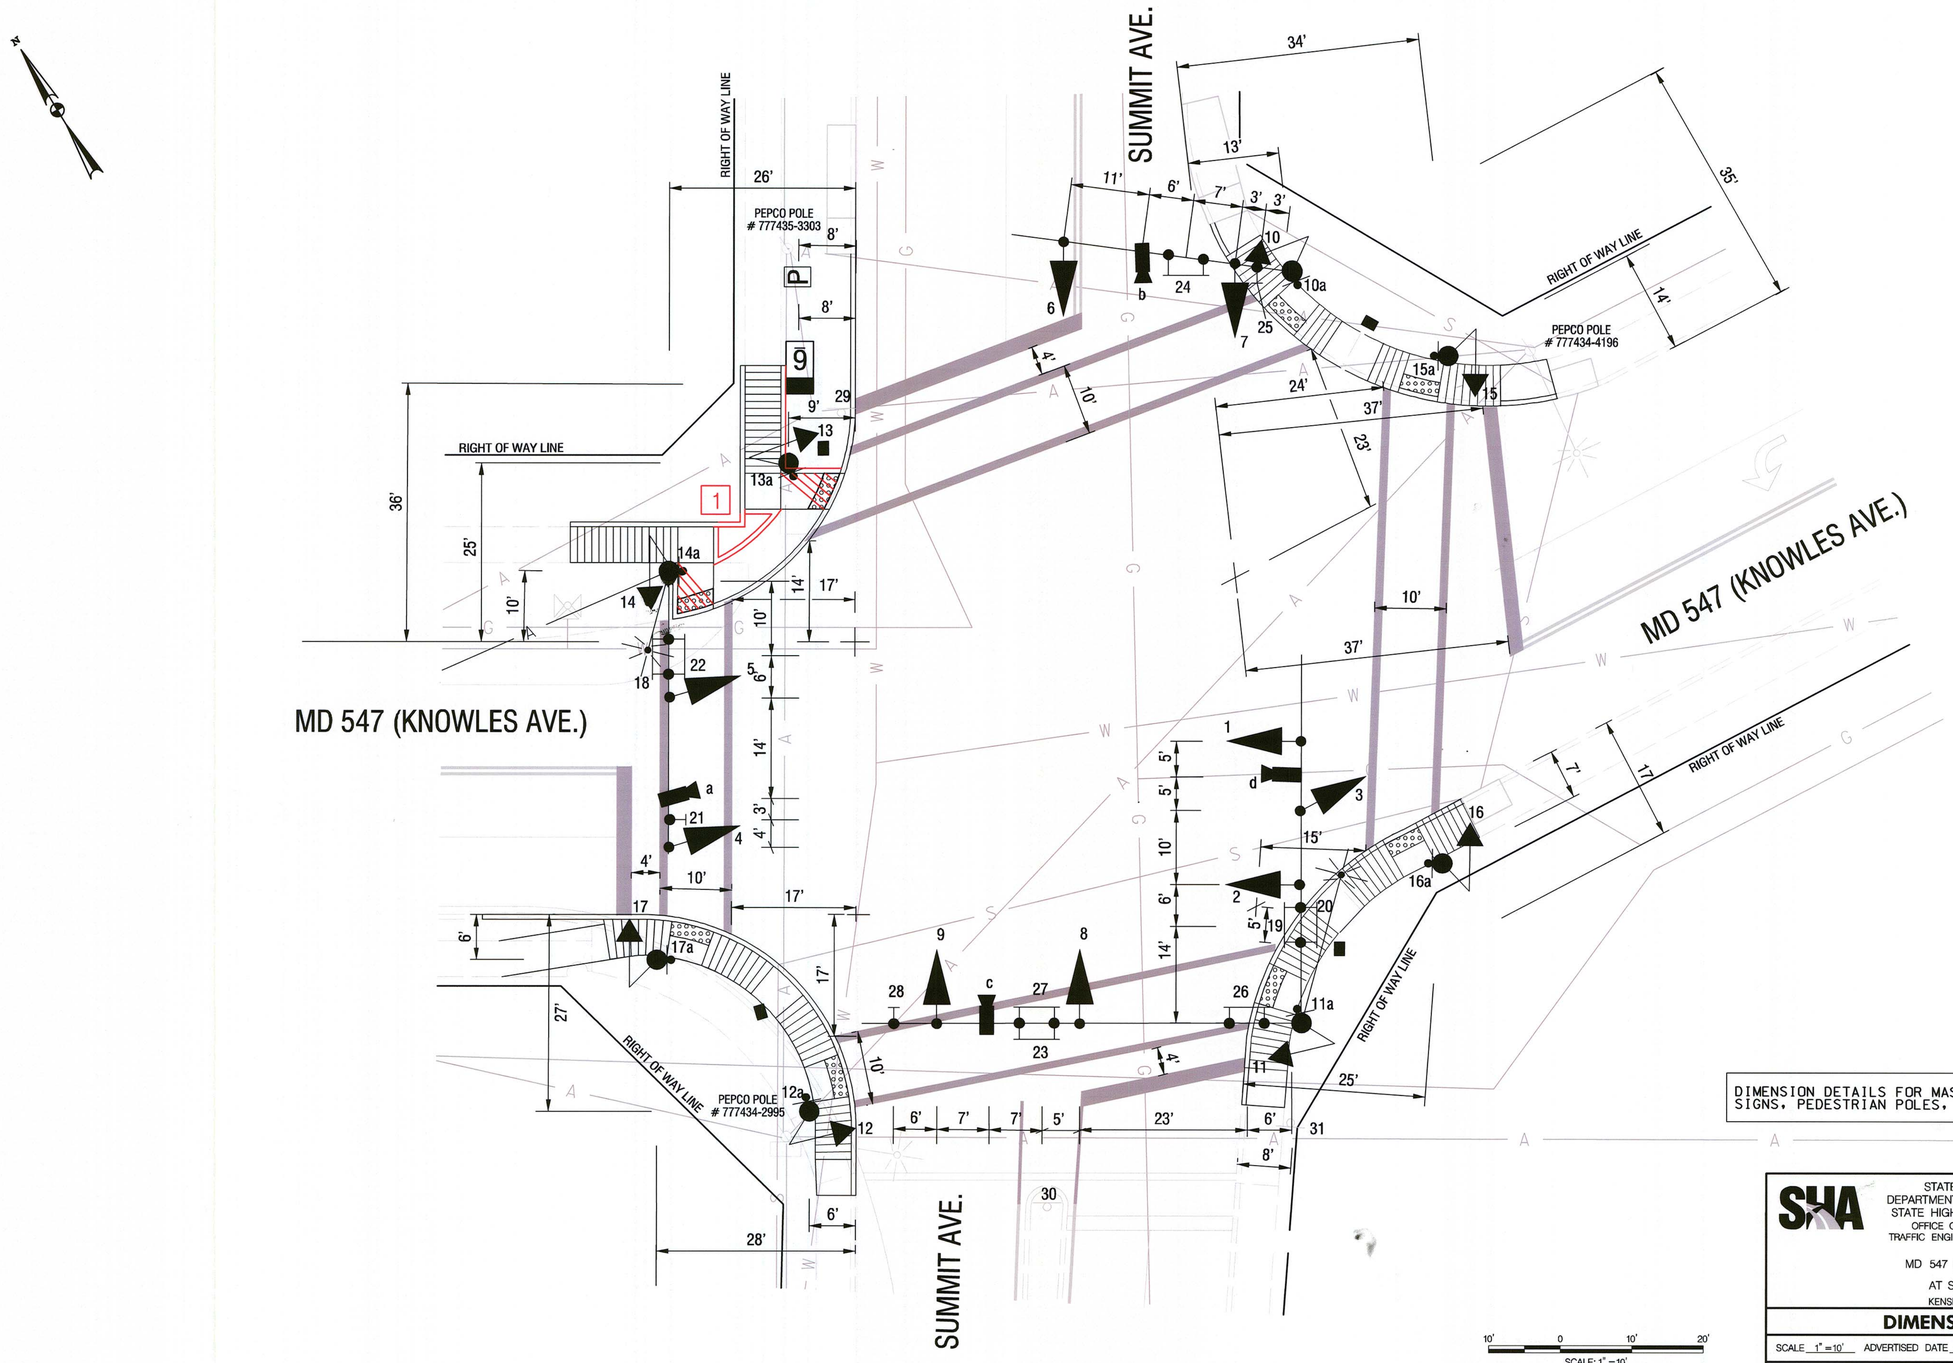

DIMENSION DETAILS FOR MAST ARMS, SIGNAL HEADS, SIGNS, PEDESTRIAN POLES, CROSSWALKS AND STOPLINES.

1 REDLINE NO. 1, AUGUST 2011

10' 0 10' 20'
SCALE: 1" = 10'

SABRA, WANG & ASSOCIATES, INC.
1504 JOH AVENUE
SUITE 160
BALTIMORE MD. 21227
(410) 737-6564
WWW.SABRA-WANG.COM

STATE OF MARYLAND
DEPARTMENT OF TRANSPORTATION
STATE HIGHWAY ADMINISTRATION
OFFICE OF TRAFFIC & SAFETY
TRAFFIC ENGINEERING DESIGN DIVISION

MD 547 (KNOWLES AVENUE)
AT SUMMIT AVENUE
KENSINGTON, MARYLAND

DIMENSION DETAILS

SCALE 1" = 10' ADVERTISED DATE JANUARY 2011 CONTRACT NO. XX4455185

DESIGNED BY S. SMITH
DRAWN BY J. WOOD
CHECKED BY S.DU
F.A.P. NO. SEE TITLE SHEET
COUNTY MONTGOMERY
LOGMILE 15054701.63
TIMS NO. 1907
TOD NO.

TS NO. 471A | DRAWING 3 OF 4 | SHEET NO. OF

PLOTTED: Tuesday, August 16, 2011 AT 05:33 PM
FILE: R:\2004\46 SHA BCS 2004-025 TEDD Traffic\Task 67 MD 547 at Summit Ave APS CPS\dwg\pSG-P001B_MD547SA.dgn

BY: Sdu