F.H.WA. REGION NO.	STATE	FED. AID PROJ. NO.	SHEET NO.	TOTAL SHEETS
3	MD.			

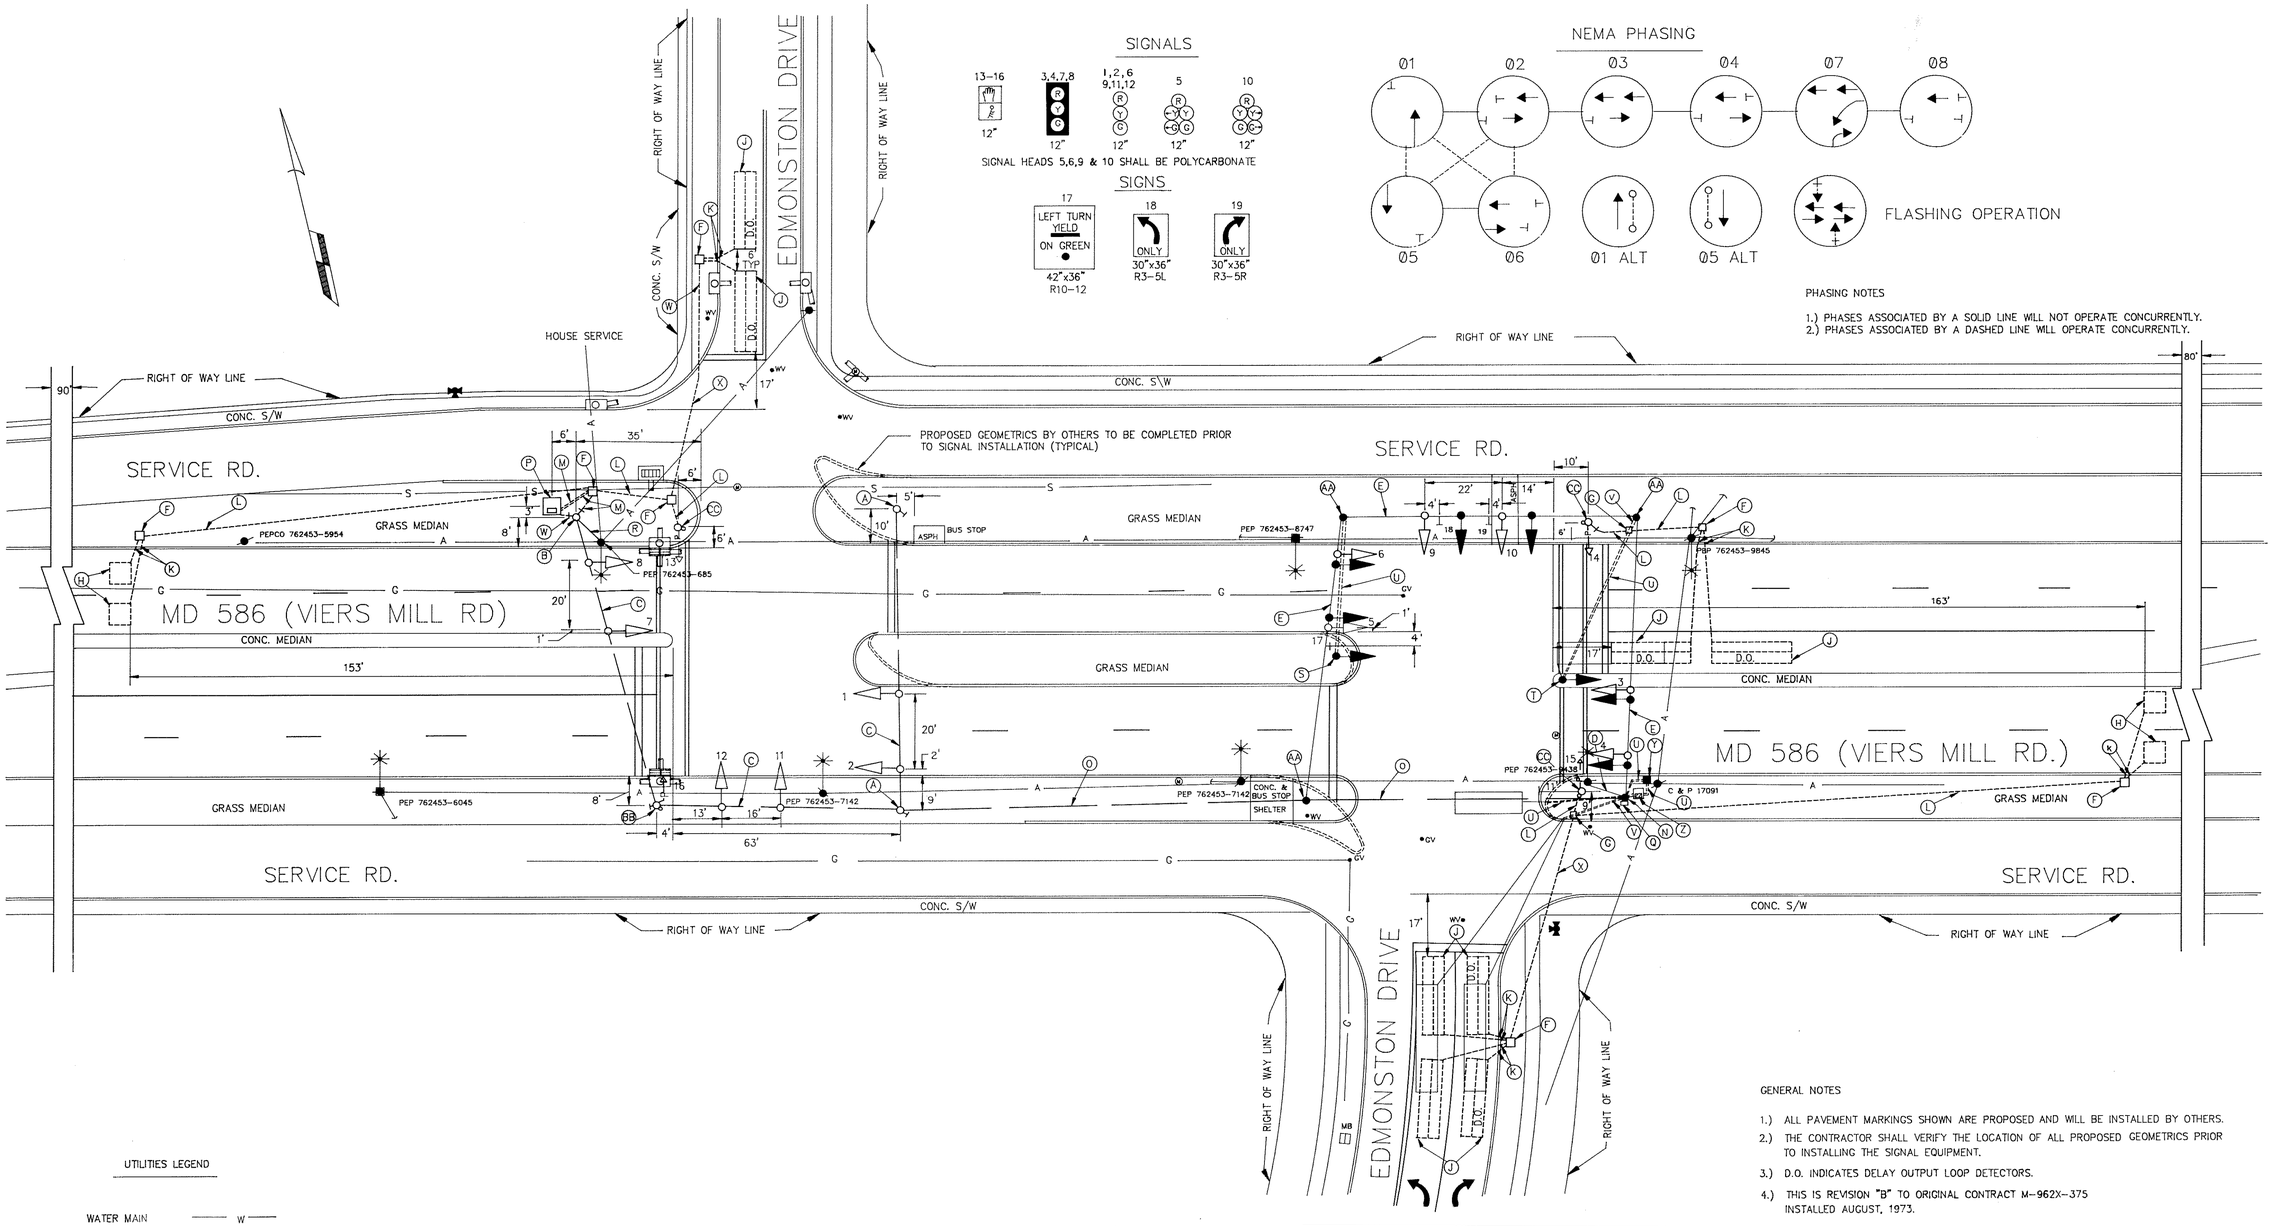

REVISIONS	APPROVALS
B. 2-17-87 REBUILD EXIST. SIGNAL ADD NEW SIGNAL TO S.B. EDMONSTON. SHA NO M-582-451-385	ORIGINAL ON FILE
P.A.H.	CHIEF, SIGNAL DESIGN SECTION
A. 12-13-73 AS-BUILT	ASST. DISTRICT ENGINEER, TRAFFIC
F.D. C.F.B. A.B.	CHIEF, BUREAU OF TRAFFIC ENGINEERING
	DEPUTY CHIEF ENGINEER, OFFICE OF TRAFFIC

MARYLAND DEPARTMENT OF TRANSPORTATION
STATE HIGHWAY ADMINISTRATION - OFFICE OF TRAFFIC
BUREAU OF TRAFFIC ENGINEERING

MD 586
&
EDMONSTON DRIVE, N.B. & S.B.
COUNTY : MONTGOMERY

SCALE: 1" = 20' DATE: 11-20-72

DRAWN BY J. GORDON DES. BY: J. GORDON
REDRAWN BY C.L.D. OF G.P.I. CHK. BY: W.F. FITCH, 6-15-73

F.A.P. NO. N/A
S.H.A. NO. M-962X-375
TS/FILE NO. TS-801B

SHEET NO. 1 OF 1