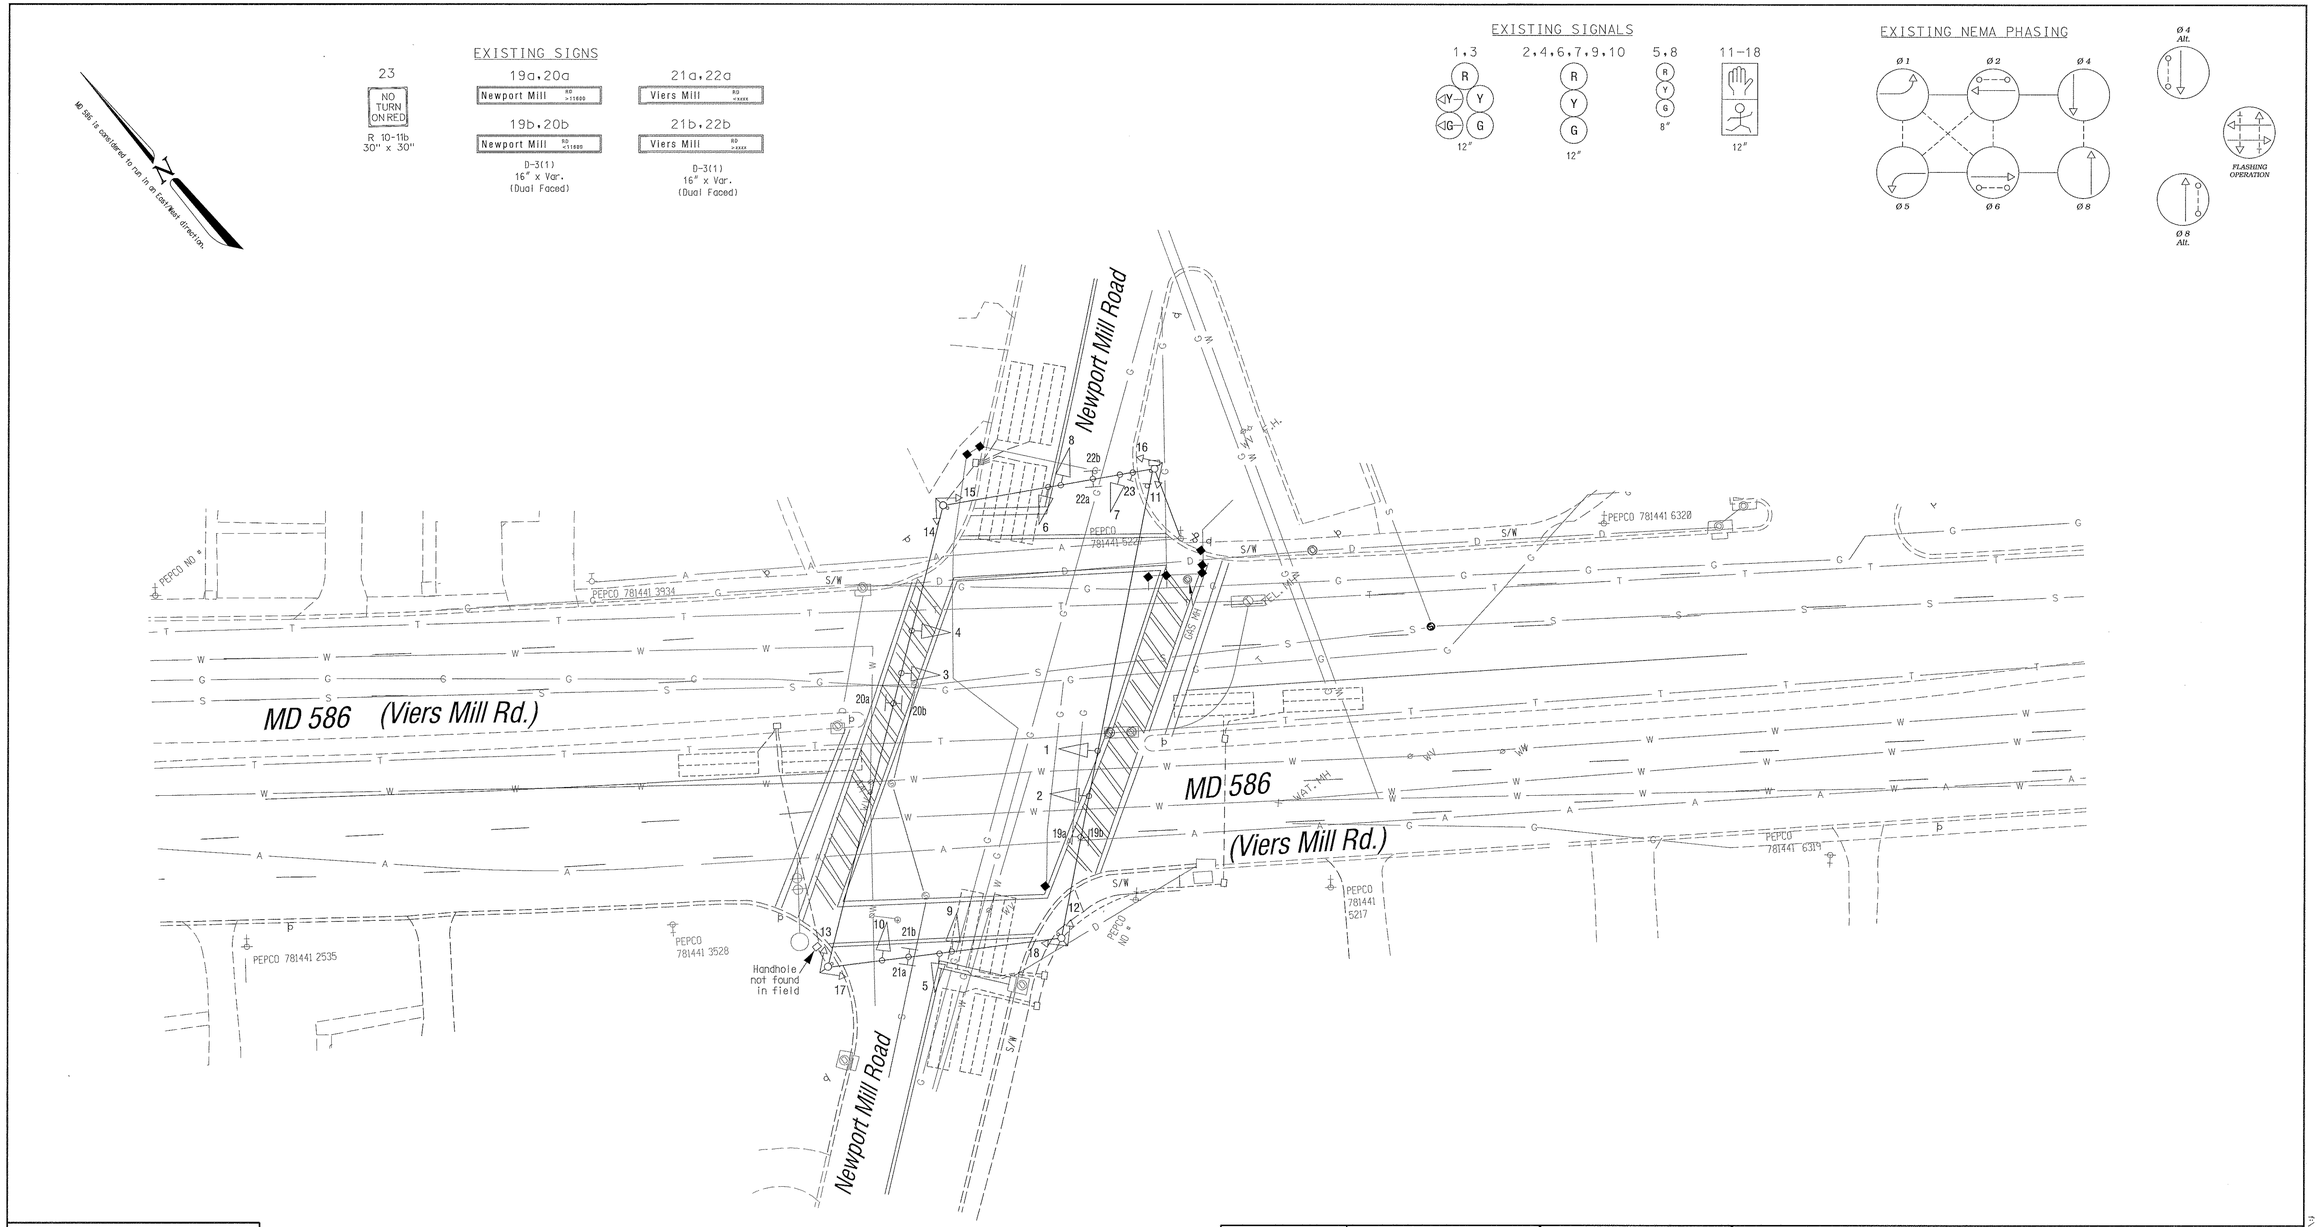

GEOMETRIC LEGEND

EXISTING GEOMETRICS

PROPOSED GEOMETRICS

UTILITY LEGEND

G	GAS MAIN
W	WATER MAIN
S	SEWER MAIN
E	ELECTRIC CABLES
D	STORM DRAIN
A	AERIAL CABLES
T	TELEPHONE CABLES

"AS_BUILT"

The Traffic Group

The Traffic Group, Inc.
410-931-6600
Fax 410-931-6601

REVISIONS

April 27, 2001

As-built
S.H.A. No.:BW109M83

FJH

APPROVALS

TEAM LEADER, TRAFFIC ENGINEERING DESIGN DIVISION

ASST. CHIEF TRAFFIC ENGINEERING DESIGN DIVISION

CHIEF, TRAFFIC ENGINEERING DESIGN DIVISION

DIRECTOR, TRAFFIC & SAFETY

ORIGINAL ON FILE

MARYLAND DOT - STATE HIGHWAY ADMINISTRATION

Office of Traffic & Safety

TRAFFIC ENGINEERING DESIGN DIVISION

(Traffic Signal Plan)

MD 586 (Viers Mill Road) at Newport Mill Road

DRAWN BY:	Name	F.A.P. NO.	N/A	XXX	
CHECKED BY:		S.H.A. NO.	XXX		
SCALE:	1" = 20'	COUNTY:	Montgomery		
DATE:	Month Day Year	LOG MILE:	XXX	XXX	1 OF 1

f:\1995\951020-c\des\asbuilt-d1.dgn 24 APR 2001

TS# 2024 15058604.72