F. H. W. A. REGION NO.	STATE	FED. AID PROJ. NO.	SHEET NO.	TOTAL SHEETS
3	MD			

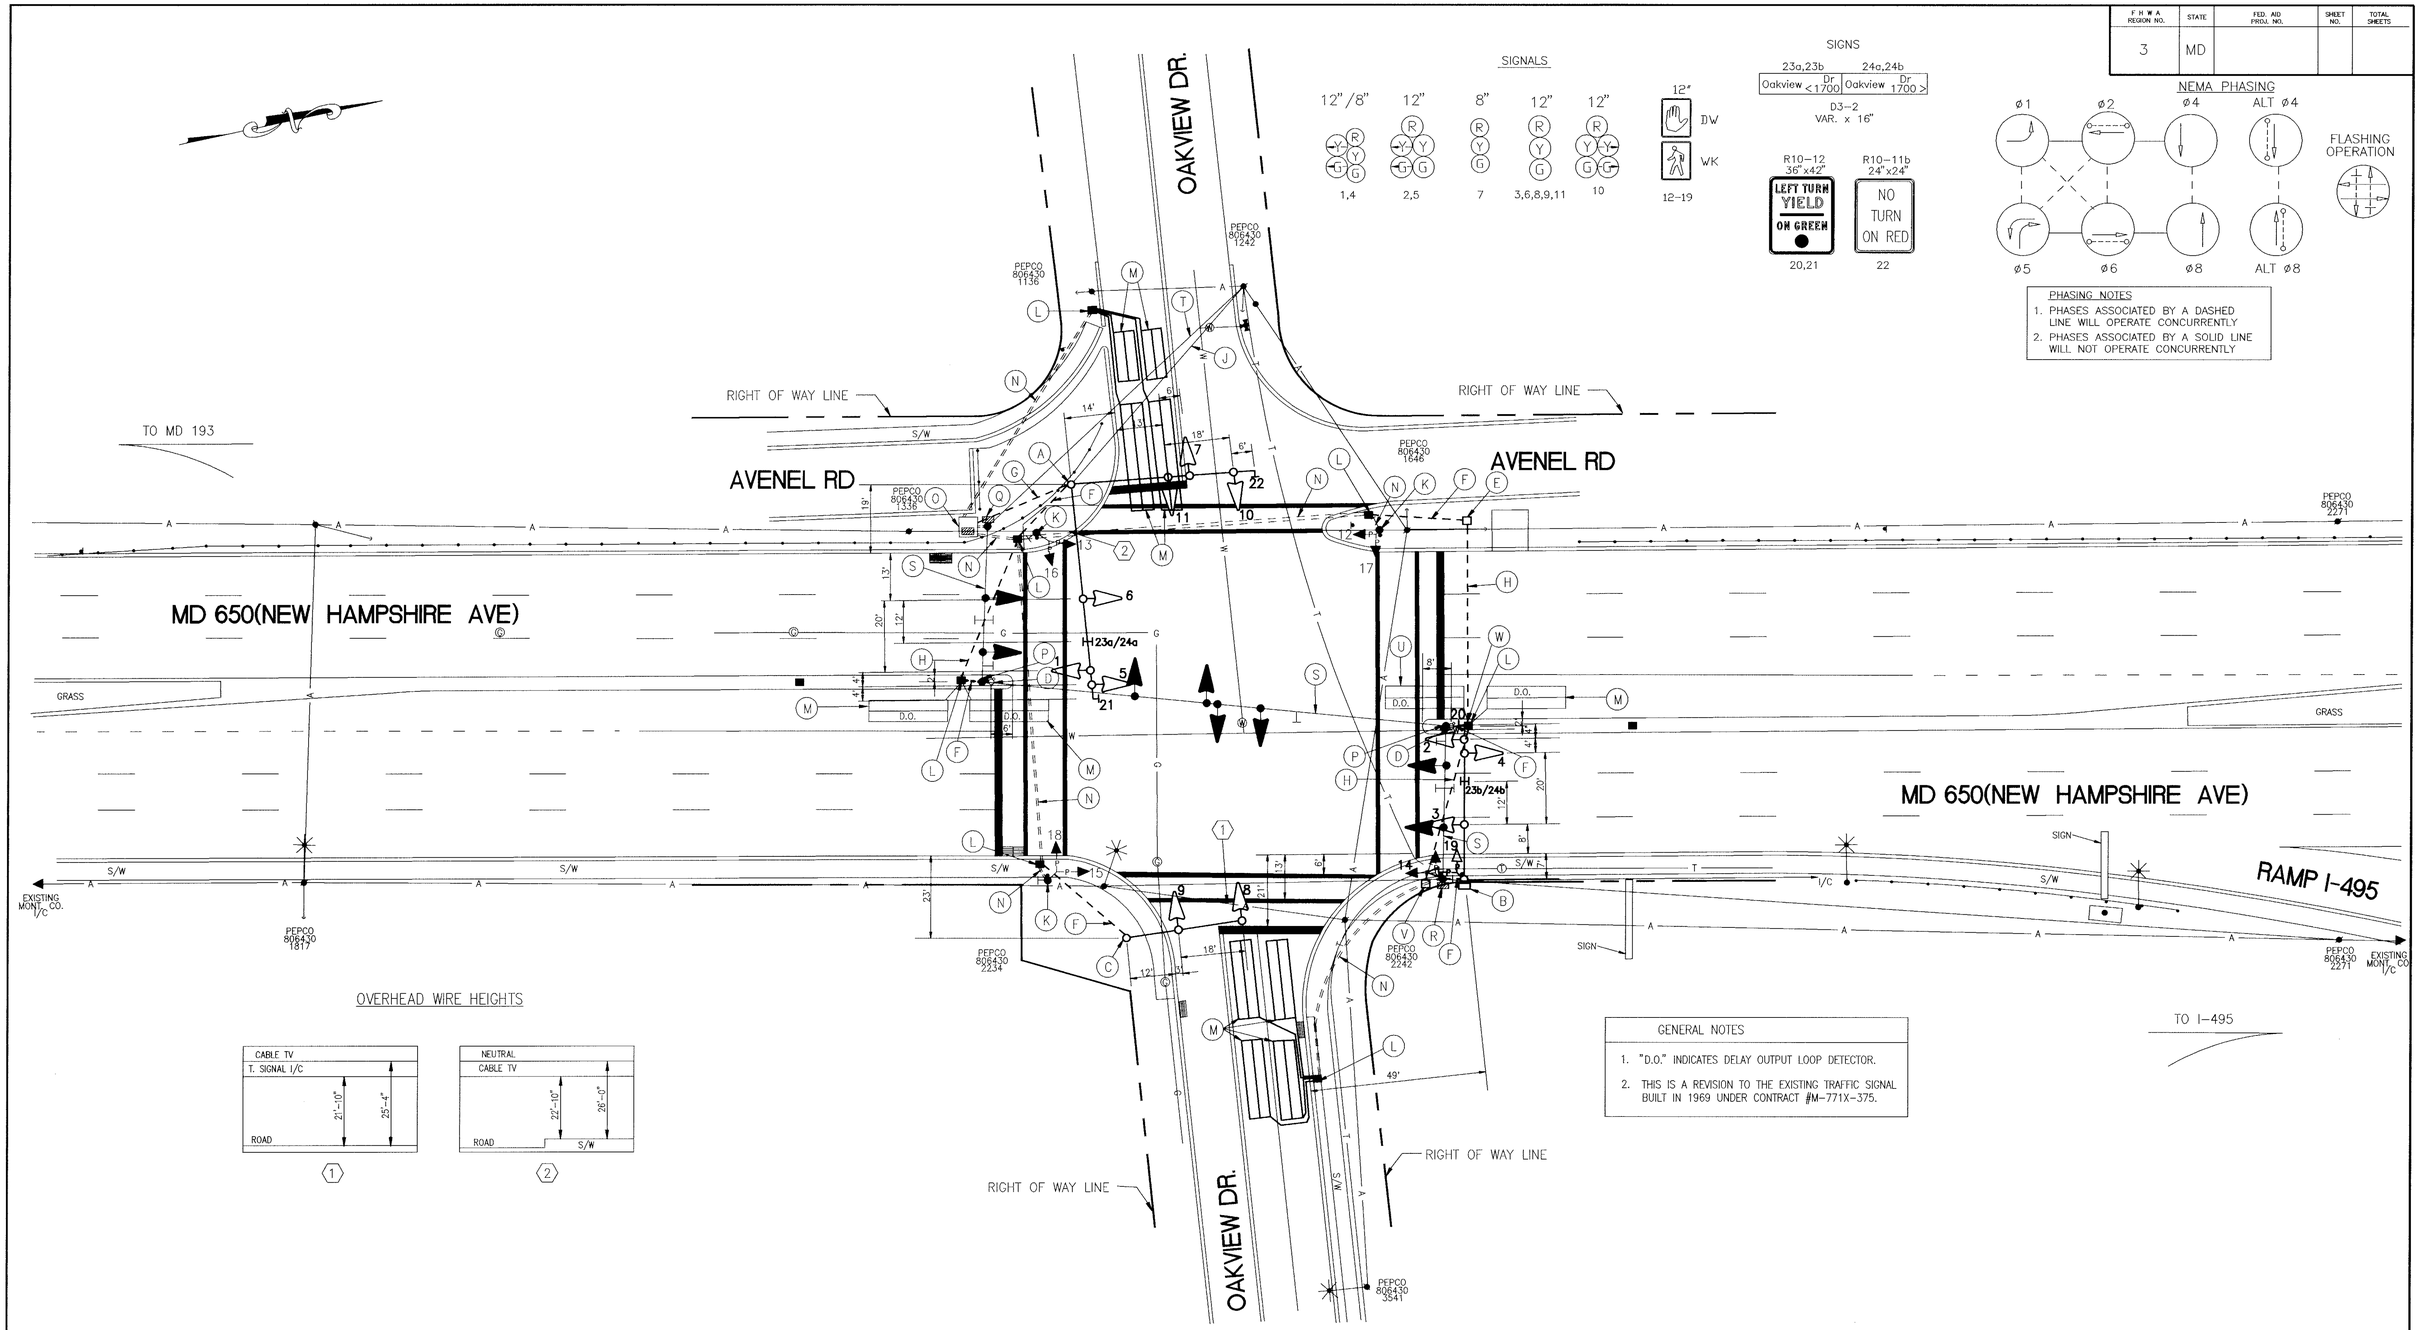

UTILITY LEGEND

T	TELEPHONE CABLES
G	GAS MAIN
W	WATER MAIN
S	SEWER MAIN
E	ELECTRIC CABLES
A	AERIAL CABLES
BC	BURIED CABLE
SD	STORM DRAIN

GEOMETRIC LEGEND

———	EXISTING GEOMETRICS
— — —	PROPOSED GEOMETRICS

CADFILE:MD650OAK.DWG
PLOT SCALE:1=20(L)

REVISIONS	APPROVALS
(D) 6-15-93 ASBUILT PEDESTRAIN SIGNAL EQUIPMENT, ADD NEW MAST ARMS POLES, AND SIGNALS.	CHIEF, SIGNAL DESIGN SECTION
J.R.G./DCI	ASST. DISTRICT ENGINEER, TRAFFIC
C 5-10-91 ASBUILT AND ADD PED PHASE	CHIEF, TRAFFIC ENGINEERING DESIGN DIVISION
S.H.A. No.	DEPUTY CHIEF ENGINEER, OFFICE OF TRAFFIC
RRZ	
B 7-23-83 ASBUILT	
JPT	
A 6-23-69 INSTALLED ADDITIONAL CABINET	
JS	

ORIGINAL ON FILE

DCL
CONSULTING ENGINEERS
COLUMBIA, MARYLAND

MDOT – STATE HIGHWAY ADMINISTRATION
Office of Traffic & Safety
TRAFFIC ENGINEERING DESIGN DIVISION

ORIGINAL DRAWN BY J. SPENCE/J. ALLEN Jr.
DES. BY R. GORDON
CHK. BY

MD 650 AND OAKVIEW DRIVE

LOG MILE: 1506500.61 COUNTY: MONTGOMERY

DATE: 5-13-69 F.A.P. NO.
SCALE: 1"=20' S.H.A. NO. M-771X-375

TS/FILE NO. TS-20D

SHEET NO. 1 OF 1