F.H.WA REGION NO	STATE	FED. AID PROJ. NO	SHEET NO.	TOTAL SHEETS
3	MD.			

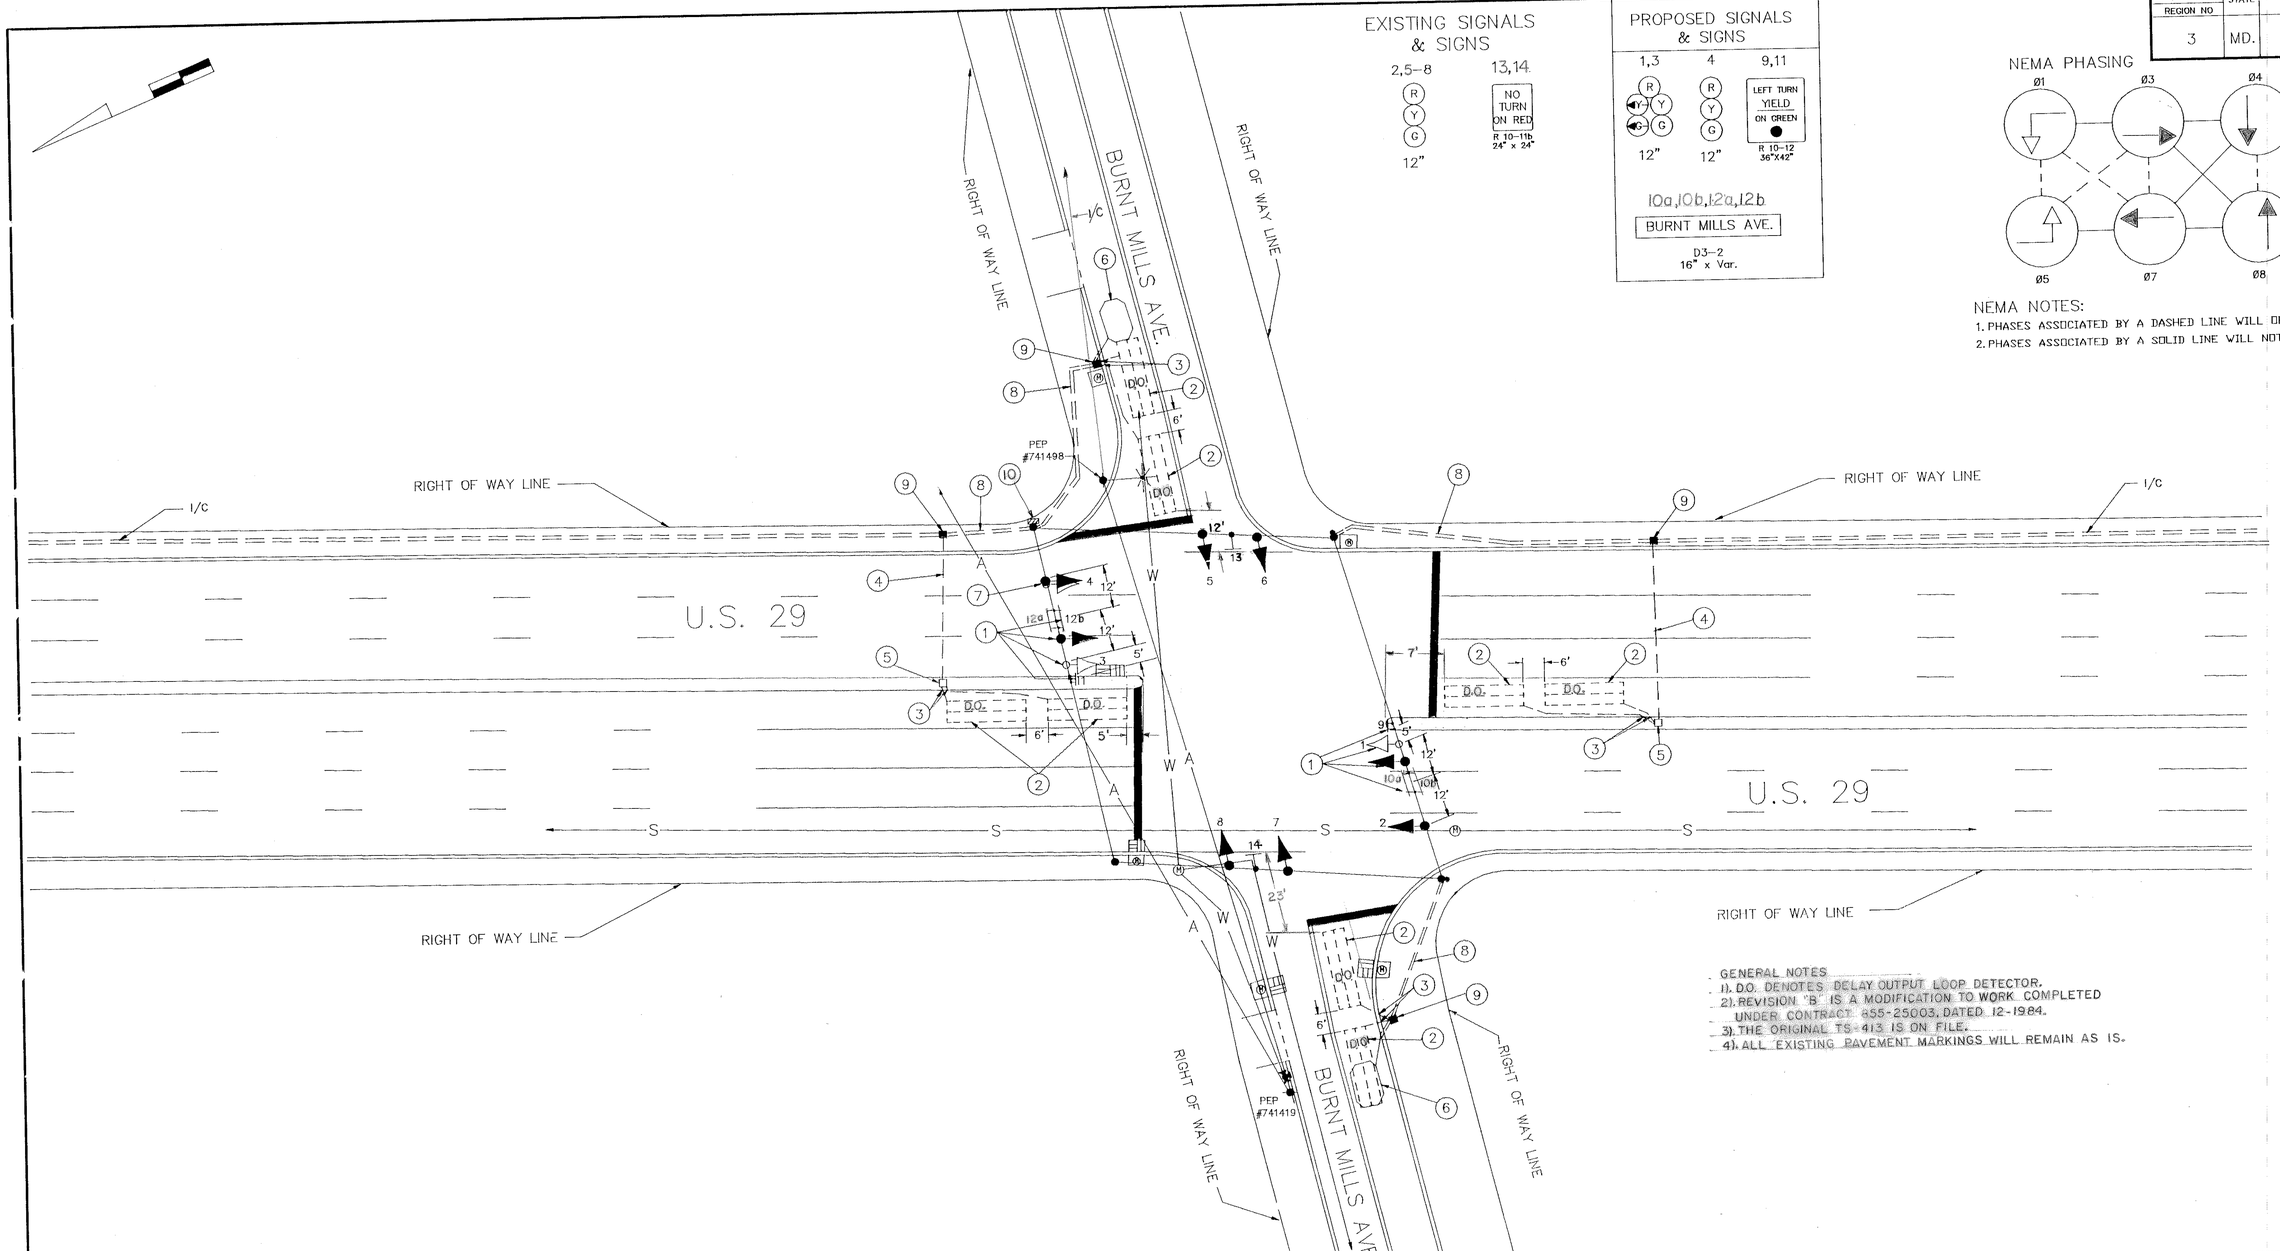

UTILITY LEGEND

G — G	GAS MAIN
W — W	WATER MAIN
S — S	SEWER MAIN
E — E	ELECTRIC CABLES
A — A	AERIAL CABLES
T — T	TELEPHONE CABLES

REVISIONS

Ⓑ. 03/90 – ADD E/P L.T.S
U.S. 29
S.H.A.#
WM
A. 03/90
AS BUILT
WM

APPROVALS

CHIEF, DESIGN SECTION
ASST. DISTRICT ENGINEER, TRAFFIC
CHIEF, TRAFFIC ENGINEERING DIVISION
DEPUTY CHIEF ENGINEER, OFFICE OF TRAFFIC

NOTE: THIS IS A REVISION TO 855-25003 DATED 12-1984 ORIGINAL PLAN ON FILE

MDOT – STATE HIGHWAY ADMINISTRATION
Office of Traffic
TRAFFIC ENGINEERING DIVISION

DRAWN BY: T. MANK
DES. BY: T. MANK
CHK. BY:

U.S. 29 & BURNT MILLS AVE.

COUNTY: MONTGOMERY

DATE: 12/1984
SCALE: 1" = 20'
F.A.P. NO.
S.H.A. NO. 855–25003

TS/STD. NO. TS–413 Ⓑ

SHEET NO. 1 OF 1

15002904.09