F.H.W.A. REGION NO.	STATE	FED. AID PROJ. NO.	SHEET NO.	TOTAL SHEETS
3	MD.			

ANNE ARUNDEL COUNTY POLICE

NEMA PHASING

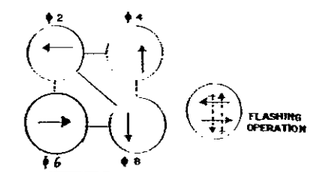

12" SIGNALS

1-6 R Y G

NEMA PHASING NOTES
1. PHASES ASSOCIATED BY A DASHED LINE WILL OPERATE CONCURRENTLY.
2. PHASES ASSOCIATED BY A SOLID LINE WILL NOT OPERATE CONCURRENTLY.

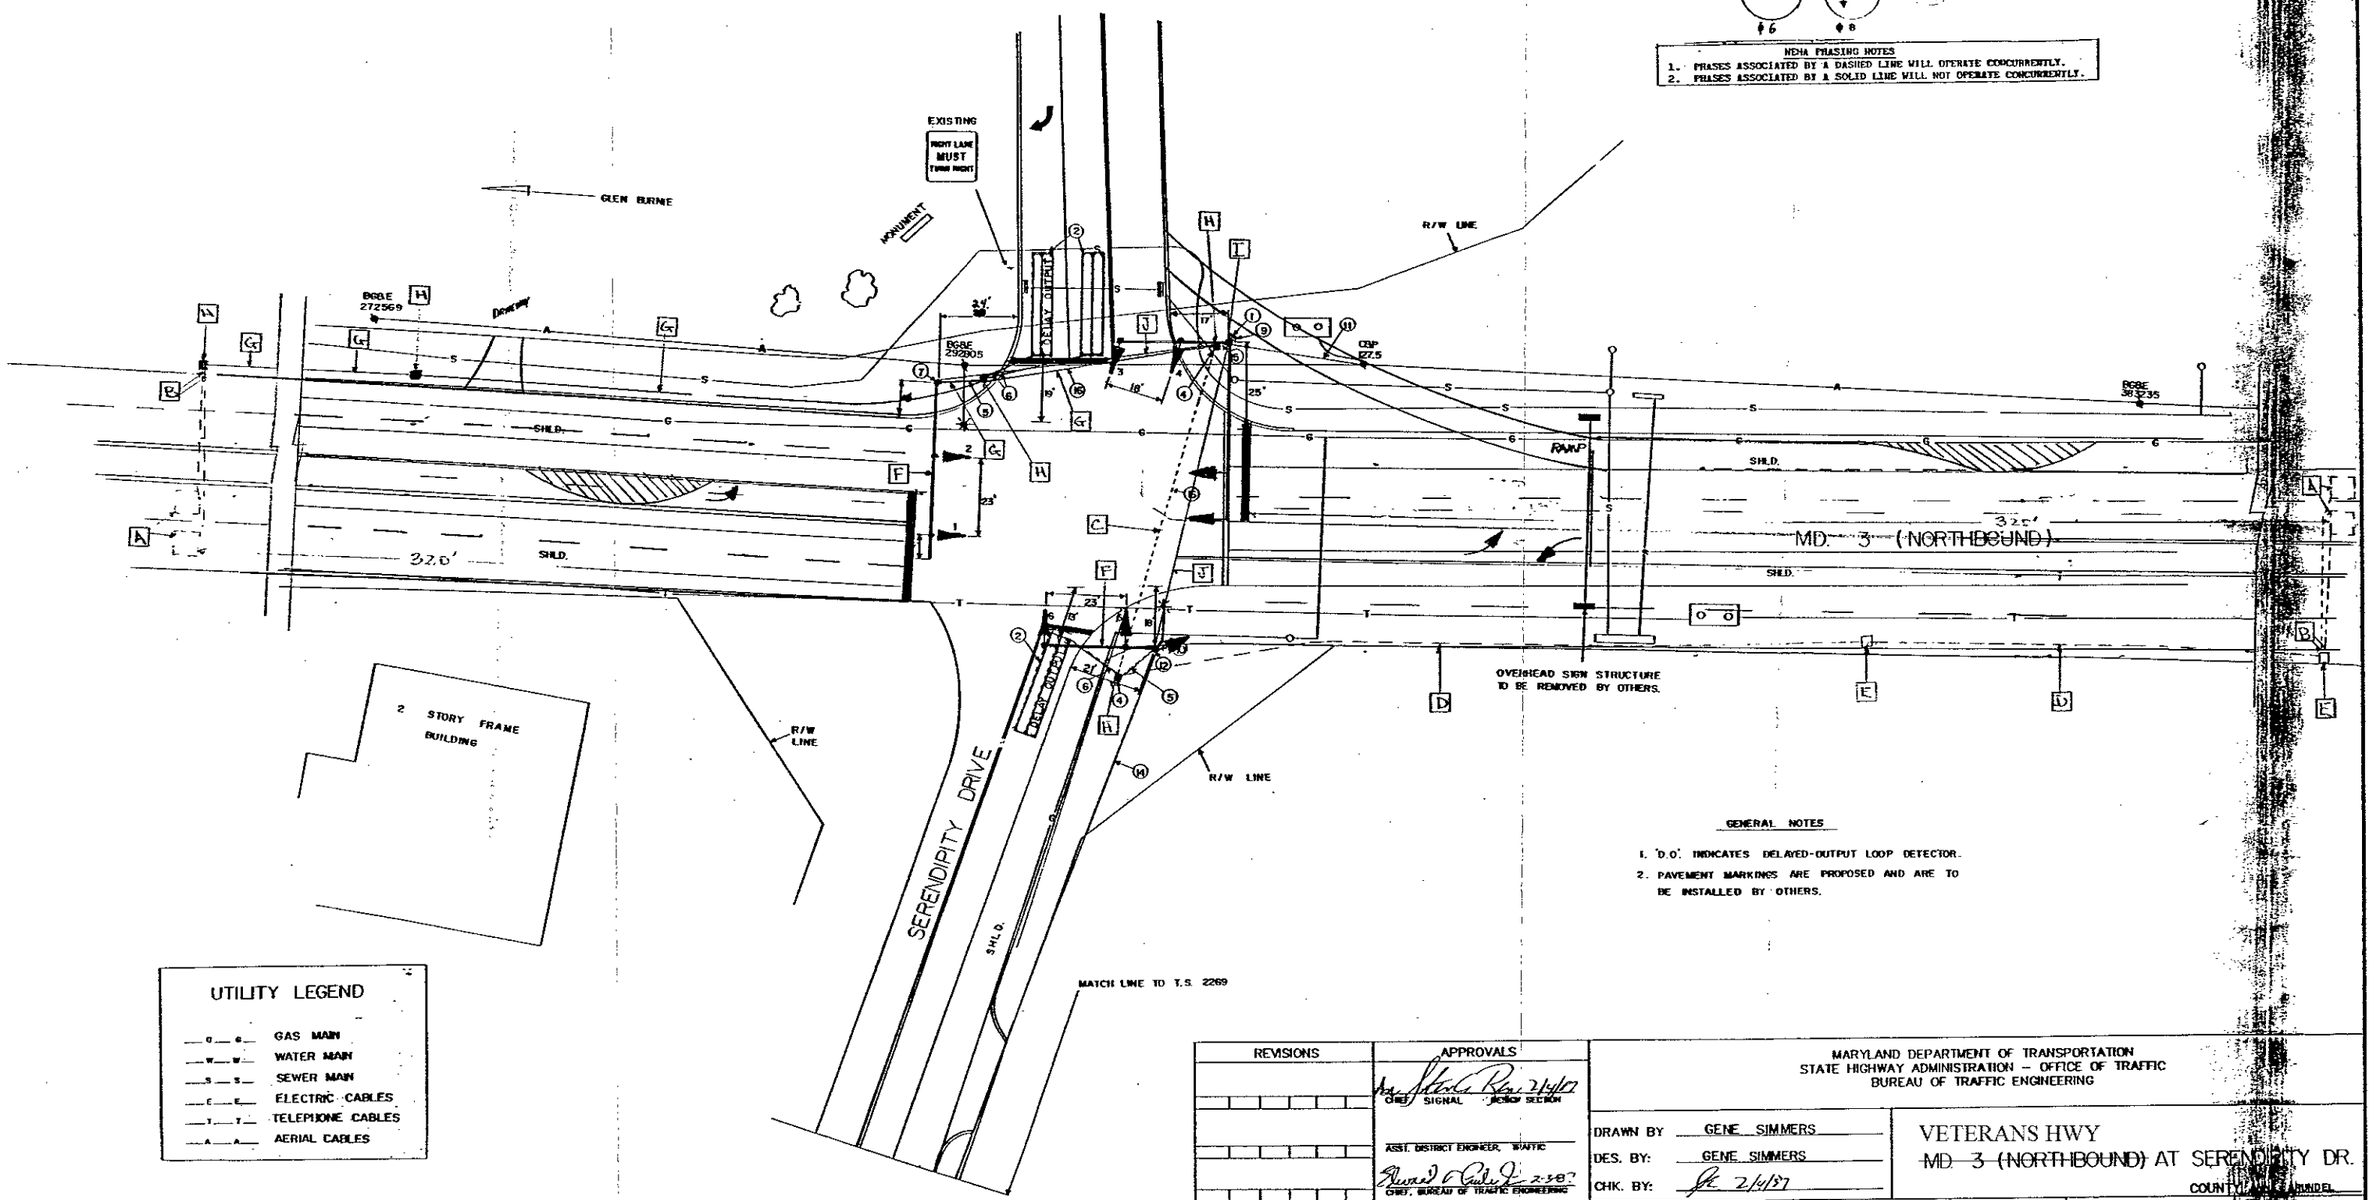

GENERAL NOTES

1. 'D.O.' INDICATES DELAYED-OUTPUT LOOP DETECTOR.
2. PAVEMENT MARKINGS ARE PROPOSED AND ARE TO BE INSTALLED BY OTHERS.

UTILITY LEGEND

—G—G—	GAS MAIN
—W—W—	WATER MAIN
—S—S—	SEWER MAIN
—E—E—	ELECTRIC CABLES
—T—T—	TELEPHONE CABLES
—A—A—	AERIAL CABLES

REVISIONS	APPROVALS
	CHIEF, SIGNAL DESIGN SECTION — 2/4/87
	ASSIST. DISTRICT ENGINEER, TRAFFIC
	CHIEF, BUREAU OF TRAFFIC ENGINEERING — 2-5-87
	DEPUTY CHIEF ENGINEER, OFFICE OF TRAFFIC

A INTERNAL MAINTENANCE 3-31-87 LEON GEISCZCZAK
SHA No.: AA-130-508-572 R.C.S.

MARYLAND DEPARTMENT OF TRANSPORTATION
STATE HIGHWAY ADMINISTRATION – OFFICE OF TRAFFIC
BUREAU OF TRAFFIC ENGINEERING

DRAWN BY: GENE SIMMERS
DES. BY: GENE SIMMERS
CHK. BY: 2/4/87
DATE: 1-15-87
SCALE: 1" = 20'
F.A.P. NO.
S.H.A. NO.

VETERANS HWY
~~MD 3 (NORTHBOUND)~~ AT SERENDIPITY DR.
COUNTY: ANNE ARUNDEL

TS/FILE NO. 2268 A
SHEET NO. 1 OF 1

02N00309