GENERAL NOTES

1. D.O. DENOTES DELAY OUTPUT LOOP DETECTOR
2. PAVEMENT MARKINGS ARE NOT TO BE INSTALLED UNTIL LOOP DETECTORS CONDUIT INSTALLATIONS ARE COMPLETE.
3. THE PAVEMENT MARKINGS DETAILED ARE PROPOSED AND SHALL BE INSTALLED BY THE CONTRACTOR IN ACCORDANCE WITH S.H.A. STANDARDS.
4. REVISION "D" IDS A REVISION TO THE TRAFFIC CONTROL SIGNAL BUILT IN 4/73 UNDER CONTRACT No. AA 810-2-576.
5. THE CONTRACTOR SHALL CONFIRM THE LOCATION OF PROPOSED GEOMETRICS PRIOR TO INSTALLING EQUIPMENT.

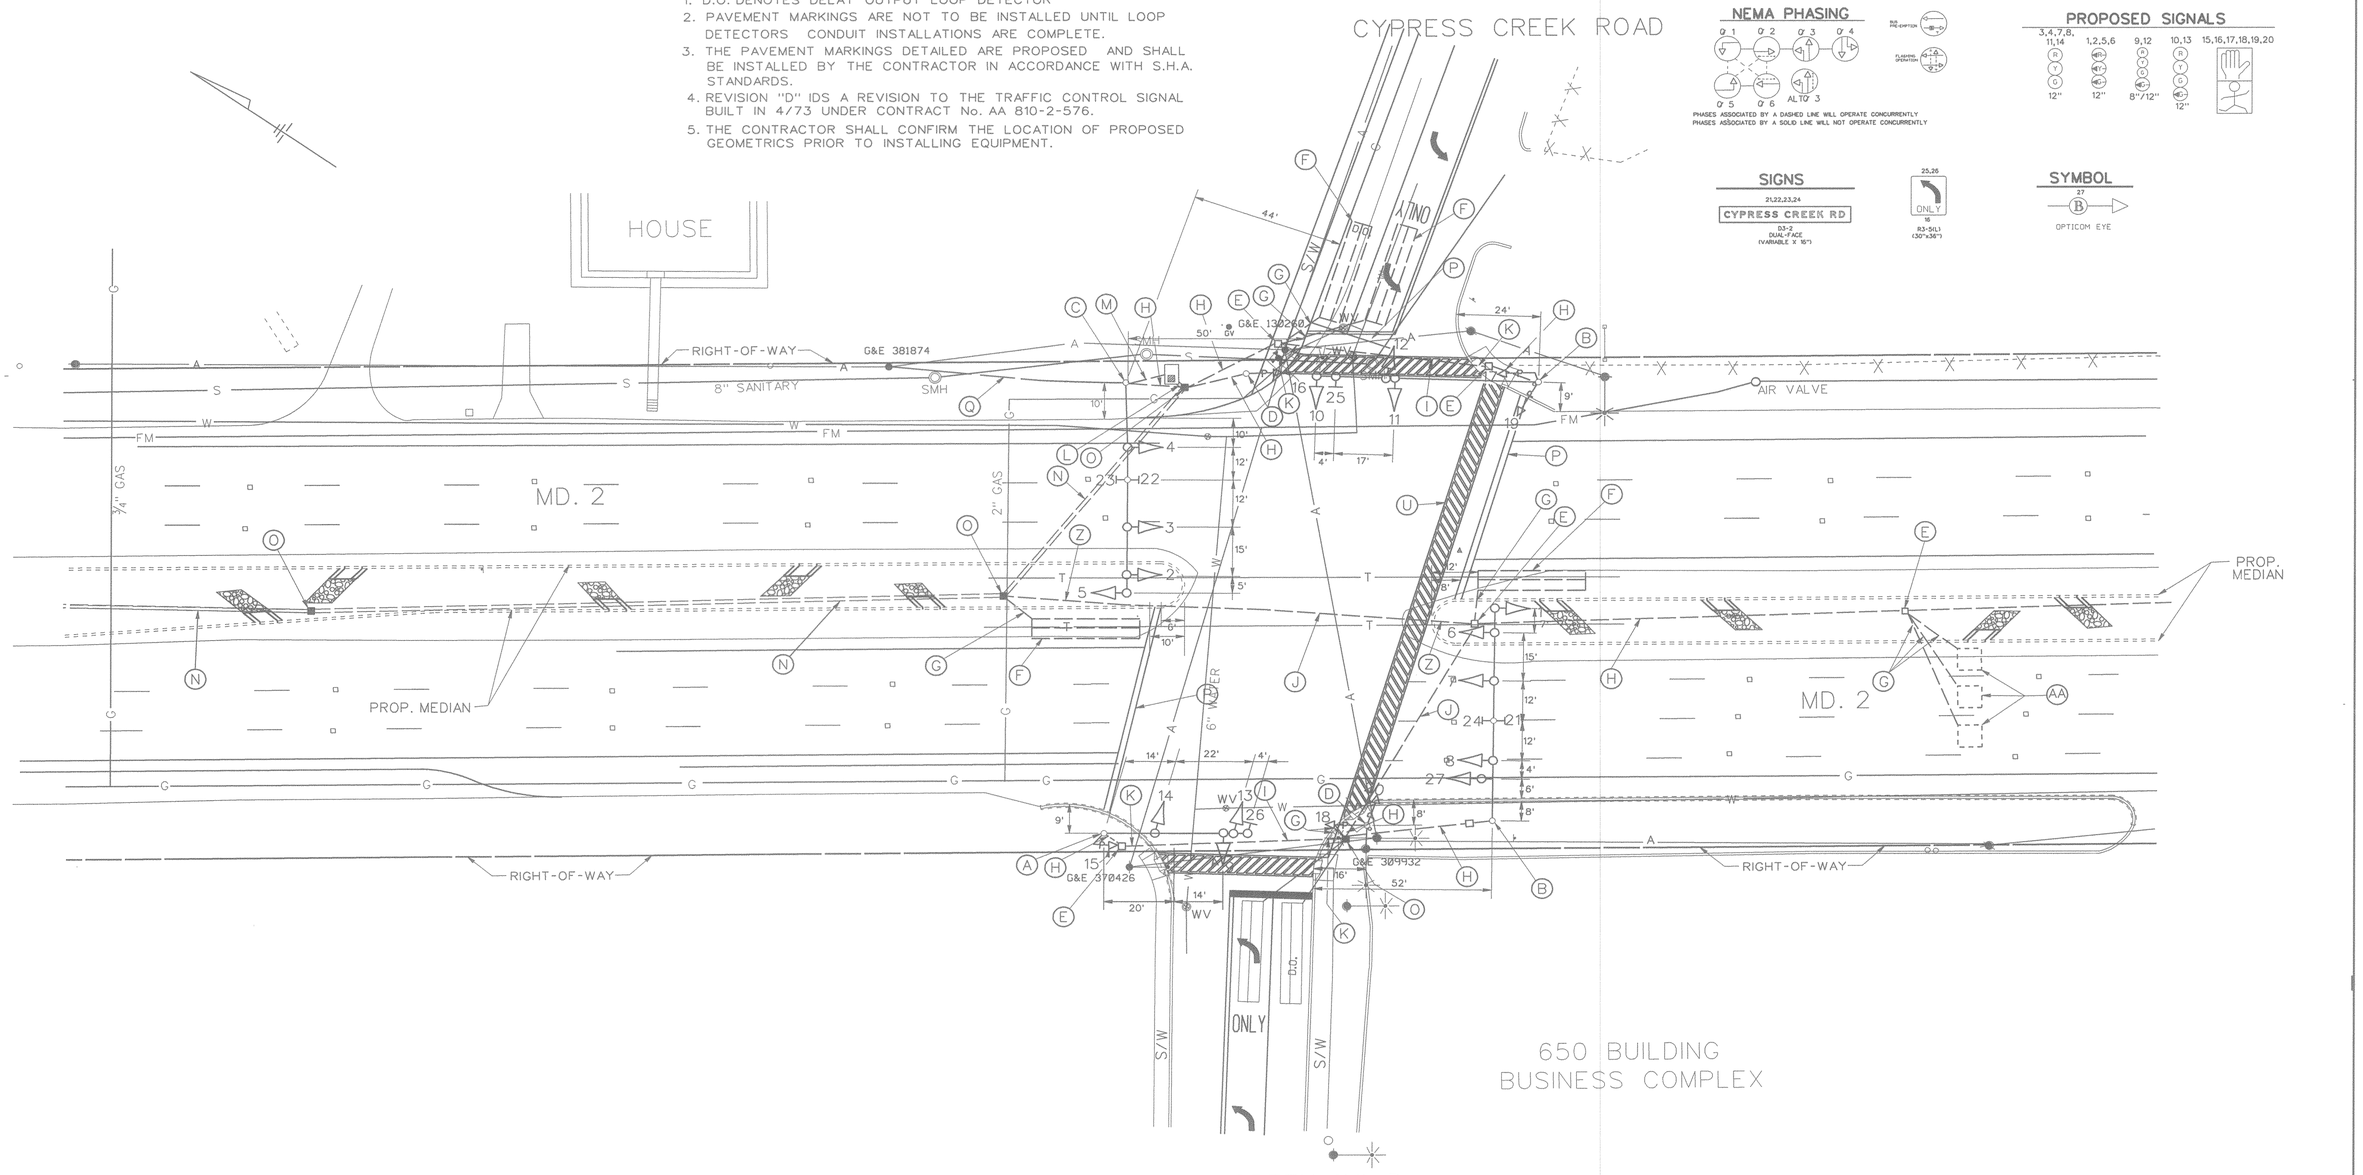

REDLINE REVISION No. 2
NEW SHEET

THIS SHEET REPLACES SHEET 80 PER
ADDENDUM No. 1 02/ /94

UTILITY LEGEND

G — G	GAS MAIN
W — W	WATER MAIN
S — S	SEWER MAIN
E — E	ELECTRIC CABLES
A — A	AERIAL CABLES
T — T	TELEPHONE CABLES

DANA P. KNIGHT P.E. 15553 DATE

KCI TECHNOLOGIES
KCI TECHNOLOGIES INC.
ENGINEERS AND PLANNERS
10 NORTH PARK DRIVE
HUNT VALLEY, MARYLAND
21030-1886
(410) 316-7800

REVISION

D	12-93 REDESIGN FROM SPAN WIRE TO MAST ARM DESIGN DUE TO MD. 2 WIDENING SHA No. AA 305-501-576	MM	
C	5-21-74 AS BUILT	HJK	
B	5-9-73 REVISED SIGNAL DISPLAY DUE TO RECENT GEOMETRIC CHANGES	JS	JS
A	4-16-73 ADJUSTED SIGNAL DESIGN DUE TO UNDERGROUND UTILITY & REVISED GEOMETRICS	JS	JS AB TH

APPROVALS

ORIGINAL ON FILE

CHIEF, SIGNAL DESIGN SECTION
ASST. DISTRICT ENGINEER, TRAFFIC
CHIEF, TRAFFIC ENGINEERING DESIGN DIVISON
DIRECTOR, OFFICE OF TRAFFIC & SAFETY

MDOT - STATE HIGHWAY ADMINISTRATION
OFFICE OF TRAFFIC & SAFETY
TRAFFIC ENGINEERING DESIGN DIVISION

DRAWN BY: F. DEBELIUS
DES. BY: W. RICHARDSON
CHK. BY: W. FITCH

MD. 2 AND CYPRESS CREEK ROAD

SIGNAL NO. 02000228.93 ~~02042~~ COUNTY: ANNE ARUNDEL

DATE: 4-5-73 F.A.P. NO. T-8005(2) TS/STD. NO. TS-309D
SCALE: 1" = 20' S.H.A. NO. AA 810-2-576 SHEET NO. 80A OF 106