K&E BALTIMORE 17 0153 PHOENIX 10-75 MC 4156+

F.H.W.A. REGION NO.	STATE	FED. AID PROJ. NO.	SHEET NO.	TOTAL SHEETS
3	MD.		2	6

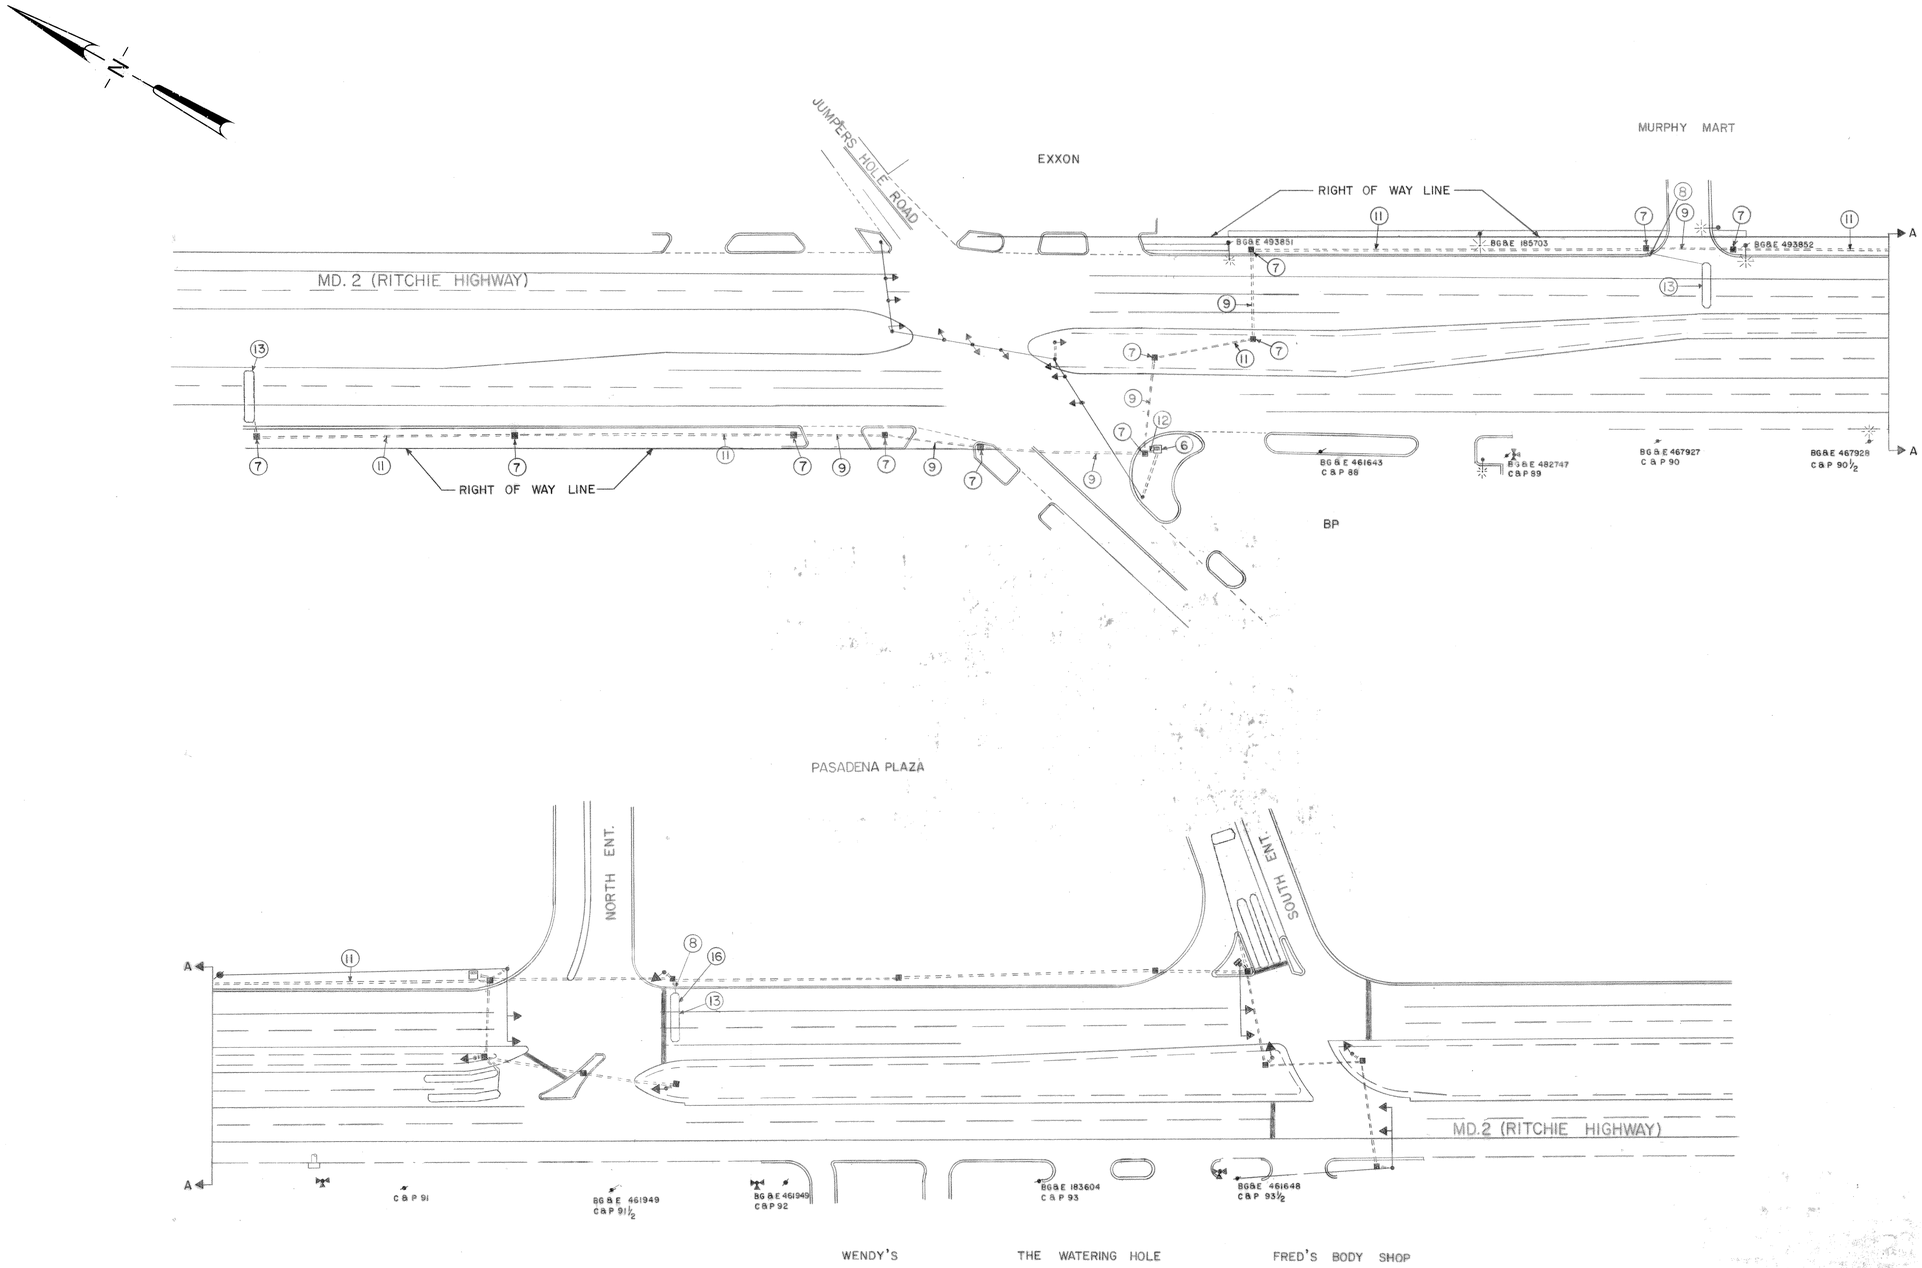

APPROVAL: REGIONAL TRAFFIC ENGINEER 5/5/80

APPROVAL: CHIEF-BUREAU OF TRAFFIC ENGINEERING 5/5/80

APPROVAL: ASS'T. CHIEF ENGINEER TRAFFIC 4/17/80

A 1-30-81 ASBUILT BW-476-801-512

TMZ

REVISIONS

STATE OF MARYLAND
DEPARTMENT OF TRANSPORTATION
STATE HIGHWAY ADMINISTRATION

TRAFFIC DIVISION – BUREAU OF TRAFFIC ENGINEERING

INTERCONNECT DRAWING FOR

MD 2 FROM JUMPERS HOLE RD. TO PASADENA PLAZA

SCALE 1" = 50' DATE 9-4-79 CONTRACT NO. BW-476-801-512

DRAWN BY: W. GUCKERT COUNTY: ANNE ARUNDEL

DESIGNED BY: JWG SIGNAL NO.:

CHECKED BY: 4-24-80

DRAWING NO. TS-1757A

STREET TRAFFIC STUDIES, LTD.
16628 S. Westland Drive
Gaithersburg, Maryland 20760