F.H.W.A. REGION NO.	STATE	FED. AID PROJ. NO.	SHEET NO.	TOTAL SHEETS
3	MD.			

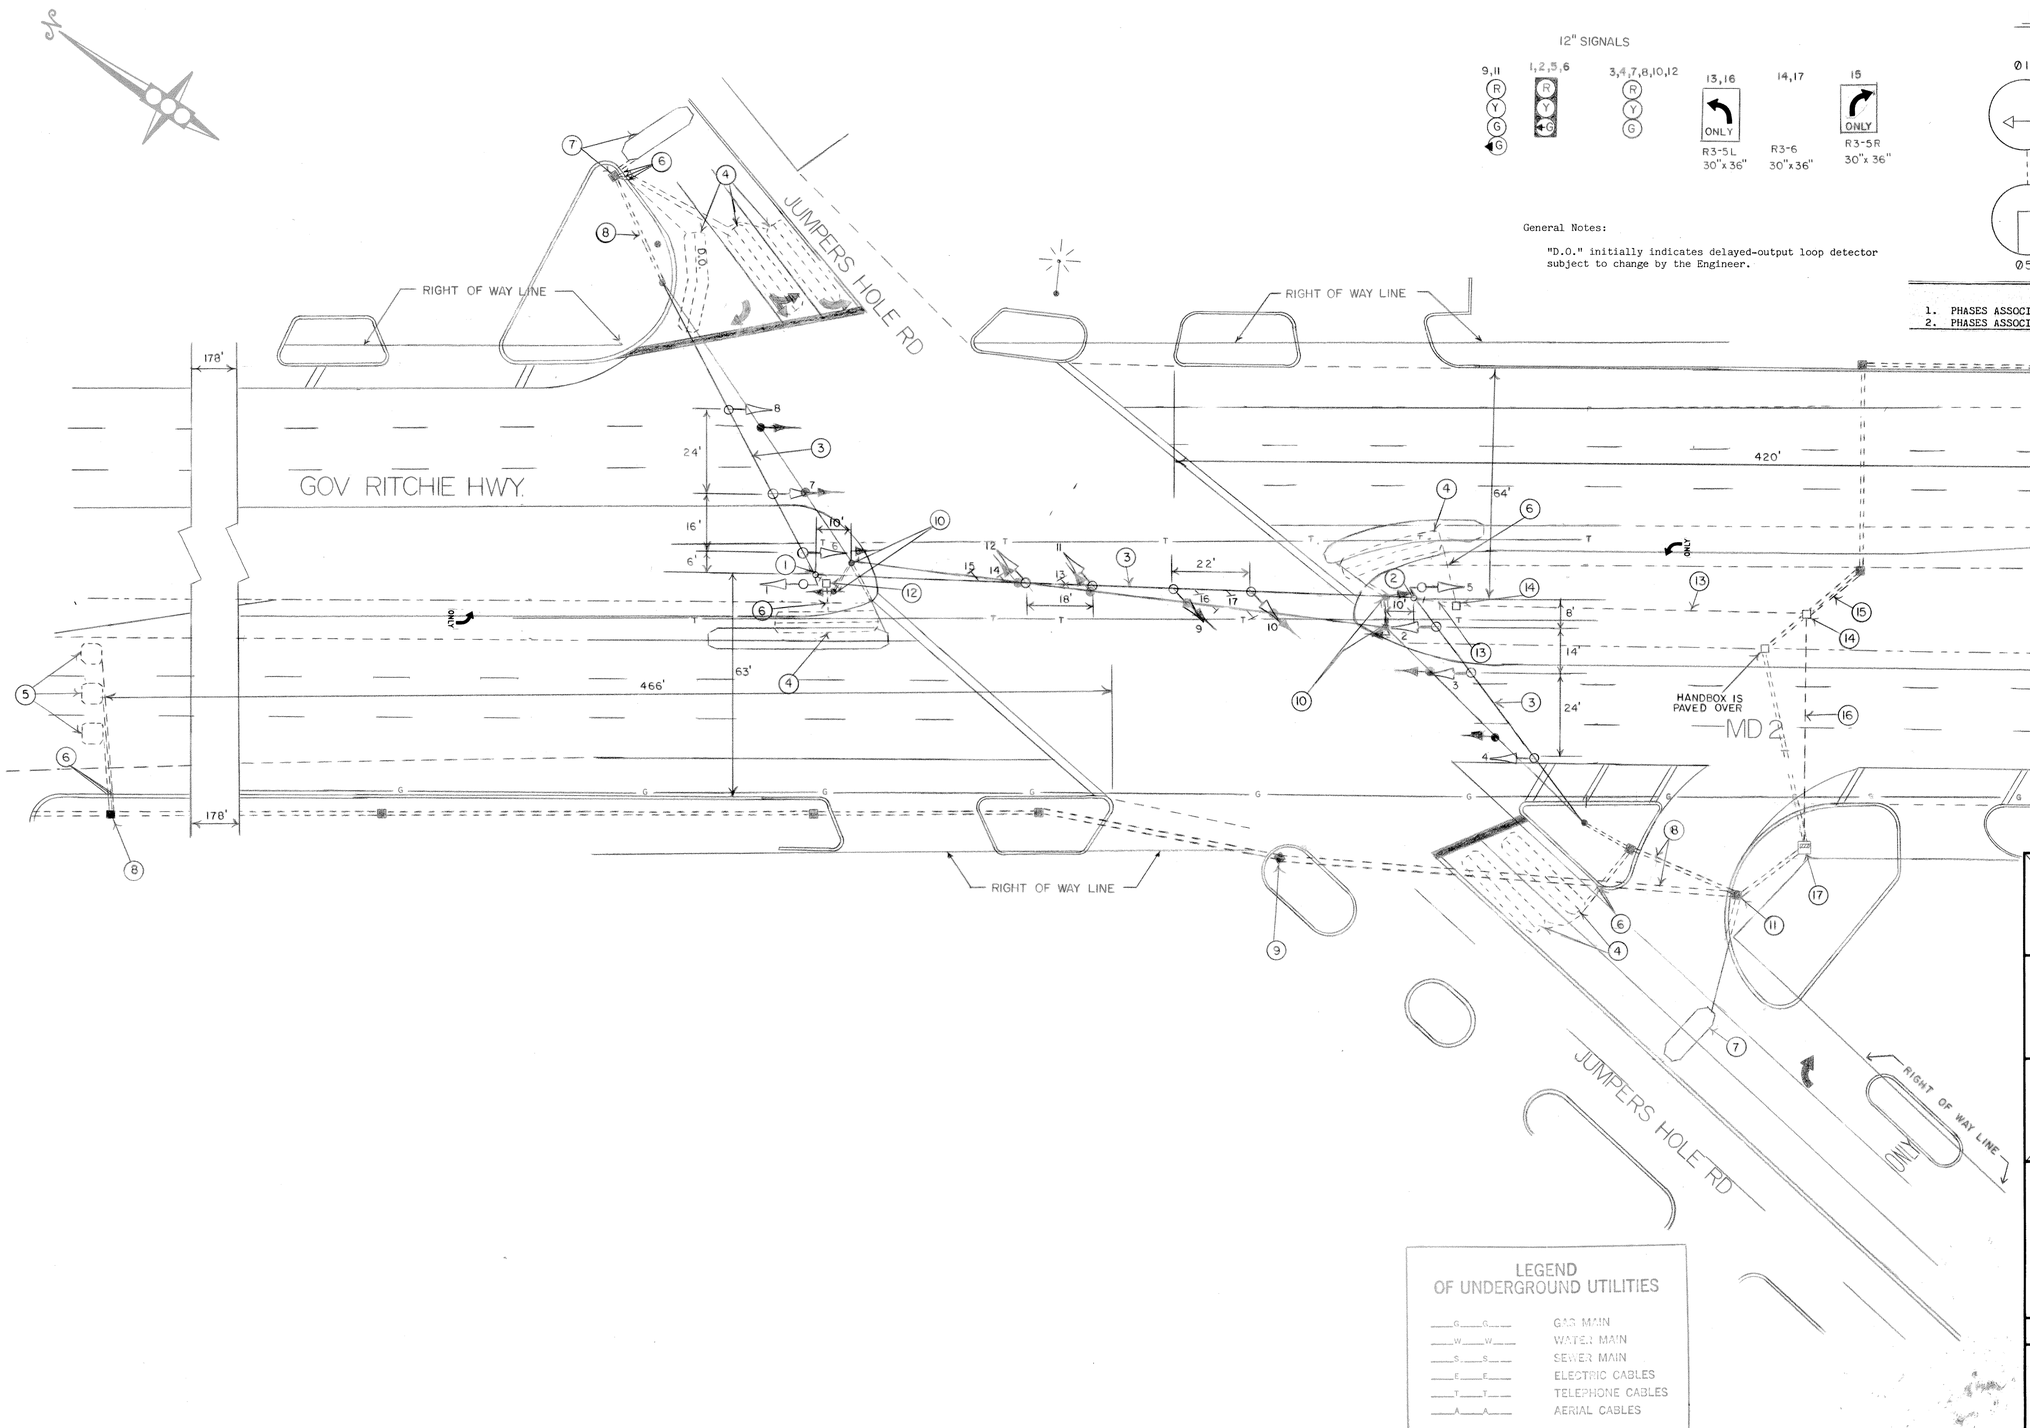

APPROVAL: REGIONAL TRAFFIC ENGINEER

APPROVAL: CHIEF BUREAU OF TRAFFIC ENGINEERING

APPROVAL: ASS'T. CHIEF ENGINEER TRAFFIC

6	2-7-86 RELOCATE POLES & ADD LOOP DETECTORS
	SHA NO 855-25005
JJD	
F	6-2-83 ASBUILT
E	5-23-74 REDRAWN & ASBUILT

REVISIONS

STATE OF MARYLAND
DEPARTMENT OF TRANSPORTATION
STATE HIGHWAY ADMINISTRATION

TRAFFIC DIVISION – BUREAU OF TRAFFIC ENGINEERING

MD 2 & JUMPERS HOLE RD

SCALE 1" = 20' DATE 4-4-73 CONTRACT NO. AA-810-2-576 T-8005(2)

DRAWN BY: F DEBELIUS COUNTY: ANNE ARUNDEL

DESIGNED BY: SIGNAL NO.: 02045

CHECKED BY:

DRAWING NO. TS-155G

BRUNING 44-511 19927